


G.P.S. / GEODETIC SURVEY MONUMENT RECORD

SECTION 15, T 17 N, R 5 W, CITY/TOWN/VILLAGE BURNS

La Crosse COUNTY

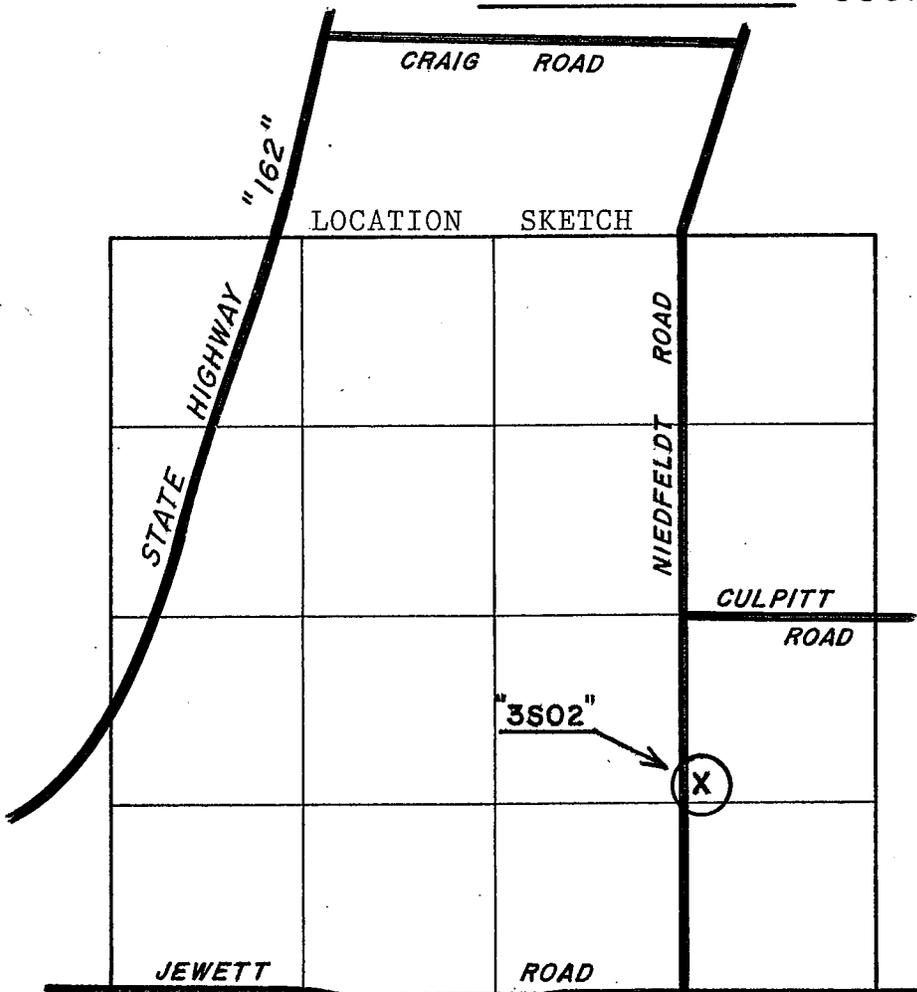

HORIZONTAL DATUM	
NAD 83(91):	
(Y)	710,842.021
(X)	1,716,731.514
NAD 27 _____:	
(Y)	_____
(X)	_____
OTHER: _____	
(Y)	_____
(X)	_____
VERTICAL DATUM	
ELEV. _____,	_____
ELEV. <u>816.2</u> ,	<u>1929</u>
ELEV. _____,	<u>1988</u>

SECTION 15-17-5.

Lat: 43°56'46.83279" N, (0.002m)
 Lon: 90°57'21.43785" W, (0.002m)
 Ell. Hgt in m: (216.192m), (0.003m)

GPS / GEODETIC STATION DESCRIPTION

~~D.O.T. PROJECT I.D.:~~ LaCrosse Co. computer I.D.: 3S02

STATION NAME: 3S02 STATION NO. _____

LATITUDE: 43°56'46.83279" N LONGITUDE: 90°57'21.43785" W

LOCAL NAME: 3S02

MONUMENT BY AGENCY: D.O.T. DATE: 2005 TYPE: 15" Concrete Marker w/Brass Cap

SET BY: D.O.T.

MAINTENANCE RECORD: 8/13/07 OK weg

MAINTENANCE RECORD: _____

MAINTENANCE RECORD: _____


MAINTENANCE RECORD: _____

MAINTENANCE RECORD: _____

The monument is located in the east-central part of La Crosse County. More easily found beginning at the intersection of State Highways "16" and "162" to the north, the intersection being northwest of the Village of Bangor. Then northerly along Hwy "162" approx. 2.55 mi. (4.10 km) to the intersection with County Road "E". Then south along "E" 0.16 mi. (0.26 km) to the intersection with Jewett Road. Then east along Jewett Road 1 mi. (1.61 km) to the intersection with Niedfeldt Road. Then north along Niedfeldt Road 0.25 mi. (0.40 km) to the 15" concrete marker with brass cap near the east R/W line.

RECORD OF DURABLE WITNESS MONUMENTS

DETAIL SKETCH

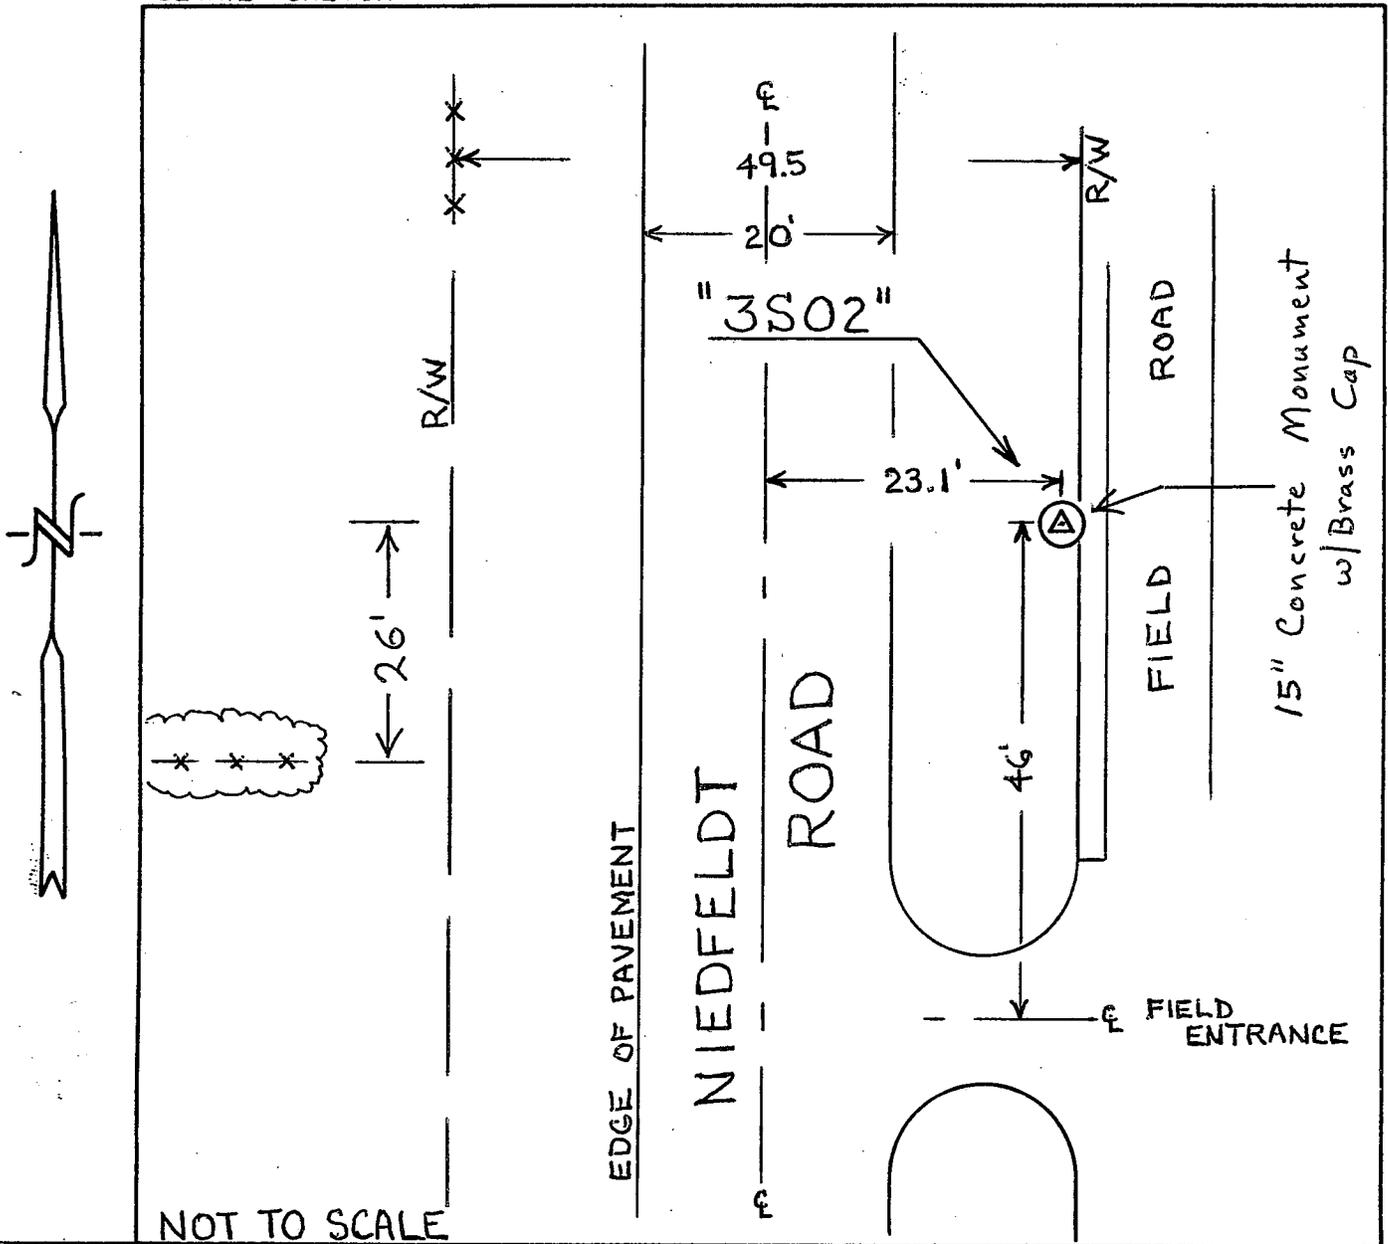

NOT TO SCALE

NO.	DESCRIPTION	BEARING	DISTANCE

REMARKS: _____

I, William C. Jung, County Surveyor
 HEREBY CERTIFY THAT THE MONUMENT LOCATION SHOWN
 ON THIS RECORD WAS DETERMINED UNDER MY DIRECTION
 AND CONTROL AND THAT THIS GPS/GEODETIC RECORD IS
 CORRECT AND COMPLETE TO THE BEST OF MY KNOWLEDGE
 AND BELIEF.

William C. Jung
 SIGNATURE

6/30/05
 DATE

