


G.P.S. / GEODETIC SURVEY MONUMENT RECORD

SECTION 1, T 16 N, R 5 W, CITY/TOWN/VILLAGE BANGOR

LA CROSSE COUNTY

Lat: 43°53'05.970494 N, (.00444m)
 Lon: 90°54'36.937566 W, (.00407m)
 Ell. Hgt in m: (208.5288m), (.00724m)

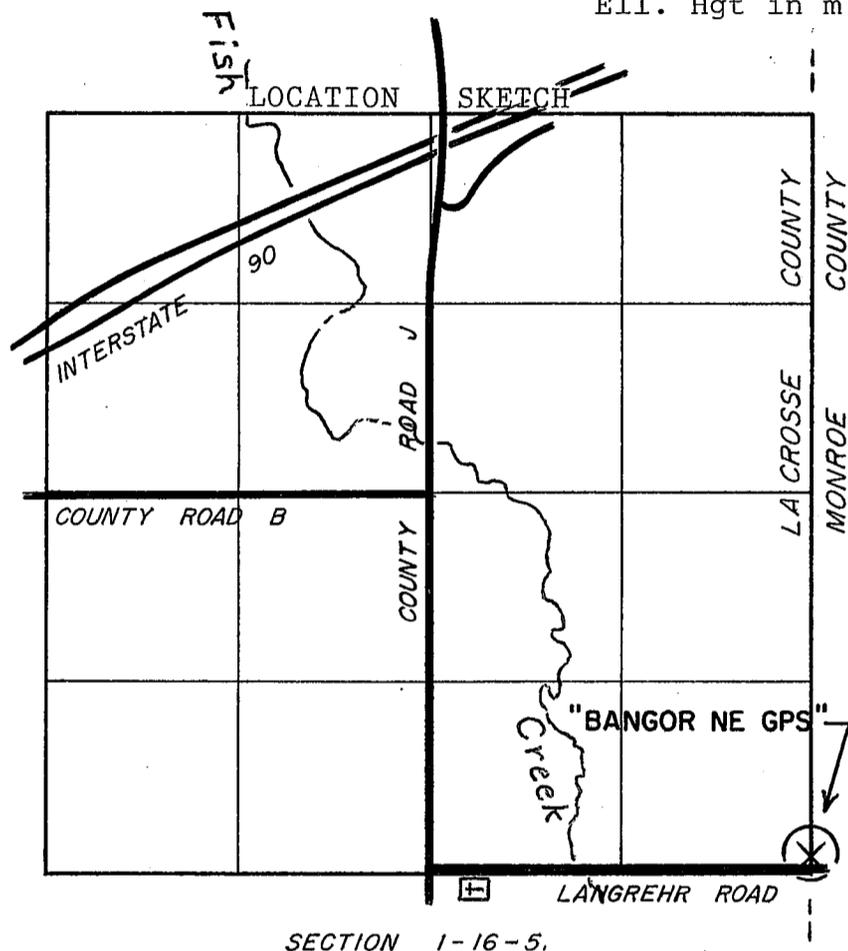

HORIZONTAL DATUM	
NAD 83(91):	
(Y)	688,344.818
(X)	1,728,521.405
NAD 27:	
(Y)	_____
(X)	_____
OTHER:	
(Y)	_____
(X)	_____
VERTICAL DATUM	
ELEV.	_____
ELEV.	791.43 * 1929
ELEV.	_____ 1988

*Derived from level circuit from U.S.G.S. marker.

GPS / GEODETIC STATION DESCRIPTION

~~D.O.T. PROJECT I.D.:~~ LaCrosse Co. computer I.D.: BANE

STATION NAME: "BANGOR NE GPS" STATION NO. _____

LATITUDE: _____ LONGITUDE: _____

LOCAL NAME: _____

MONUMENT BY AGENCY: County Surveyor DATE: 10/12/93 TYPE: Brass cap in conc.


SET BY: William C. Jung - (County Surveyor) & Peter F. Follansbee

MAINTENANCE RECORD:	<u>10/17/95</u>	<u>OK</u>	<u>asej</u>	<u>10/25/07</u>	<u>OK</u>	<u>asej</u>
MAINTENANCE RECORD:	<u>5/20/03</u>	<u>OK</u>	<u>asej</u>	<u>9/17/08</u>	<u>OK</u>	<u>asej</u>
MAINTENANCE RECORD:	<u>11/23/04</u>	<u>OK</u>	<u>asej</u>			
MAINTENANCE RECORD:	<u>7/26/05</u>	<u>OK</u>	<u>asej</u>			
MAINTENANCE RECORD:	<u>9/19/06</u>	<u>OK</u>	<u>asej</u>			

The station is located on the East-County Line south of the Village of Rockland. More easily found beginning at the intersection of County Road B & County Road J located approximately one-half mile (0.8km) south of Interstate 90 passing south of the Village of Rockland. Then south 0.5mi (0.8km) along Co. Rd. J to the intersection with Langrehr Road. Then east 0.5mi (0.8km) along Langrehr Rd. to the 15" x 5' concrete marker with brass cap 28.72 Ft. (8.75m) north of the centerline.

RECORD OF DURABLE WITNESS MONUMENTS

DETAIL SKETCH

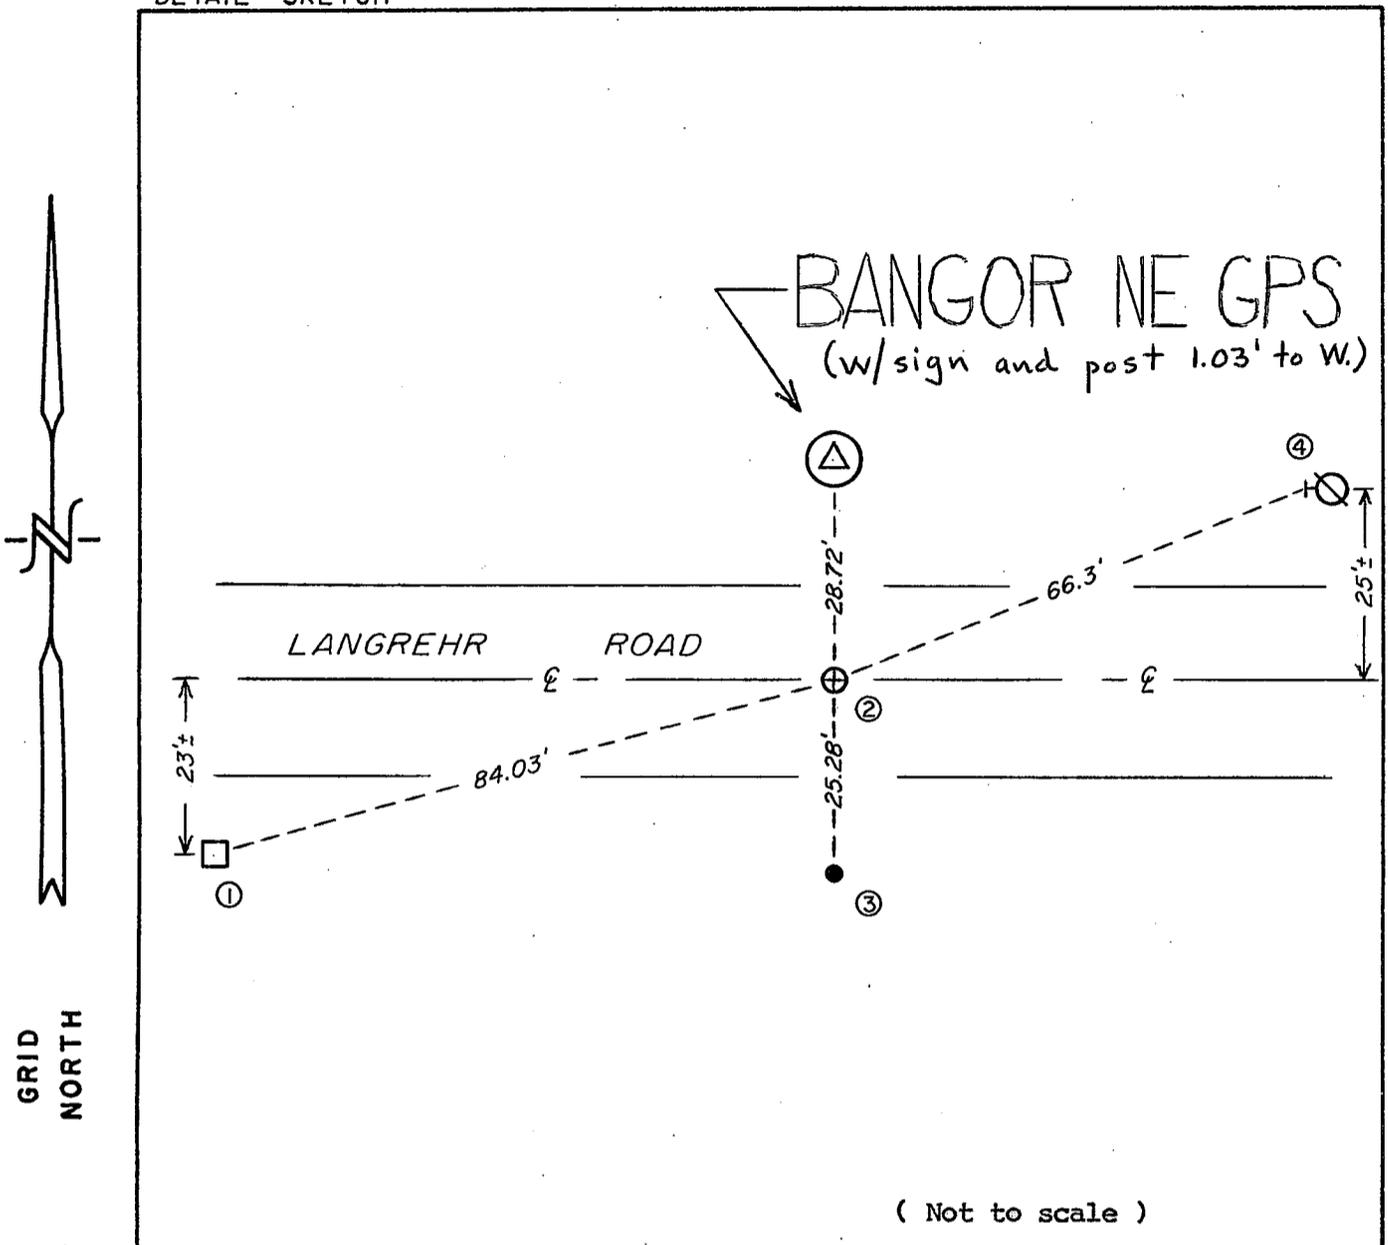

NO.	DESCRIPTION	BEARING	DISTANCE
1	Center of top of telephone box	Southwesterly±	84.03 Ft.
2	Existing Harrison marker @ SE-Cor., Sec. 1-16-5.	South±	28.72 Ft.
3	Existing 3/4" Iron Bar	South±	54.00 Ft.
4	Existing Nail & Cap in Powerpole	East±	

REMARKS: GPS marker replaces an ex. I.B.

I, William C. Jung, County Surveyor
 HEREBY CERTIFY THAT THE MONUMENT LOCATION SHOWN
 ON THIS RECORD WAS DETERMINED UNDER MY DIRECTION
 AND CONTROL AND THAT THIS GPS/GEODETIC RECORD IS
 CORRECT AND COMPLETE TO THE BEST OF MY KNOWLEDGE
 AND BELIEF.

William C. Jung
 SIGNATURE

3/29/00
 DATE

