


G.P.S. / GEODETIC SURVEY MONUMENT RECORD

SECTION 23, T 16 N, R 6 W, CITY/TOWN/VILLAGE BARRE

LACROSSE COUNTY

Lat: 43°50'47.122025 N, (.00000m)
 Lon: 91°03'40.006877 W, (.00000m)
 Ell. Hgt in m: (208.1388m), (.00000m)

LOCATION SKETCH

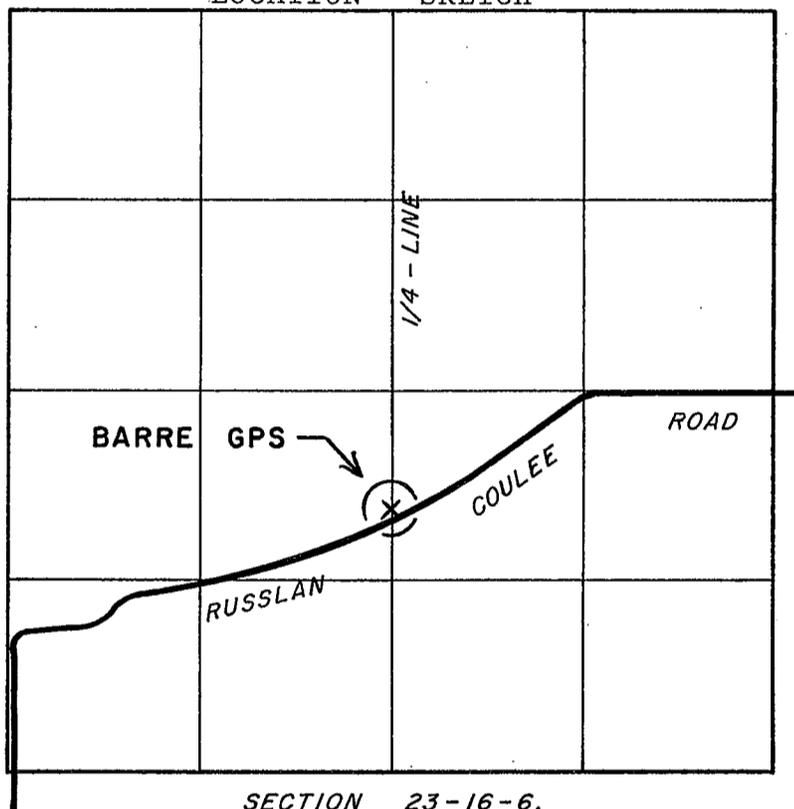

HORIZONTAL DATUM	
NAD 83(91):	
(Y)	<u>674,756.902</u>
(X)	<u>1,688,574.132</u>
NAD 27 :	
(Y)	_____
(X)	_____
OTHER: _____	
(Y)	_____
(X)	_____
VERTICAL DATUM	
ELEV.	_____, _____
ELEV.	<u>788.7 ±</u> , <u>1929</u>
ELEV.	_____, <u>1988</u>

GPS / GEODETIC STATION DESCRIPTION

~~D.O.T. PROJECT I.D.:~~ LaCrosse Co. computer I.D.: BARR

STATION NAME: BARRE GPS STATION NO. 166W23S

LATITUDE: _____ LONGITUDE: _____

LOCAL NAME: Russlan Coulee

MONUMENT BY AGENCY: County Surveyor DATE: 10/07/93 TYPE: Brass cap in conc.

SET BY: William C. Jung & peter F. Follansbee

MAINTENANCE RECORD: 10/15/96 OK weg

MAINTENANCE RECORD: 8/3/00 OK

MAINTENANCE RECORD: 12/9/04 OK weg


MAINTENANCE RECORD: 8/11/08 OK weg

MAINTENANCE RECORD: _____

The station is located east of the unincorporated area known as " Barre Mills " in the Town of Barre. More easily found beginning at the intersection of County Road O & County Road M on the east side of the area known as Barre Mills. Then easterly along County Road M 1.82mi. (2.93km) to the intersection with Russlan Coulee Rd. Then northerly along Russlan Coulee Rd. 1.23mi. (1.98km) to the 15" x 5' concrete marker with brass cap located 97 Ft. (29.6m) north of centerline on the east side of the N-S 1/4-line fence.

RECORD OF DURABLE WITNESS MONUMENTS

DETAIL SKETCH

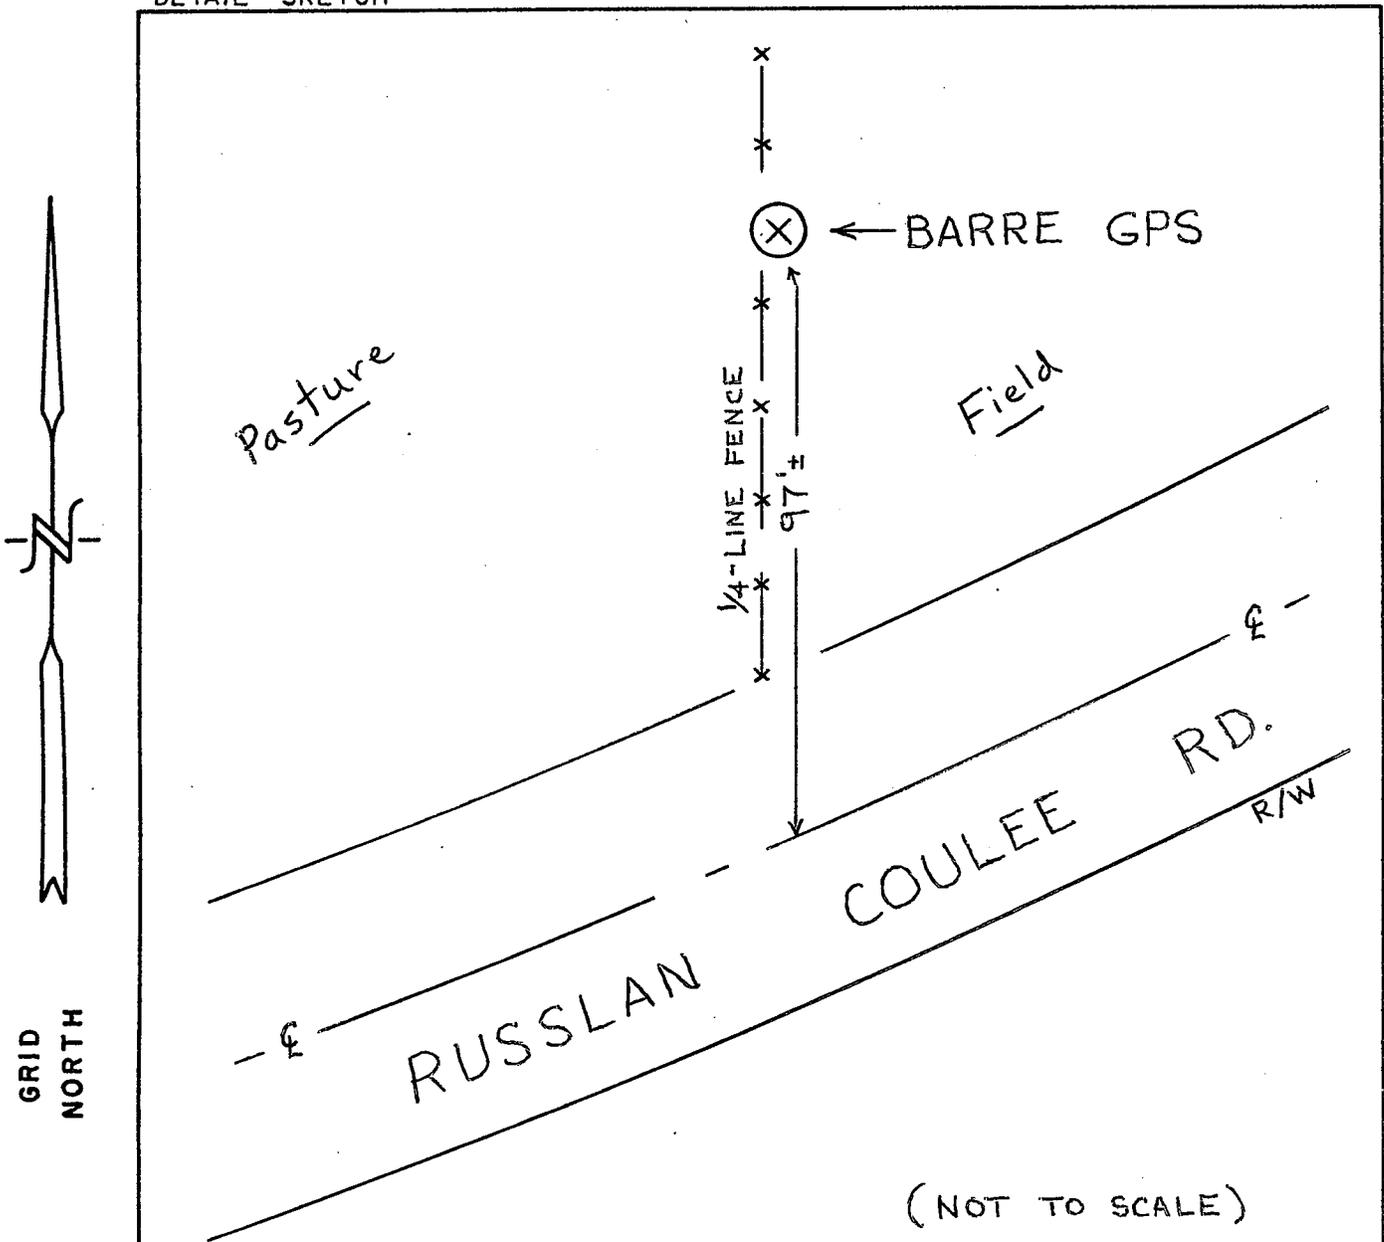

NO.	DESCRIPTION	BEARING	DISTANCE

REMARKS: Jay Clements gave us permission to build the marker here.

I, William C. Jung, County Surveyor
 HEREBY CERTIFY THAT THE MONUMENT LOCATION SHOWN
 ON THIS RECORD WAS DETERMINED UNDER MY DIRECTION
 AND CONTROL AND THAT THIS GPS/GEODETIC RECORD IS
 CORRECT AND COMPLETE TO THE BEST OF MY KNOWLEDGE
 AND BELIEF

William C. Jung
 SIGNATURE

3/28/00
 DATE

