


G.P.S. / GEODETIC SURVEY MONUMENT RECORD

SECTION 27, T 15 N, R 5 W, CITY/TOWN/VILLAGE WASHINGTON

LA CROSSE COUNTY

Lat: 43°44'44.867267 N, (.00293m)
 Lon: 90°57'52.263107 W, (.00364m)
 Ell. Hgt in m: (220.6149m), (.00610m)

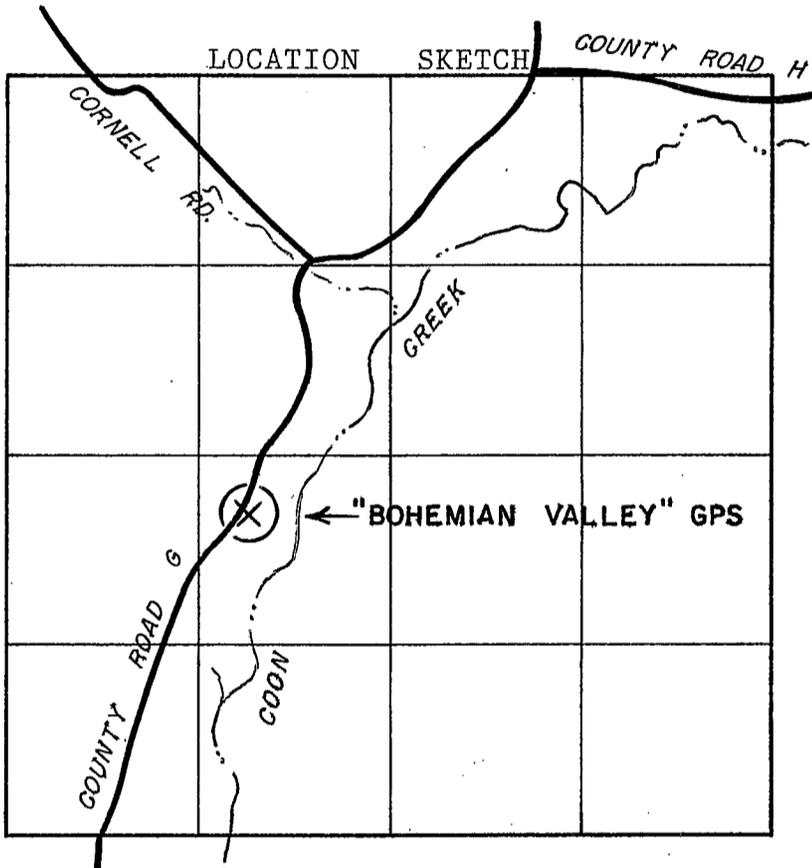

HORIZONTAL DATUM	
NAD 83(91):	
(Y)	637,770.369
(X)	1,713,630.966
NAD 27:	
(Y)	_____
(X)	_____
OTHER: _____	
(Y)	_____
(X)	_____
VERTICAL DATUM	
ELEV.	_____
ELEV.	830.6±, 1929
ELEV.	_____, 1988

GPS / GEODETIC STATION DESCRIPTION

D.O.T. PROJECT I.D.: LaCrosse Co. computer I.D.: BOHE

STATION NAME: "BOHEMIAN VALLEY" GPS STATION NO. _____

LATITUDE: _____ LONGITUDE: _____

LOCAL NAME: _____

MONUMENT BY AGENCY: County Surveyor DATE: 10/24/94 TYPE: Brass cap in concr.

SET BY: William C. Jung-(County Surveyor) & Peter F. Follansbee.

MAINTENANCE RECORD: 7/20/95 OK w/cj

MAINTENANCE RECORD: 11/9/00 OK w/cj (some chipping from mower)

MAINTENANCE RECORD: 1/9/01 OK w/cj " " " "


MAINTENANCE RECORD: 7/23/01 OK w/cj (set yellow guard post w/sign)

MAINTENANCE RECORD: 4/22/04 OK w/cj 9/1/05 w/cj

The station is located in the southeastern part of LaCrosse County. More easily found beginning at the east side of the Village of Coon Valley in Vernon County at the intersection of U.S. Highway 14-61 & County Highway G. Then northeasterly along County Hwy. G approximately 4.5mi. (7.2km) to the 12" x 4 1/4" concrete marker with brass cap on the east side of the roadway.

RECORD OF DURABLE WITNESS MONUMENTS

DETAIL SKETCH

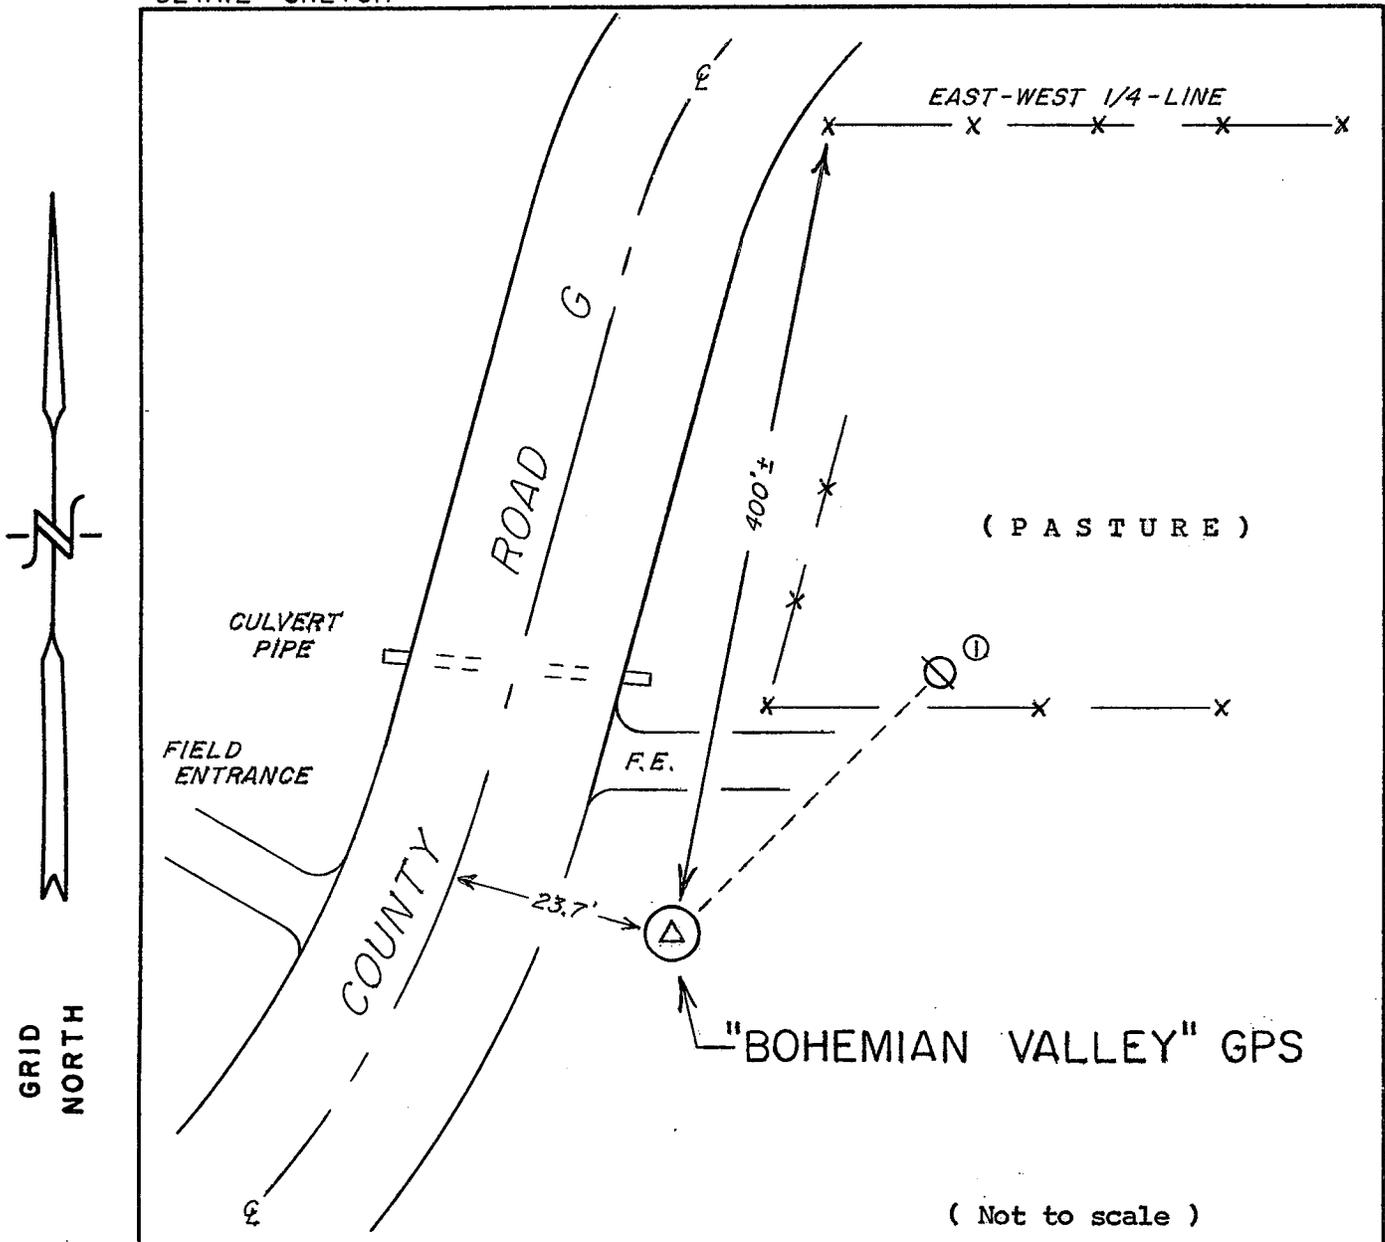

NO.	DESCRIPTION	BEARING	DISTANCE
1	Center of Power Pole	Northeasterly ±	60.8 Ft.

REMARKS: _____

I, William C. Jung, County Surveyor
 HEREBY CERTIFY THAT THE MONUMENT LOCATION SHOWN
 ON THIS RECORD WAS DETERMINED UNDER MY DIRECTION
 AND CONTROL AND THAT THIS GPS/GEODETIC RECORD IS
 CORRECT AND COMPLETE TO THE BEST OF MY KNOWLEDGE
 AND BELIEF.

William C. Jung
 SIGNATURE

3/30/00
 DATE

