


G.P.S. / GEODETIC SURVEY MONUMENT RECORD

SECTION 21, T 17 N, R 5 W, CITY/TOWN/VILLAGE BURNS

LA CROSSE COUNTY

Lat: 43°55'54.470791 N, (.00251m)
 Lon: 90°59'25.125198 W, (.00270m)
 Ell. Hgt in m: (198.4121m), (.00449m)

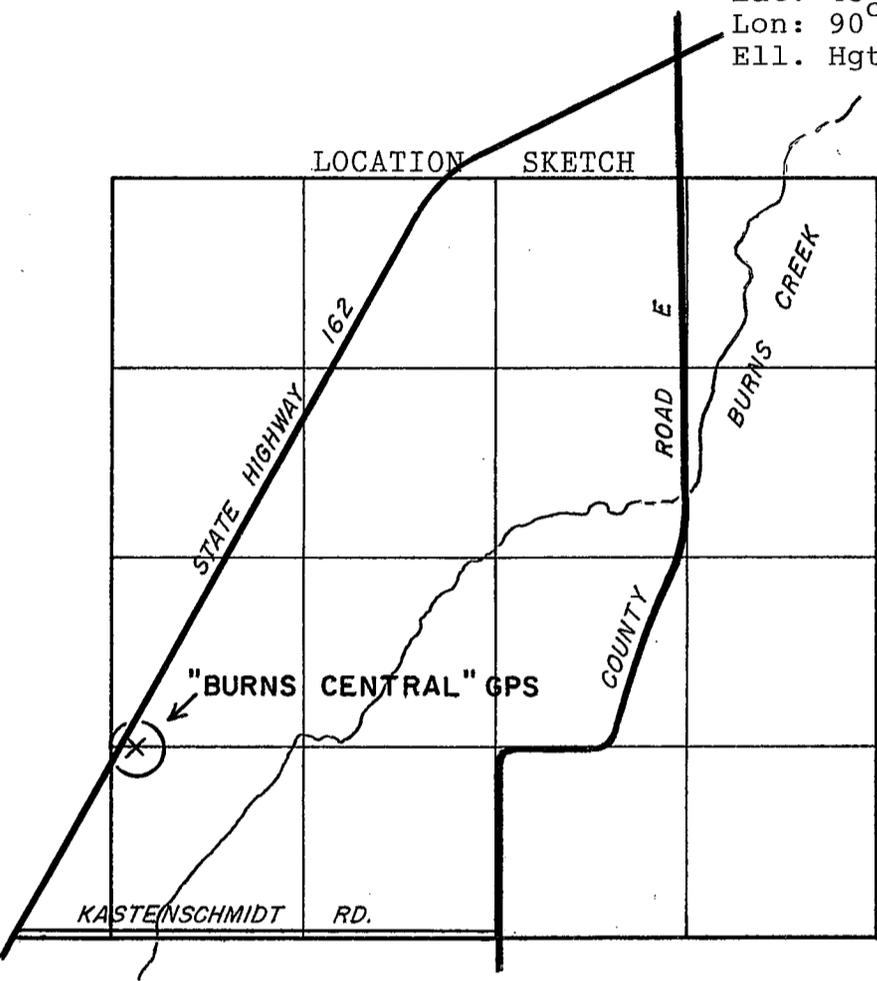

HORIZONTAL DATUM	
NAD 83(91):	
(Y)	705,645.930
(X)	1,707,620.255
NAD 27 :	
(Y)	_____
(X)	_____
OTHER: _____	
(Y)	_____
(X)	_____
VERTICAL DATUM	
ELEV. _____,	_____
ELEV. <u>757.5±</u> ,	<u>1929</u>
ELEV. _____,	<u>1988</u>

SECTION 21-17-5.


GPS / GEODETIC STATION DESCRIPTION

D.O.T. PROJECT I.D.: LaCrosse Co. computer I.D.: BURC
 STATION NAME: "BURNS CENTRAL" GPS STATION NO. _____
 LATITUDE: _____ LONGITUDE: _____
 LOCAL NAME: _____
 MONUMENT BY AGENCY: County Surveyor DATE: 10/18/93 TYPE: Brass cap in conc.
 SET BY: William C. Jung-(County Surveyor), & Peter F. Follansbee.
 MAINTENANCE RECORD: 2/17/00 OK wcg
 MAINTENANCE RECORD: 11/30/00 OK wcg
 MAINTENANCE RECORD: 6/11/03 OK wcg
 MAINTENANCE RECORD: 11/13/03 OK wcg
 MAINTENANCE RECORD: 4/25/05 OK wcg

The station is located in the east-central part of La Crosse County. More easily found beginning at the intersection of State Highway 16 & State Highway 162 to the north, also being near the South ¼-corner of Section 29, T17N, R5W. Then north along Hwy 162 1.3 miles (2.1 km) to the 15" x 5' concrete marker with brass cap on the east side of the road on the north side of a line fence.

RECORD OF DURABLE WITNESS MONUMENTS

DETAIL SKETCH

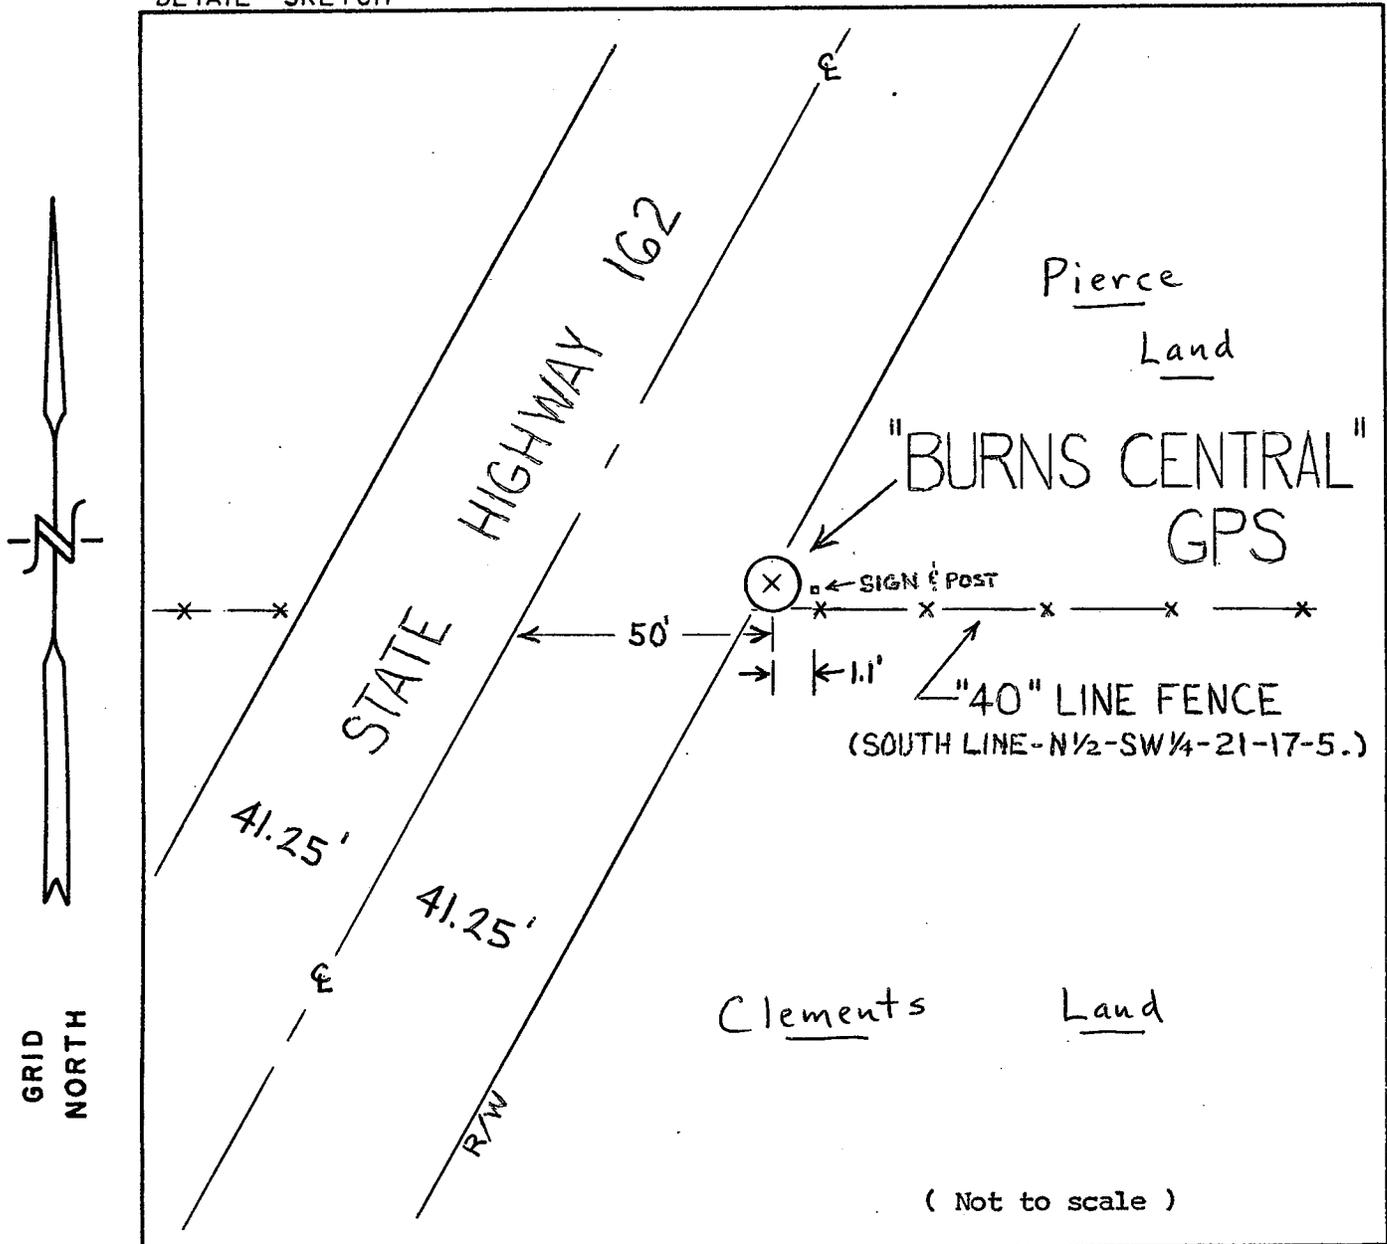

NO.	DESCRIPTION	BEARING	DISTANCE

REMARKS: Mr. Pierce gave us permission to build this marker on his land.

I, William C. Jung, County Surveyor
 HEREBY CERTIFY THAT THE MONUMENT LOCATION SHOWN
 ON THIS RECORD WAS DETERMINED UNDER MY DIRECTION
 AND CONTROL AND THAT THIS GPS/GEODETIC RECORD IS
 CORRECT AND COMPLETE TO THE BEST OF MY KNOWLEDGE
 AND BELIEF.

William C. Jung
 SIGNATURE

2/18/00
 DATE

