


G.P.S. / GEODETIC SURVEY MONUMENT RECORD

SECTION 25, T 17 N, R 5 W, CITY/TOWN/VILLAGE BURNS

LA CROSSE COUNTY

Lat: 43°55'36.335410 N, (.00000m)
 Lon: 90°54'37.889783 W, (.00000m)
 Ell. Hgt in m: (203.0571m), (.00000m)

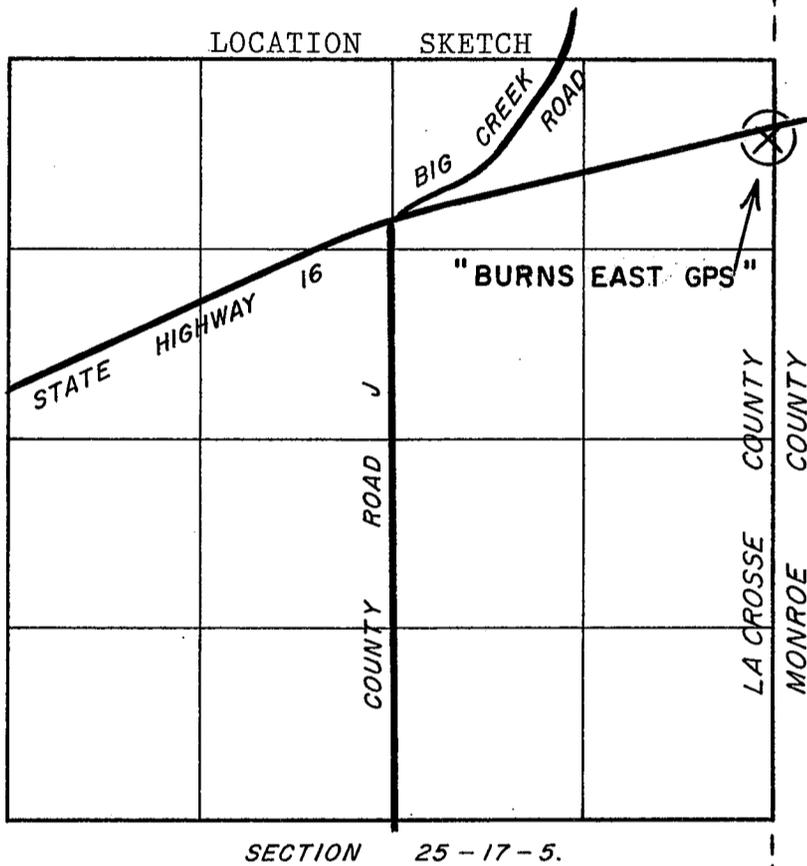

HORIZONTAL DATUM	
NAD 83(91):	
(Y)	703,570.133
(X)	1,728,617.921
NAD 27 _____:	
(Y)	_____
(X)	_____
OTHER: _____	
(Y)	_____
(X)	_____
VERTICAL DATUM	
ELEV. _____,	_____
ELEV. <u>773.6 ±</u> ,	<u>1929</u>
ELEV. _____,	<u>1988</u>

GPS / GEODETIC STATION DESCRIPTION

~~D.O.T. PROJECT I.D.:~~ LaCrosse Co. computer I.D.: BURE

STATION NAME: BURNS EAST GPS STATION NO. 175W25S

LATITUDE: _____ LONGITUDE: _____

LOCAL NAME: E. County Line - "16"

MONUMENT BY AGENCY: County Surveyor DATE: 9/22/93 TYPE: Brass cap in conc.

SET BY: William C. Jung & Peter F. Follansbee

MAINTENANCE RECORD: 11/12/99 OK wcf

MAINTENANCE RECORD: 7/28/03 OK wcf

MAINTENANCE RECORD: 10/30/07 OK wcf


MAINTENANCE RECORD: _____

MAINTENANCE RECORD: _____

The station is located near the East County Line of LaCrosse County. More easily found beginning at the intersection of State Highway 16 & County Road J located north of the Village of Rockland in the Town of Burns. Then traveling northeasterly along State Hwy 16 approximately 0.52mi. (0.84km) to the 15" x 5' concrete marker with brass cap located 52.75ft. (16m) south of centerline.

RECORD OF DURABLE WITNESS MONUMENTS

DETAIL SKETCH

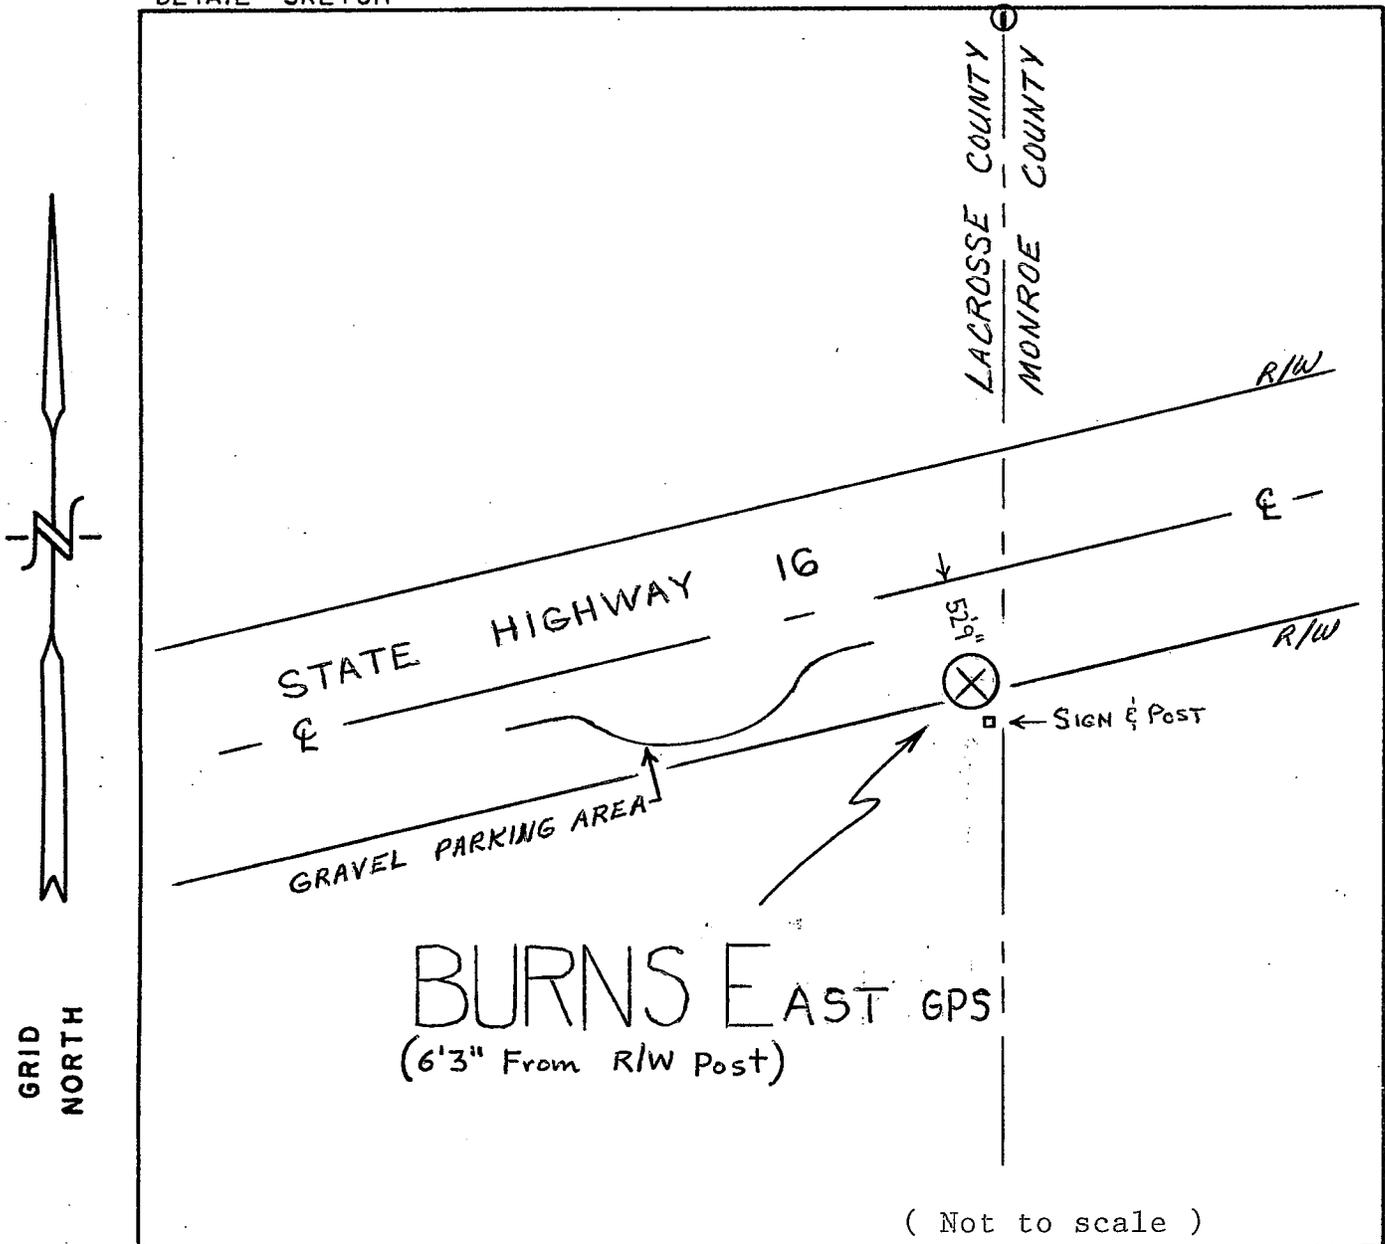

NO.	DESCRIPTION	BEARING	DISTANCE
1	Ex. Harrison Marker @ NE-25-17-5	N0°39'56"W	542.298
		(grid)	(grid)

REMARKS: _____

I, William C. Jung, County Surveyor
 HEREBY CERTIFY THAT THE MONUMENT LOCATION SHOWN
 ON THIS RECORD WAS DETERMINED UNDER MY DIRECTION
 AND CONTROL AND THAT THIS GPS/GEODETIC RECORD IS
 CORRECT AND COMPLETE TO THE BEST OF MY KNOWLEDGE
 AND BELIEF.

William C. Jung 2/8/00
 SIGNATURE DATE

