


# G.P.S. / GEODETIC SURVEY MONUMENT RECORD

SECTION 34, T 16 N, R 7 W, CITY/TOWN/VILLAGE La Crosse

La Crosse COUNTY

Lat: 43°49'19.271418 N, ( .00344m)  
 Lon: 91°11'32.666195 W, ( .00308m)  
 Ell. Hgt in m: (358.2247m), ( .00581m)

LOCATION SKETCH

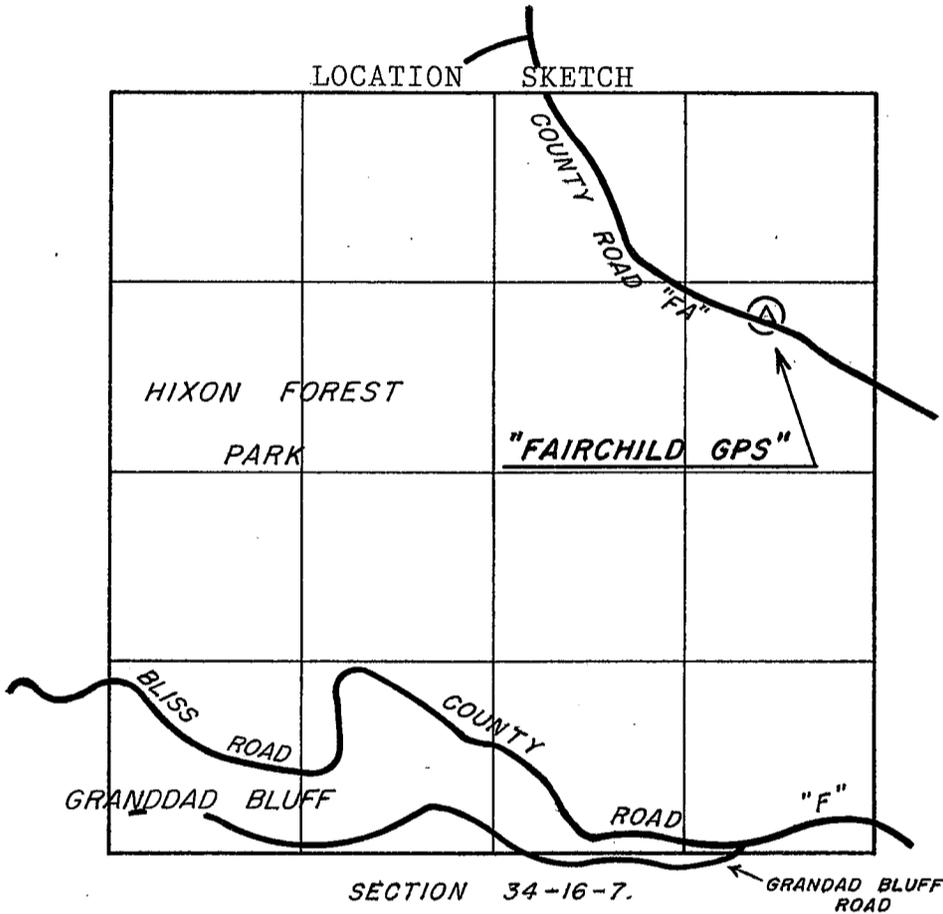

HORIZONTAL DATUM

NAD 83(91):

(Y) 666,330.560

(X) 1,653,813.218

NAD 27 \_\_\_\_\_:

(Y) \_\_\_\_\_

(X) \_\_\_\_\_

OTHER: \_\_\_\_\_

(Y) \_\_\_\_\_

(X) \_\_\_\_\_

VERTICAL DATUM

ELEV. \_\_\_\_\_, \_\_\_\_\_

ELEV. 1279.72±, 1929

ELEV. \_\_\_\_\_, 1988

GPS / GEODETIC STATION DESCRIPTION

~~D.O.T. PROJECT I.D.:~~ LaCrosse Co. computer I.D.: FAIR

STATION NAME: \_\_\_\_\_ STATION NO. \_\_\_\_\_

LATITUDE: \_\_\_\_\_ LONGITUDE: \_\_\_\_\_

LOCAL NAME: " FAIRCHILD GPS "

MONUMENT BY AGENCY: County Surveyor DATE: 10/19/93 TYPE: Brass cap in pipe.

SET BY: Paul E. Fairchild

MAINTENANCE RECORD: 6/3/97 OK weg

MAINTENANCE RECORD: 4/18/05 OK weg

MAINTENANCE RECORD: 12/27/06 OK weg

MAINTENANCE RECORD: \_\_\_\_\_


MAINTENANCE RECORD: \_\_\_\_\_

The station is located in the southwestern part of LaCrosse County. More easily found beginning in the City of LaCrosse at the intersection of Main Street & Losey Boulevard ( also being the approximate S. 1/2-Cor., Sec. 33-16-7 ). Then east along Main St. to the base of the bluff and the beginning of Bliss Road ( a continuation from Main St. ). Then northeasterly and easterly along Bliss Rd, approximately 1.4 miles ( 2.3 km ) to the intersection with Granddad Bluff Road near the Alpine Inn ( this road intersection being the approximate beginning of County Road "F" ). Then east erly along County Rd. "F" approximately 0.44 miles ( 0.7 km ) to the intersection with County Road "FA". Then northerly along County Rd. "FA" approximately 0.8 miles ( 1.3 km ) to the brass cap marker in a concrete filled iron pipe located 38 ft. + ( 11.6 m ) northeast of the road centerline. The marker is southwest of the National Weather Bureau Building with a sign & post nearby.

# RECORD OF DURABLE WITNESS MONUMENTS

DETAIL SKETCH

( Not to scale )

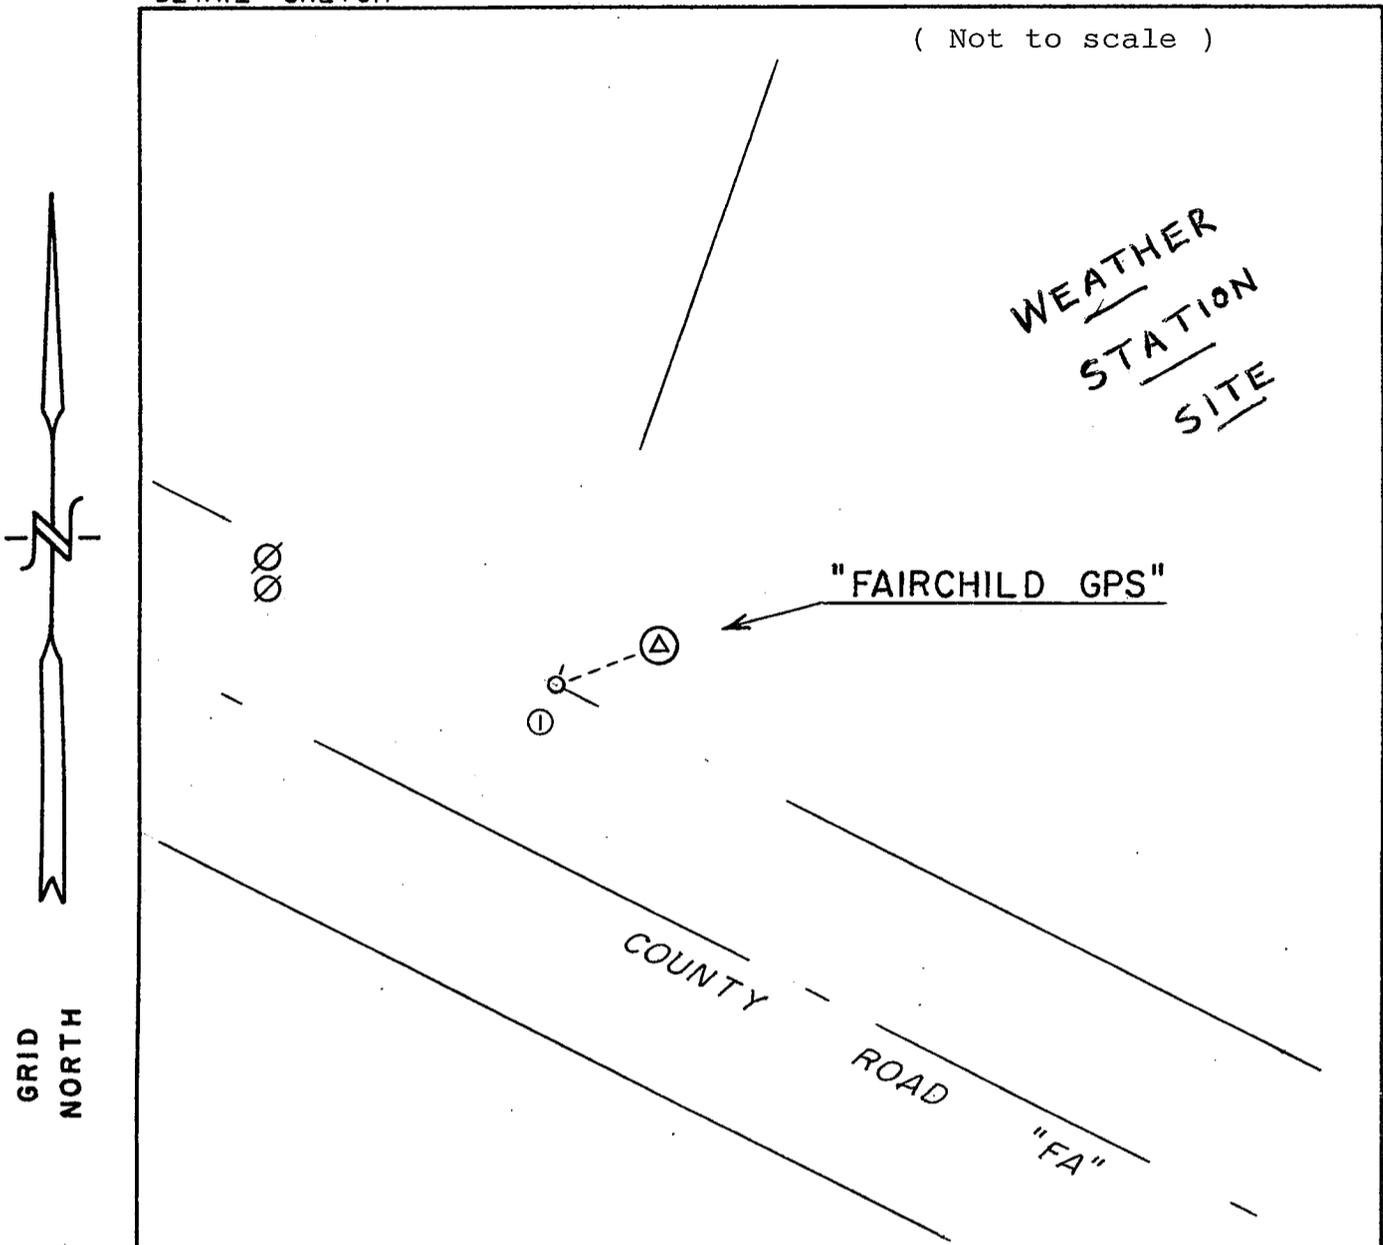

NO.	DESCRIPTION	BEARING	DISTANCE
1	Ex. #4 Rebar with aluminum cap(prop'y cor.)	Southwesterly±	6.94 Ft.

REMARKS: \_\_\_\_\_  
 \_\_\_\_\_  
 \_\_\_\_\_  
 \_\_\_\_\_  
 \_\_\_\_\_

I, William C. Jung, County Surveyor  
 HEREBY CERTIFY THAT THE MONUMENT LOCATION SHOWN  
 ON THIS RECORD WAS DETERMINED UNDER MY DIRECTION  
 AND CONTROL AND THAT THIS GPS/GEODETIC RECORD IS  
 CORRECT AND COMPLETE TO THE BEST OF MY KNOWLEDGE  
 AND BELIEF.

William C. Jung  
 SIGNATURE

3/24/00  
 DATE

