


# G.P.S. / GEODETIC SURVEY MONUMENT RECORD

SECTION 4, T 18 N, R 6 W, CITY/TOWN/VILLAGE FARMINGTON

LA CROSSE COUNTY

Lat: 44°04'15.810680 N, (.00000m)  
 Lon: 91°06'22.879117 W, (.00000m)  
 Ell. Hgt in m: (207.7337m), (.00000m)

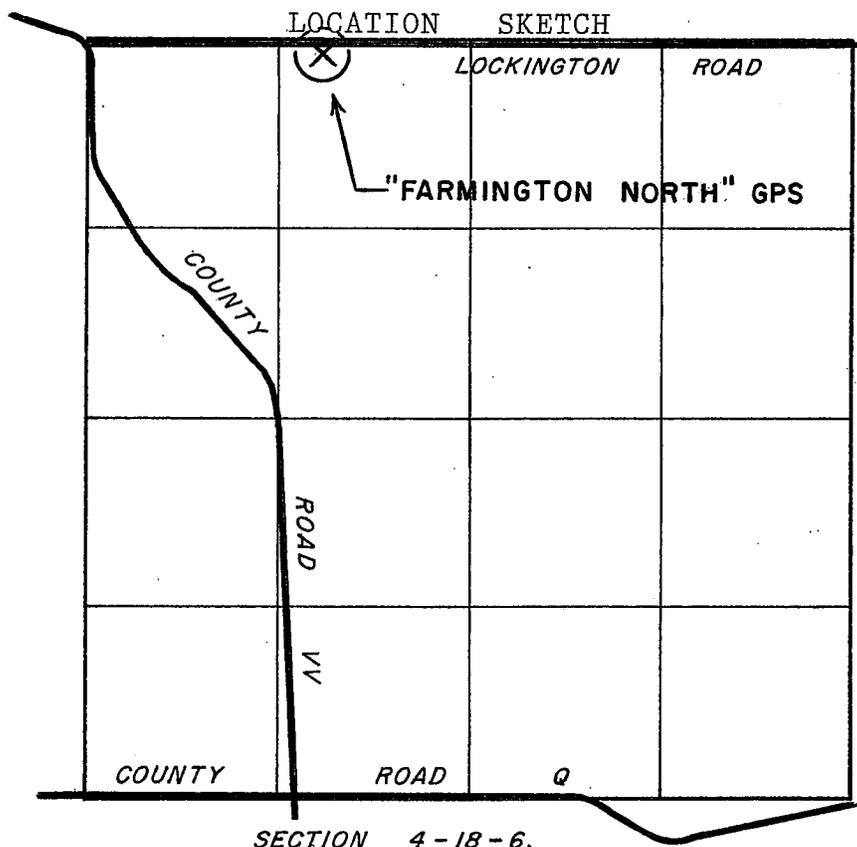

HORIZONTAL DATUM	
NAD 83(91):	
(Y)	756,791.497
(X)	1,677,726.133
NAD 27 _____:	
(Y)	_____
(X)	_____
OTHER: _____	
(Y)	_____
(X)	_____
VERTICAL DATUM	
ELEV. _____,	_____
ELEV. _____,	<u>1929</u>
ELEV. _____,	<u>1988</u>

## GPS / GEODETIC STATION DESCRIPTION

D.O.T. PROJECT I.D.: LaCrosse Co. computer I.D.: FARN

STATION NAME: FARMINGTON NORTH STATION NO. 186W4S

LATITUDE: \_\_\_\_\_ LONGITUDE: \_\_\_\_\_

LOCAL NAME: Lockington - North Co. Line

MONUMENT BY AGENCY: County Surveyor DATE: 9/30/93 TYPE: Brass cap in conc.

SET BY: William C. Jung & Peter F. Follansbee

MAINTENANCE RECORD: 12/13/96 OK weg

MAINTENANCE RECORD: 10/16/01 OK weg

MAINTENANCE RECORD: \_\_\_\_\_

MAINTENANCE RECORD: \_\_\_\_\_



MAINTENANCE RECORD: \_\_\_\_\_

The station is in the north-central part of LaCrosse County and near the North County Line in the Town of Farmington. More easily found beginning at the intersection of State Highway 54 & County Road VV in the unincorporated area known as "North Bend" in the Town of North Bend in the SW-part of Jackson County. Then southerly along County Road VV 2.1mi. (3.4km) to the intersection with Lockington Road (having crossed the Black River & to the Jackson - LaCrosse County Line). Then east along Lockington Rd. 0.30mi. (0.48km) to the 15" x 5' concrete marker with brass cap located near the south R/W fence.

# RECORD OF DURABLE WITNESS MONUMENTS

DETAIL SKETCH

( Not to scale )

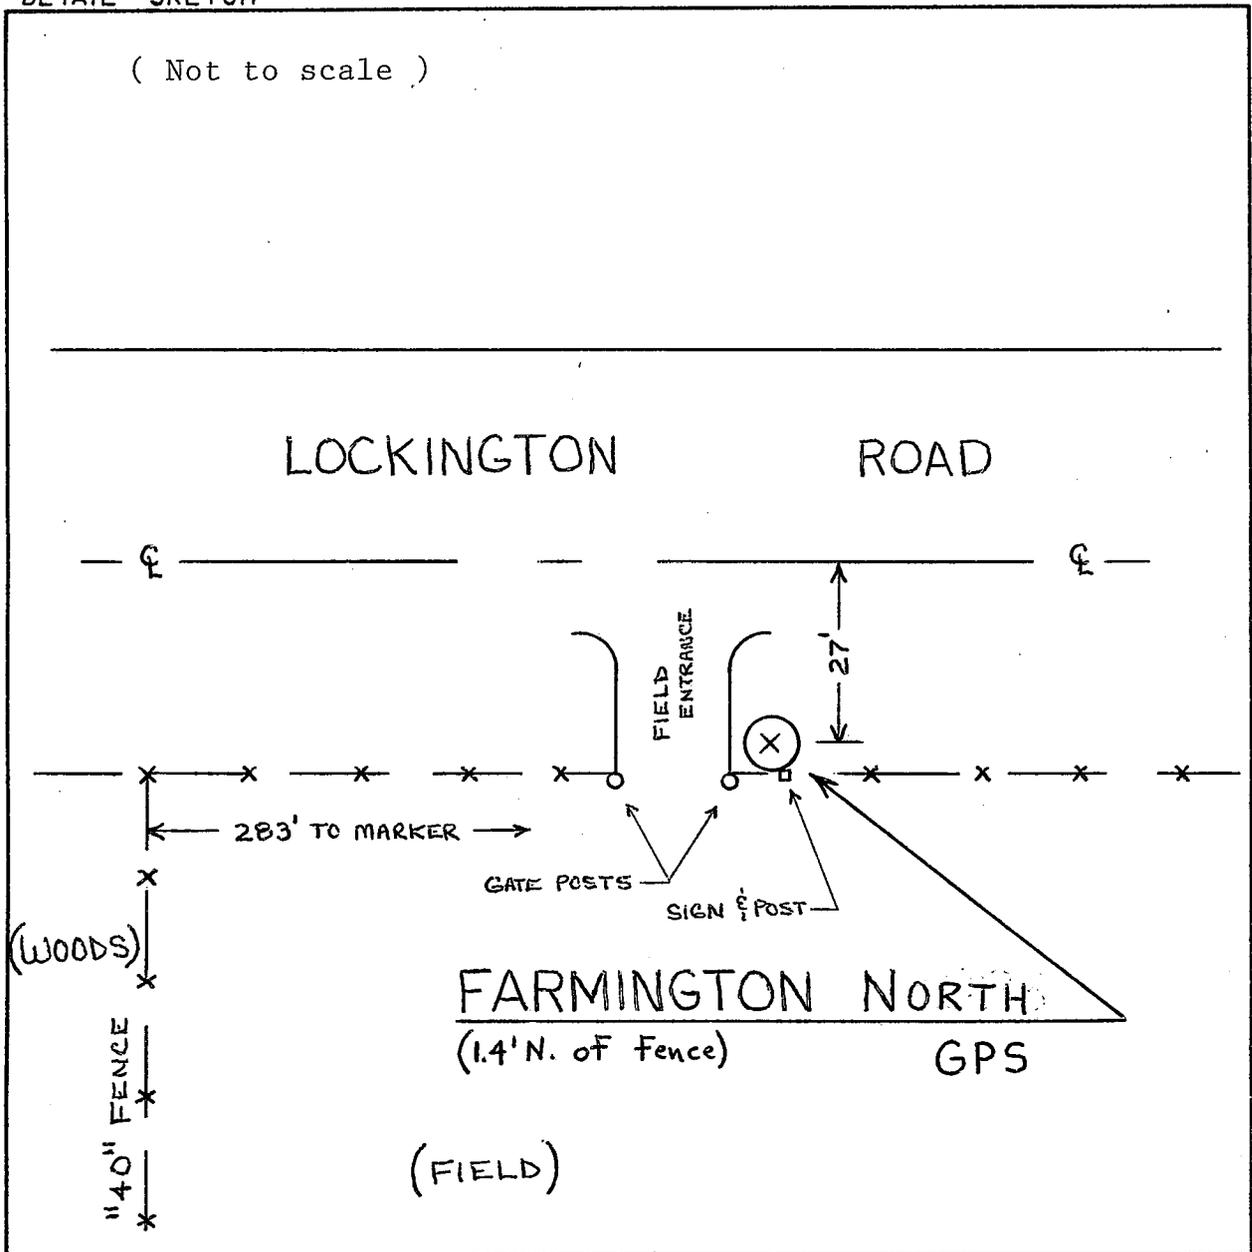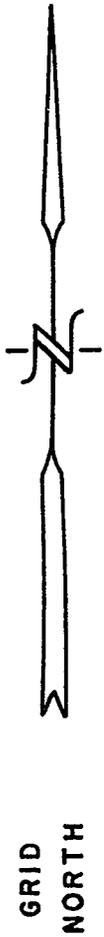

NO.	DESCRIPTION	BEARING	DISTANCE

REMARKS: \_\_\_\_\_  
 \_\_\_\_\_  
 \_\_\_\_\_  
 \_\_\_\_\_

I, William C. Jung, County Surveyor  
 HEREBY CERTIFY THAT THE MONUMENT LOCATION SHOWN  
 ON THIS RECORD WAS DETERMINED UNDER MY DIRECTION  
 AND CONTROL AND THAT THIS GPS/GEODETIC RECORD IS  
 CORRECT AND COMPLETE TO THE BEST OF MY KNOWLEDGE  
 AND BELIEF.

William C. Jung  
 SIGNATURE

3/29/00  
 DATE

