


G.P.S. / GEODETIC SURVEY MONUMENT RECORD

SECTION 1, T 17 N, R 5 W, CITY/TOWN/VILLAGE BURNS

LA CROSSE COUNTY

Lat: 43°58'25.163815 N, (.00358m)
 Lon: 90°55'03.083583 W, (.00359m)
 Ell. Hgt in m: (304.2079m), (.00682m)

LOCATION SKETCH

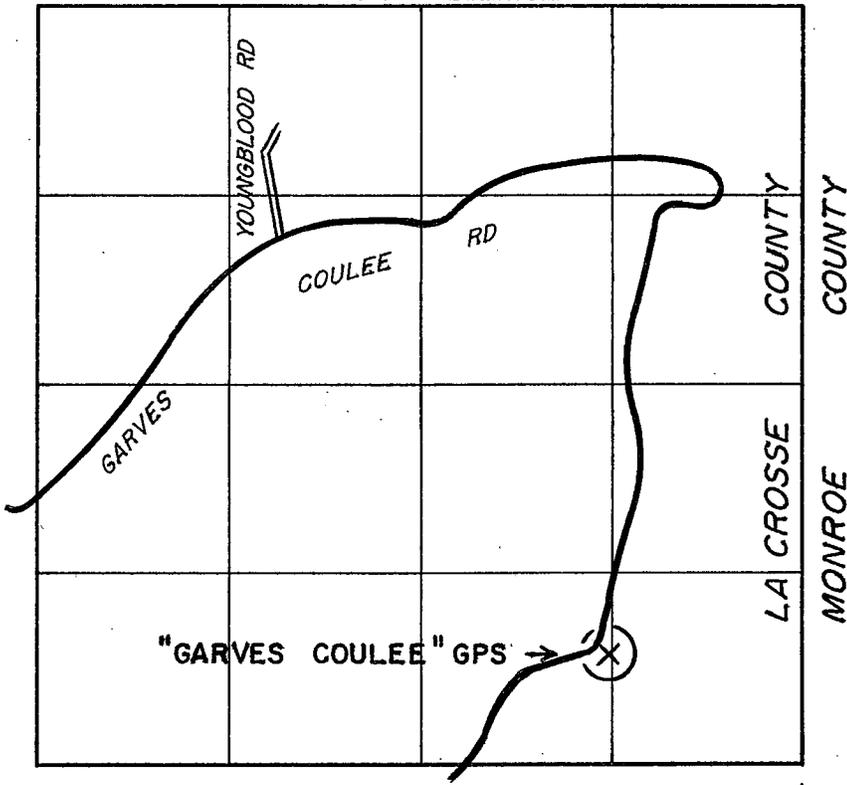

SECTION 1-17-5.

HORIZONTAL DATUM	
NAD 83(91):	
(Y)	720,684.576
(X)	1,726,962.364
NAD 27 _____:	
(Y)	_____
(X)	_____
OTHER: _____	
(Y)	_____
(X)	_____
VERTICAL DATUM	
ELEV. _____,	_____
ELEV. _____,	<u>1929</u>
ELEV. _____,	<u>1988</u>

GPS / GEODETIC STATION DESCRIPTION

~~D.O.T. PROJECT I.D.:~~ LaCrosse Co. computer I.D.: GARV

STATION NAME: "GARVES COULEE" GPS STATION NO. _____

LATITUDE: _____ LONGITUDE: _____

LOCAL NAME: _____

MONUMENT BY AGENCY: County Surveyor DATE: 10/19/93 TYPE: Berntsen top in conc.

SET BY: William C. Jung-(County Surveyor), & Peter F. Follansbee.

MAINTENANCE RECORD: 8/11/99 OK wcy

MAINTENANCE RECORD: 5/18/05 Set "carsonite" post w/sign. wcy

MAINTENANCE RECORD: _____


MAINTENANCE RECORD: _____

MAINTENANCE RECORD: _____

The station is located near the east County Line of La Crosse County. More easily found beginning at the intersection of State Highway 16 & State Highway 162 to the north, the intersection being north-west of the Village of Bangor. Then north along Hwy 162 5.2mi. (8.4km) to the intersection with Garves Coulee Road. Then easterly along Garves Coulee Rd 2.5mi. (4.0km) to the 12" x 4' concrete marker with Berntsen Top built on the east side of the road on the high bank.

RECORD OF DURABLE WITNESS MONUMENTS

DETAIL SKETCH

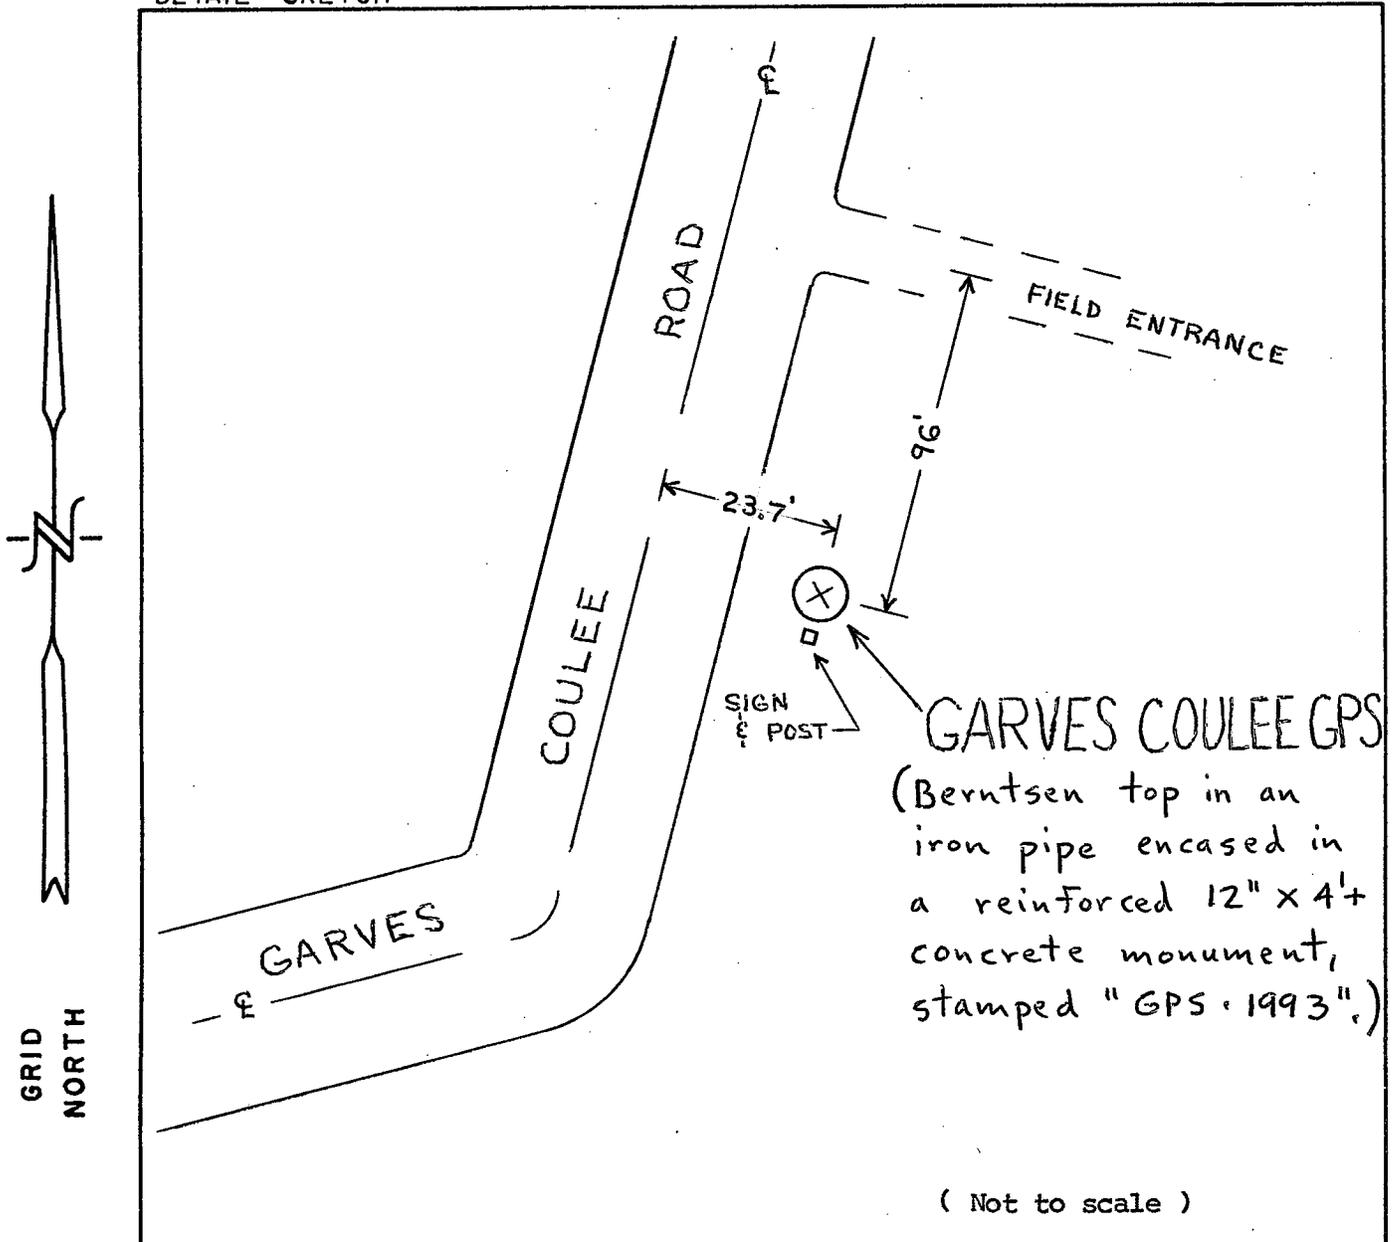

(Not to scale)

NO.	DESCRIPTION	BEARING	DISTANCE

REMARKS: _____

I, William C. Jung, County Surveyor
 HEREBY CERTIFY THAT THE MONUMENT LOCATION SHOWN
 ON THIS RECORD WAS DETERMINED UNDER MY DIRECTION
 AND CONTROL AND THAT THIS GPS/GEODETIC RECORD IS
 CORRECT AND COMPLETE TO THE BEST OF MY KNOWLEDGE
 AND BELIEF.

William C. Jung
 SIGNATURE

2/15/00
 DATE

