


G.P.S. / GEODETIC SURVEY MONUMENT RECORD

SECTION 31, T 17 N, R 6 W, CITY/TOWN/VILLAGE HAMILTON

LA CROSSE COUNTY

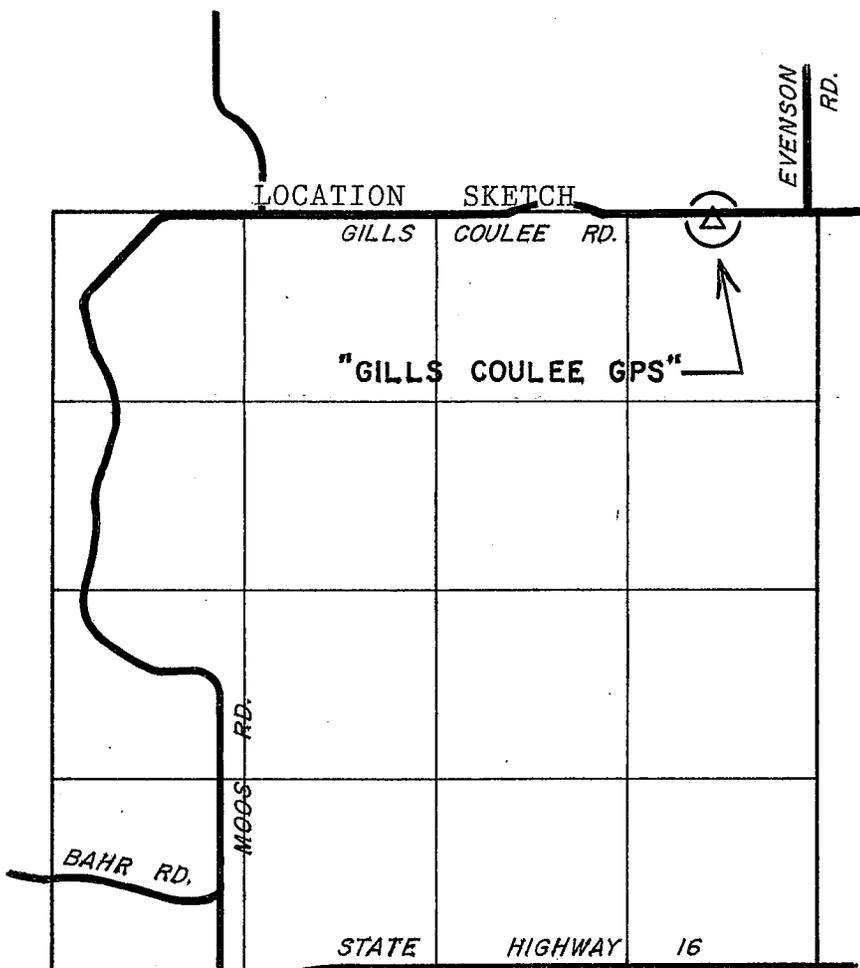

HORIZONTAL DATUM	
NAD 83(91):	
(Y)	699,456.634
(X)	1,669,665.614
NAD 27:	
(Y)	
(X)	
OTHER:	
(Y)	
(X)	
VERTICAL DATUM	
ELEV.	
ELEV.	741.5±, 1929
ELEV.	, 1988

SECTION 31-17-6.

Lat: 43°54'48.576818 N, (.00280m)
 Lon: 91°08'02.594839 W, (.00260m)
 Ell. Hgt in m: (193.9681m), (.00537m)


GPS / GEODETIC STATION DESCRIPTION

~~D.O.T. PROJECT I.D.:~~ LaCrosse Co. computer I.D.: GILL
 STATION NAME: "GILLS COULEE GPS" STATION NO. _____
 LATITUDE: _____ LONGITUDE: _____
 LOCAL NAME: _____
 MONUMENT BY AGENCY: County Surveyor DATE: 10/21/94 TYPE: Brass cap in conc.
 SET BY: William C. Jung-(County Surveyor) & Peter F. Follansbee
 MAINTENANCE RECORD: 11/21/95 OK weg
 MAINTENANCE RECORD: 9/2/04 OK weg
 MAINTENANCE RECORD: 5/4/05 OK weg
 MAINTENANCE RECORD: 8/15/06 OK weg
 MAINTENANCE RECORD: _____

The station is located in the central part of LaCrosse County. More easily found beginning near the west side of the Village of West Salem at the intersection of State Highway 16 & County Road M. Then north along County Rd. M 1.0 miles (1.61km) to the intersection with Gills Coulee Road. Then west along Gills Coulee Rd. 1.62 miles (2.61km) to the 12" x 5' concrete marker with brass cap 22.75 ft. (6.93m) south of centerline.

RECORD OF DURABLE WITNESS MONUMENTS

DETAIL SKETCH

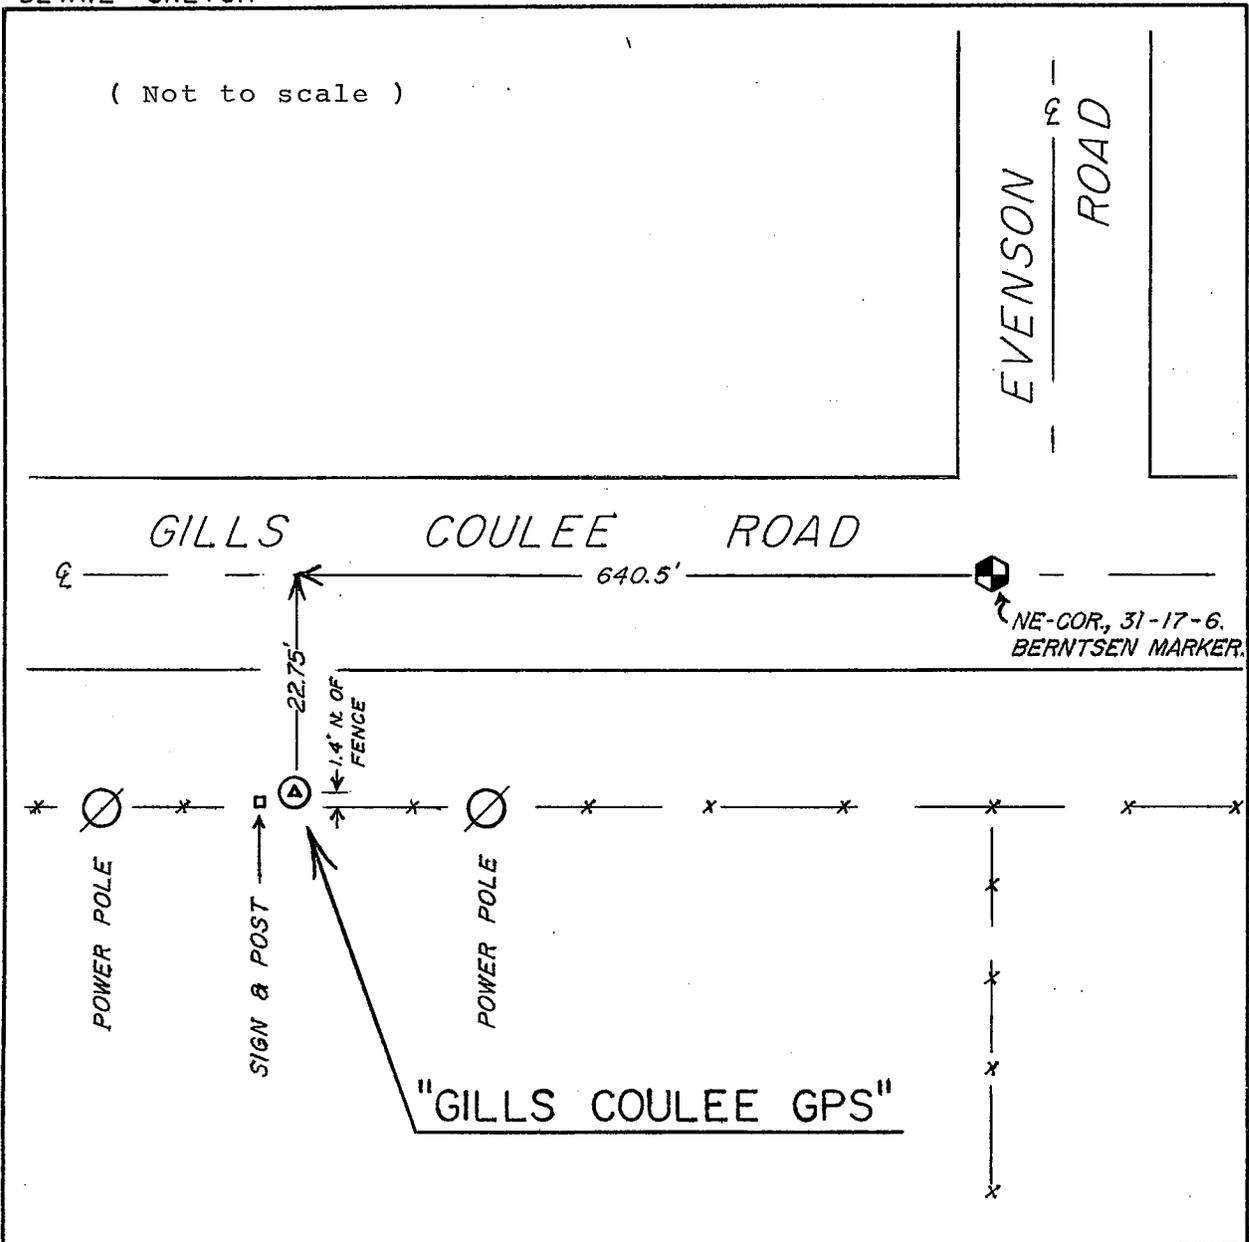

NO.	DESCRIPTION	BEARING	DISTANCE

REMARKS: _____

I, William C. Jung, County Surveyor
 HEREBY CERTIFY THAT THE MONUMENT LOCATION SHOWN
 ON THIS RECORD WAS DETERMINED UNDER MY DIRECTION
 AND CONTROL AND THAT THIS GPS/GEODETIC RECORD IS
 CORRECT AND COMPLETE TO THE BEST OF MY KNOWLEDGE
 AND BELIEF.

William C. Jung
 SIGNATURE

3/24/00
 DATE

