


G.P.S. / GEODETIC SURVEY MONUMENT RECORD

SECTION 30, T 14 N, R 6 W, CITY/TOWN/VILLAGE HAMBURG

VERNON COUNTY

Lat: 43°39'32.560080 N, (.00000m)
 Lon: 91°08'49.387510 W, (.00000m)
 Ell. Hgt in m: (181.1600m), (.00000m)

LOCATION SKETCH

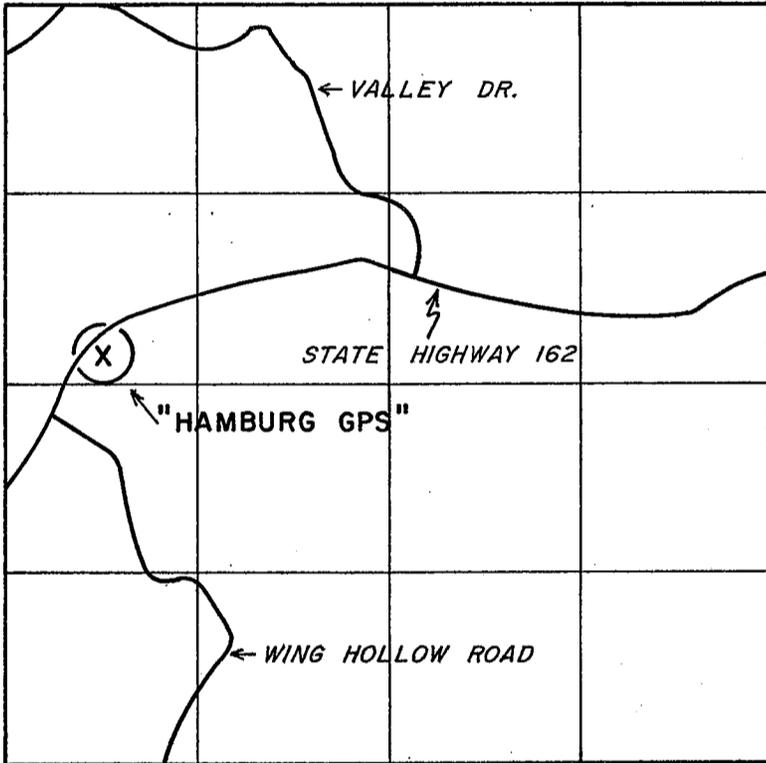

SECTION 30-14-6 (NOT TO SCALE)

HORIZONTAL DATUM	
NAD 83(91):	
(Y)	606,762.766
(X)	1,664,964.944
NAD 27 :	
(Y)	_____
(X)	_____
OTHER: _____	
(Y)	_____
(X)	_____
VERTICAL DATUM	
ELEV.	_____
ELEV.	_____ 1929
ELEV.	_____ 1988

GPS / GEODETIC STATION DESCRIPTION

~~D.O.T. PROJECT I.D.:~~ LaCrosse Co. computer I.D.: HAMB

STATION NAME: "HAMBURG GPS" STATION NO. 146W30S

LATITUDE: N 43°39'32.56008" LONGITUDE: W 91°08'49.38751"

LOCAL NAME: Wing Hollow

MONUMENT BY AGENCY: LaX Co. Surveyor DATE: 10/11/1993 TYPE: Brass Cap in Conc.

SET BY: William C. Jung-(LaCrosse County Surveyor), Peter F. Follansbee


MAINTENANCE RECORD: _____

The station is located east of the Village of Stoddard, approximately 4 miles East from the intersection of State Highway 35 & State Highway 162. The 15" x 5' concrete marker with brass cap is on the top of the slope & 83' southeasterly of the centerline of State Highway 162. The centerline of Wing Hollow Road is 400'+ southwest of the marker. (4 mi. = 6.44 km, 400' = 122m)

RECORD OF DURABLE WITNESS MONUMENTS

DETAIL SKETCH

(Not to Scale)

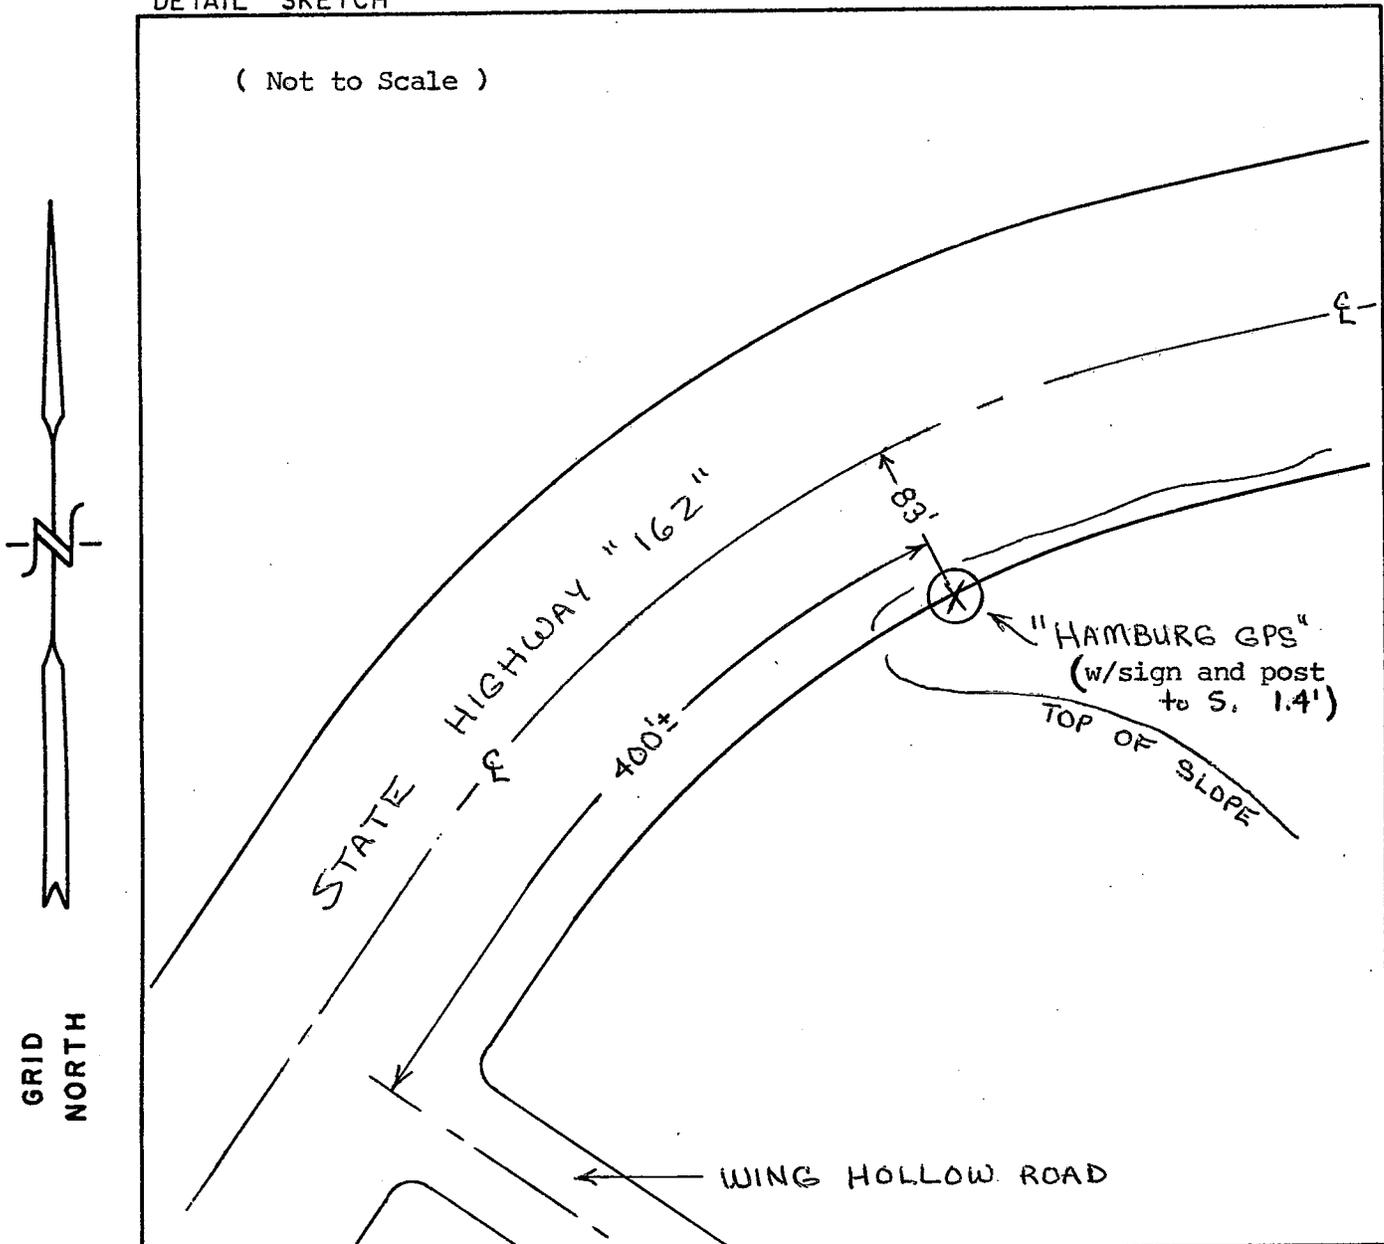

NO.	DESCRIPTION	BEARING	DISTANCE

REMARKS: The Hansons gave us permission
on 8/6/93 and 10/11/93 to build this
marker at this location.

I, William C. Jung, LaCrosse County Surveyor
 HEREBY CERTIFY THAT THE MONUMENT LOCATION SHOWN
 ON THIS RECORD WAS DETERMINED UNDER MY DIRECTION
 AND CONTROL AND THAT THIS GPS/GEODETIC RECORD IS
 CORRECT AND COMPLETE TO THE BEST OF MY KNOWLEDGE
 AND BELIEF.

William C. Jung
 SIGNATURE

3/27/00
 DATE

