


G.P.S. / GEODETIC SURVEY MONUMENT RECORD

SECTION 22, T 17 N, R 6 W, CITY/TOWN/VILLAGE HAMILTON

LA CROSSE COUNTY

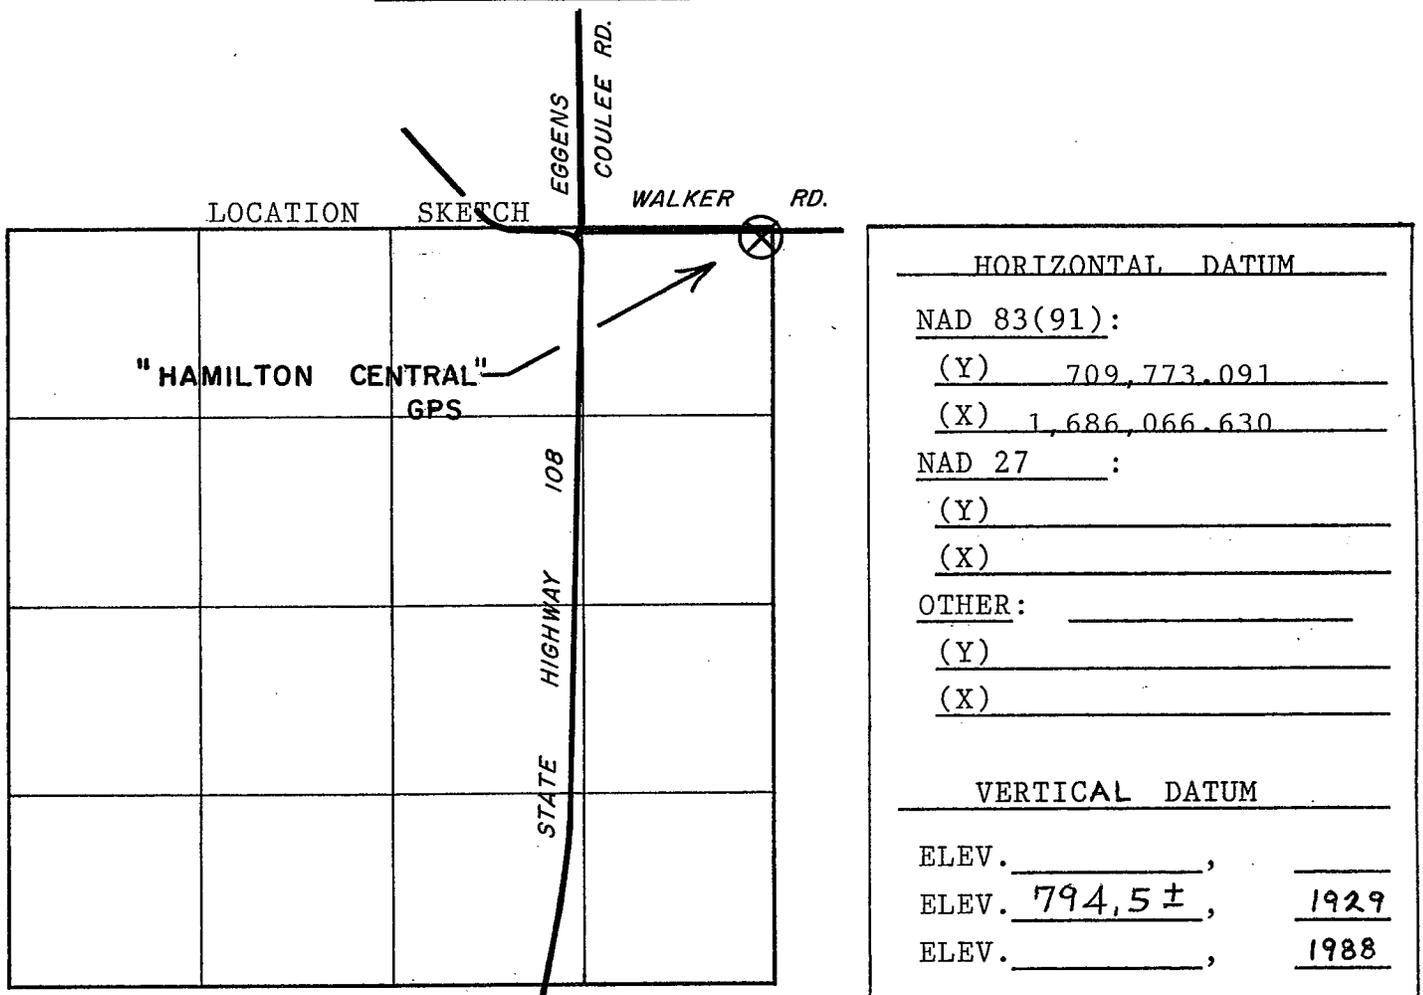

HORIZONTAL DATUM	
NAD 83(91):	
(Y)	709,773.091
(X)	1,686,066.630
NAD 27:	
(Y)	
(X)	
OTHER:	
(Y)	
(X)	
VERTICAL DATUM	
ELEV.	
ELEV.	794.5 ± 1929
ELEV.	1988

SECTION 22-17-6.

Lat: 43°56'32.594106 N, (.00000m)
 Lon: 91°04'20.366319 W, (.00000m)
 Ell. Hgt in m: (209.9052m), (.00000m)


GPS / GEODETIC STATION DESCRIPTION

~~D.O.T. PROJECT I.D.:~~ LaCrosse Co. computer I.D.: HAMC
 STATION NAME: "HAMILTON CENTRAL" GPS STATION NO. 176W22S
 LATITUDE: _____ LONGITUDE: _____
 LOCAL NAME: Walker Road
 MONUMENT BY AGENCY: County Surveyor DATE: 9/27/93 TYPE: Brass cap in conc.
 SET BY: William C. Jung & Peter F. Follansbee
 MAINTENANCE RECORD: 10/25/96 OK wcg
 MAINTENANCE RECORD: 6/6/01 OK wcg
 MAINTENANCE RECORD: 8/27/02 OK wcg
 MAINTENANCE RECORD: 2/7/06 OK wcg
 MAINTENANCE RECORD: _____

The station is centrally located in LaCrosse County. More easily found beginning north of the Village of West Salem at the intersection of State Highway 16 & State Highway 108, then northerly along Hwy 108 approximately 2.6mi. (4.1km) to the intersection with Eggens Coulee Rd. Going immediately east from the intersection will bring you to Walker Road. Then traveling east 0.24mi (0.4km) along Walker Road will bring you to the marker located 23ft. (7m) south of centerline.

RECORD OF DURABLE WITNESS MONUMENTS

DETAIL SKETCH

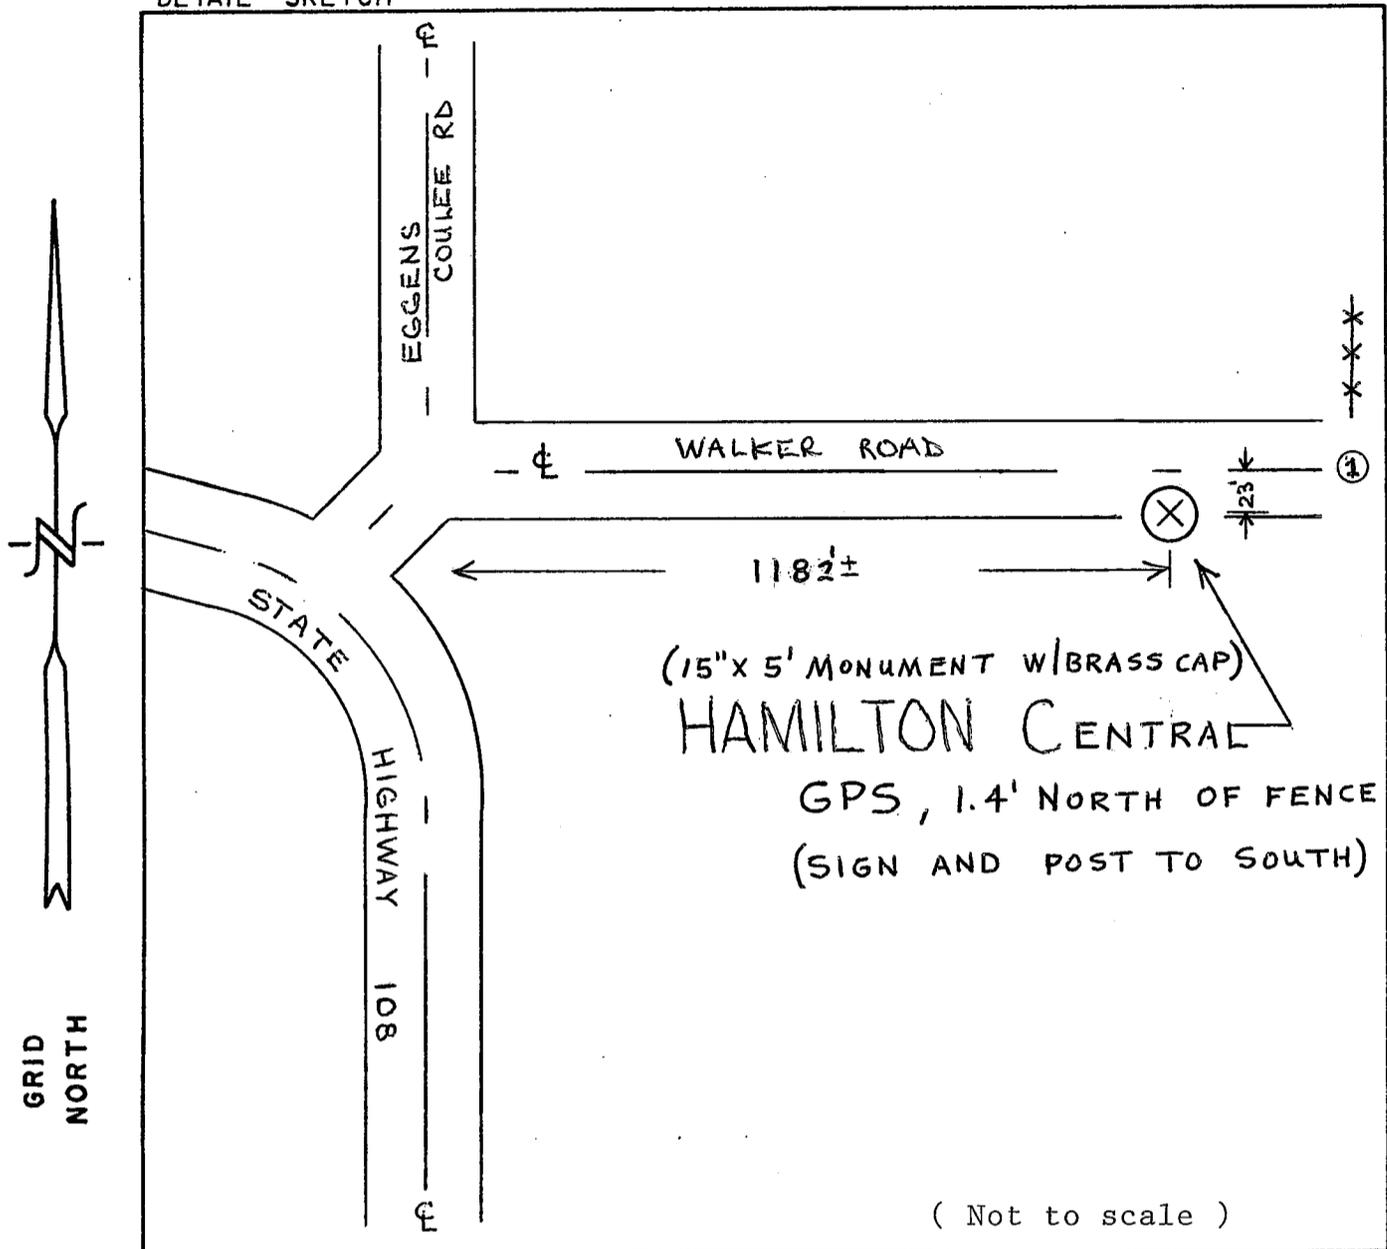

(Not to scale)

NO.	DESCRIPTION	BEARING	DISTANCE
1	R.R.S. @ SECTION CORNER	N81°34'E (True)	153.95

REMARKS: _____

I, William C. Jung, County Surveyor
 HEREBY CERTIFY THAT THE MONUMENT LOCATION SHOWN
 ON THIS RECORD WAS DETERMINED UNDER MY DIRECTION
 AND CONTROL AND THAT THIS GPS/GEODETIC RECORD IS
 CORRECT AND COMPLETE TO THE BEST OF MY KNOWLEDGE
 AND BELIEF.

William C. Jung
 SIGNATURE

3/28/00
 DATE

