


G.P.S. / GEODETIC SURVEY MONUMENT RECORD

SECTION 29, T 18 N, R 5 W, ~~CITY~~/TOWN/~~VILLAGE~~ FARMINGTON

LA CROSSE COUNTY

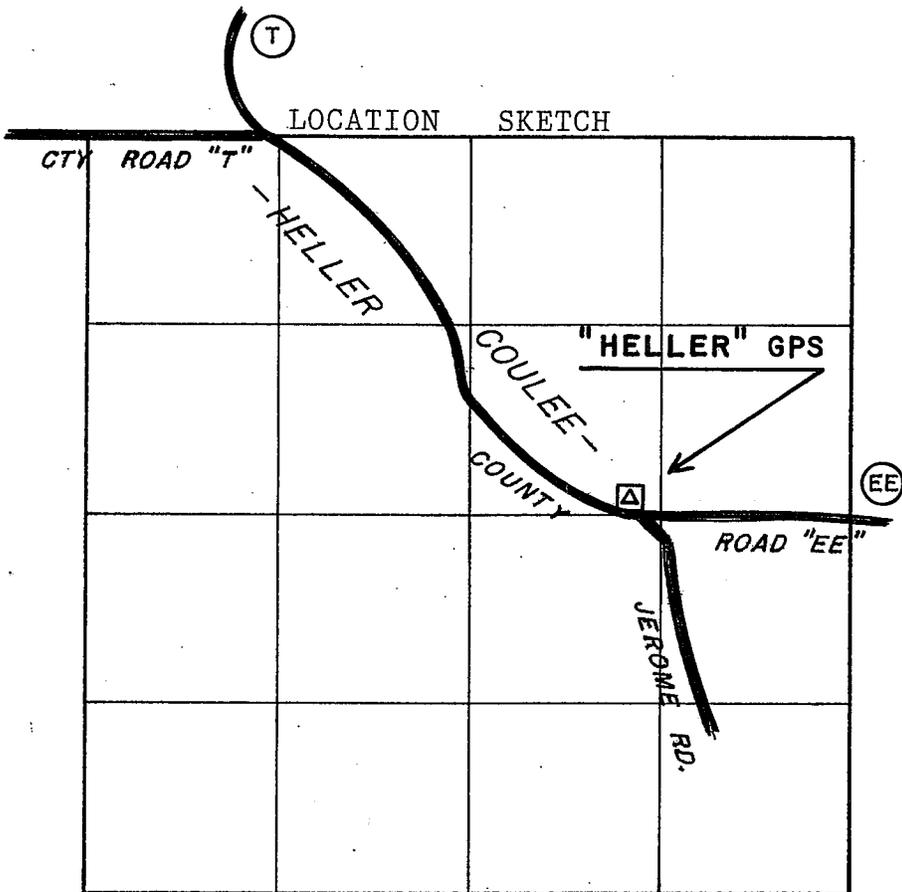

SECTION 29-18-5.

| HORIZONTAL DATUM | |
|----------------------|----------------|
| NAD 83(91): | |
| (Y) | 733,140.4026 |
| (X) | 1,705,837.8641 |
| NAD 27 _____: | |
| (Y) | _____ |
| (X) | _____ |
| OTHER: _____ | |
| (Y) | _____ |
| (X) | _____ |
| VERTICAL DATUM | |
| ELEV. 895.09 * | GPS |
| ELEV. <u>895.1 ±</u> | <u>1929</u> |
| ELEV. _____ | <u>1988</u> |

*Derived from level circuit from GPS marker.

GPS / GEODETIC STATION DESCRIPTION

~~D.O.T. PROJECT I.D.:~~ LaCrosse Co. computer I.D.: HELL

STATION NAME: ET 4 JA STATION NO. _____

LATITUDE: _____ LONGITUDE: _____

LOCAL NAME: "HELLER" GPS

MONUMENT BY AGENCY: Dept. of Interior DATE: 1962 TYPE: Alum. cap in conc.

SET BY: Department of Interior


MAINTENANCE RECORD: _____

The station is located in the northeastern part of La Crosse County. More easily found beginning at the unincorporated area known as Mindoro, at the intersection of State Highway "108" & County Road "D". Then north 0.5mi. (0.8km) to County Road "T". Then easterly along "T" approx. 5.0mi. (8.0km) to the intersection with County Road "EE". Then southeasterly along "EE" approx. 0.68mi. (1.1km) to the concrete marker with aluminum cap located approx. 89ft. (27m) north of the centerline.

RECORD OF DURABLE WITNESS MONUMENTS

DETAIL SKETCH

(NOT TO SCALE)

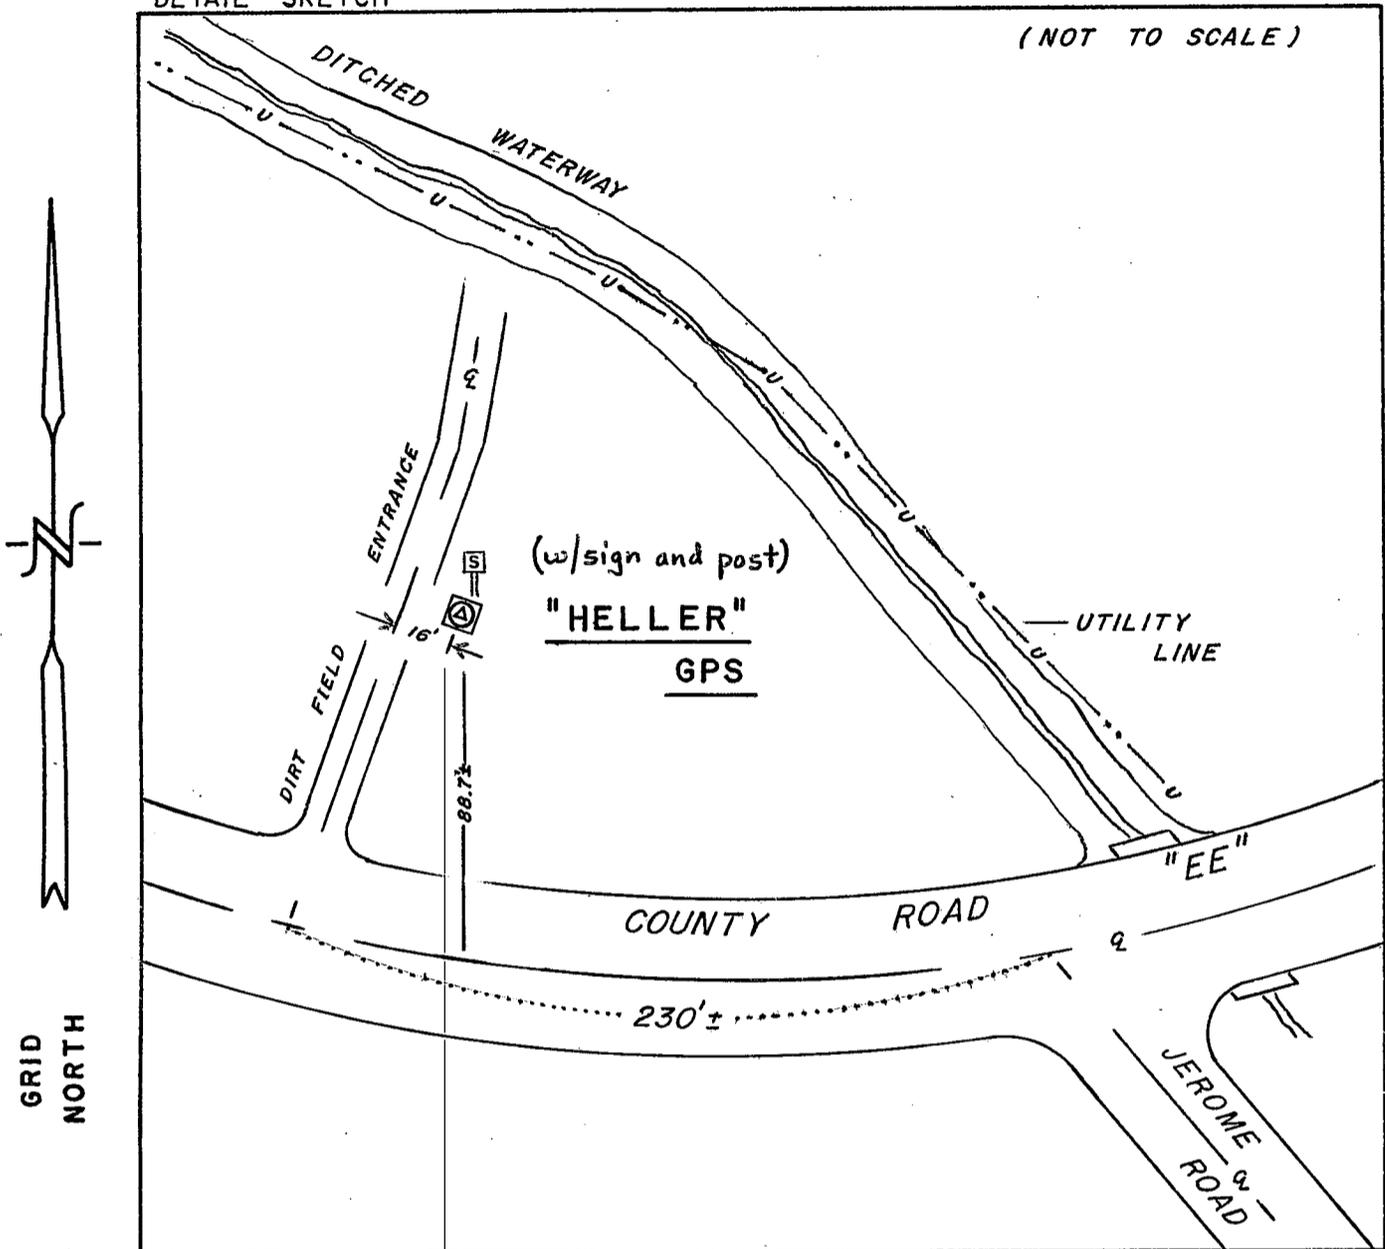

| NO. | DESCRIPTION | BEARING | DISTANCE |
|-----|-------------|---------|----------|
| | | | |
| | | | |
| | | | |
| | | | |

REMARKS: _____

I, WILLIAM G. JUNG, COUNTY SURVEYOR
 HEREBY CERTIFY THAT THE MONUMENT LOCATION SHOWN
 ON THIS RECORD WAS DETERMINED UNDER MY DIRECTION
 AND CONTROL AND THAT THIS GPS/GEODETIC RECORD IS
 CORRECT AND COMPLETE TO THE BEST OF MY KNOWLEDGE
 AND BELIEF.

William C. Jung
 SIGNATURE

6/27/03
 DATE

