


G.P.S. / GEODETIC SURVEY MONUMENT RECORD

SECTION 31, T 18 N, R 5 W, CITY/TOWN/VILLAGE FARMINGTON

LA CROSSE COUNTY

Lat: 43°59'42.620287 N, (.00244m)
 Lon: 91°01'06.567956 W, (.00278m)
 Ell. Hgt in m: (232.3187m), (.00494m)

LOCATION SKETCH

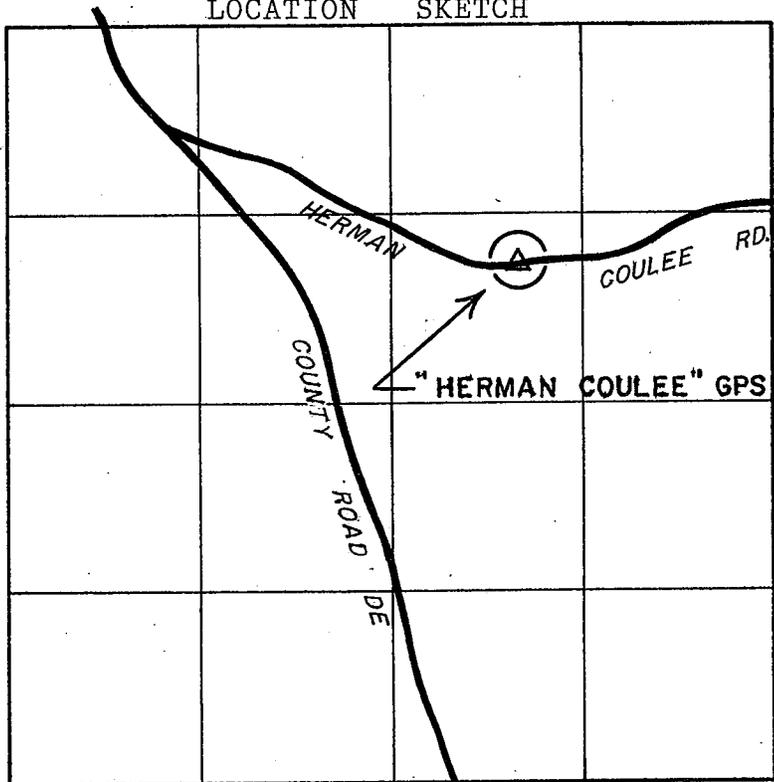

SECTION 31-18-5.

<u>HORIZONTAL DATUM</u>	
NAD 83(91):	
(Y)	<u>728,835.743</u>
(X)	<u>1,700,479.658</u>
NAD 27 _____:	
(Y)	_____
(X)	_____
OTHER: _____	
(Y)	_____
(X)	_____
<u>VERTICAL DATUM</u>	
ELEV. _____,	_____
ELEV. _____,	<u>1929</u>
ELEV. _____,	<u>1988</u>

GPS / GEODETIC STATION DESCRIPTION

~~D.O.T. PROJECT I.D.:~~ LaCrosse Co. computer I.D.: HERM

STATION NAME: "HERMAN COULEE" STATION NO. _____

LATITUDE: _____ LONGITUDE: _____

LOCAL NAME: _____

MONUMENT BY AGENCY: County Surveyor DATE: 8/23/1995 TYPE: Brass cap in conc.

SET BY: William C. Jung-(County Surveyor) & Peter F. Follansbee.

MAINTENANCE RECORD: 12/14/99 OK weg

MAINTENANCE RECORD: _____

MAINTENANCE RECORD: _____


MAINTENANCE RECORD: _____

MAINTENANCE RECORD: _____

The station is located in the northeastern part of La Crosse County. More easily found beginning at the unincorporated area known as Mindoro at the intersection of County Road DE and State Highway 108. Then southeasterly along County Rd. DE 4.25 miles (6.8km) to the intersection with Herman Coulee Road. Then east along Herman Coulee Rd. 0.49 miles (0.79km) to the concrete marker with brass cap on the north side of the roadway.

RECORD OF DURABLE WITNESS MONUMENTS

DETAIL SKETCH

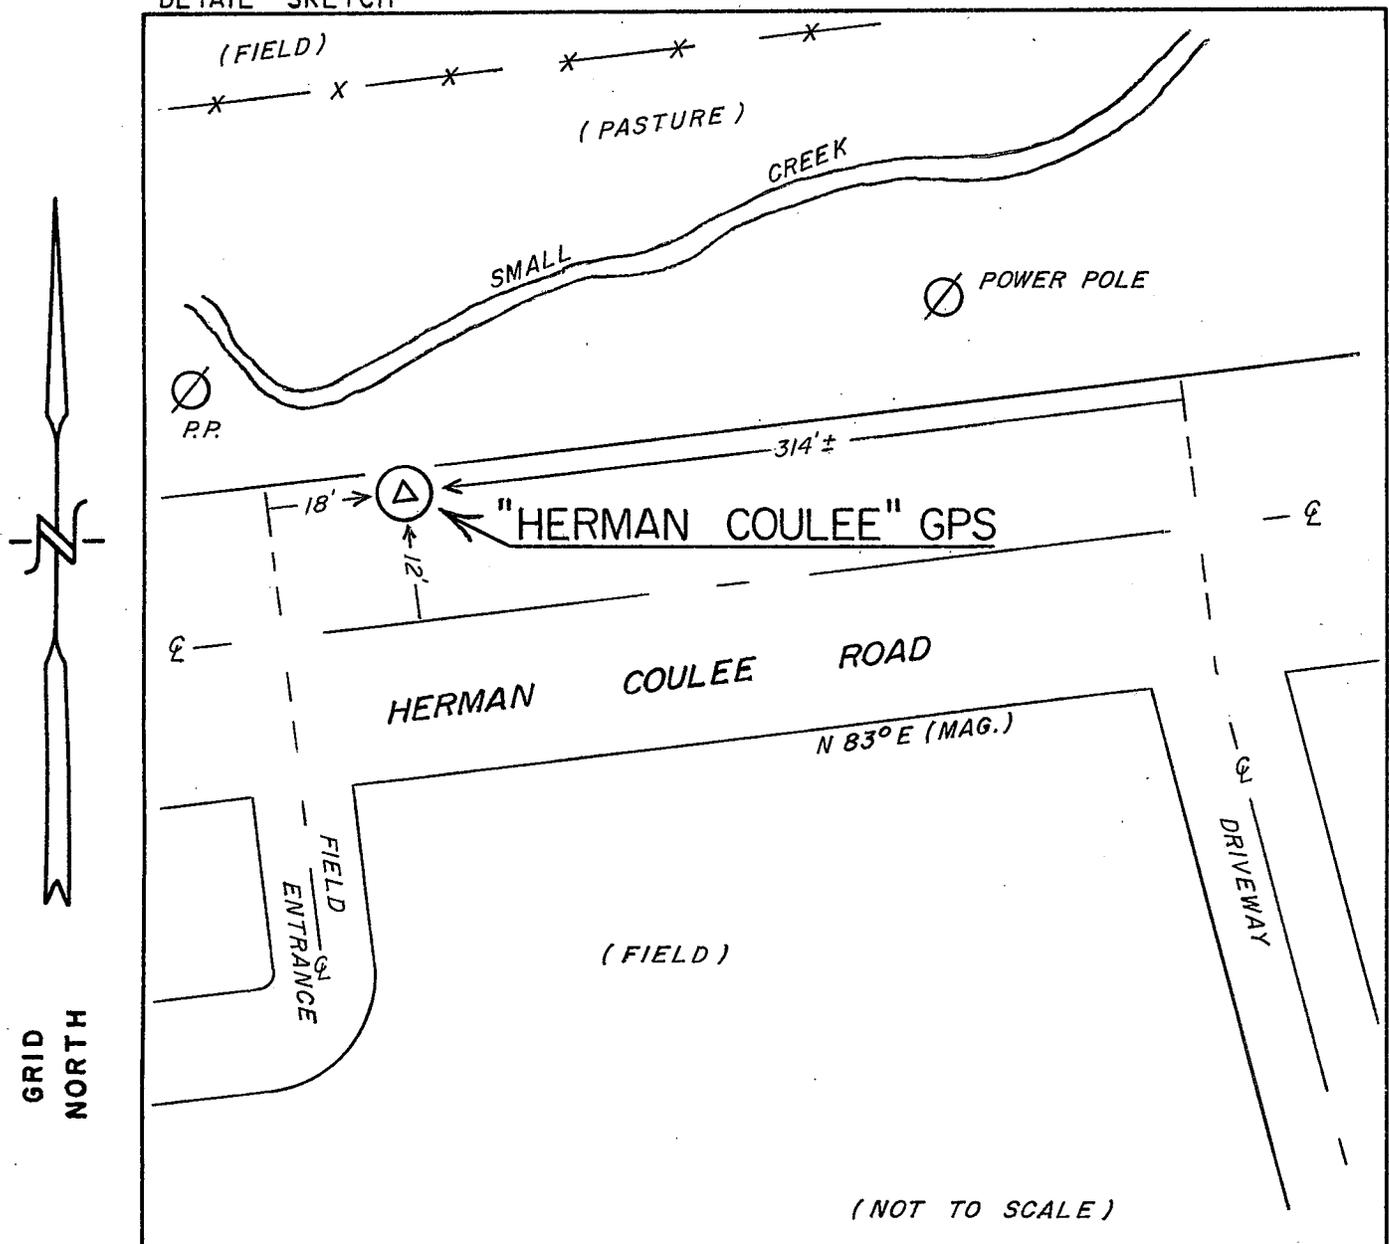

NO.	DESCRIPTION	BEARING	DISTANCE

REMARKS: _____

I, William C. Jung, County Surveyor
 HEREBY CERTIFY THAT THE MONUMENT LOCATION SHOWN
 ON THIS RECORD WAS DETERMINED UNDER MY DIRECTION
 AND CONTROL AND THAT THIS GPS/GEODETIC RECORD IS
 CORRECT AND COMPLETE TO THE BEST OF MY KNOWLEDGE
 AND BELIEF.

William C. Jung
 SIGNATURE

02/14/00
 DATE

