

G.P.S. / GEODETIC SURVEY MONUMENT RECORD


SECTION 27, T 18 N, R 8 W, CITY/TOWN/VILLAGE HOLLAND

LA CROSSE COUNTY

Lat: 43°59'57.748315 N, (.00000m)
 Lon: 91°18'40.491552 W, (.00000m)
 Ell. Hgt in m: (179.3505m), (.00000m)

SE 1/4-SEC. 27 SW 1/4-SEC. 26

LOCATION SKETCH

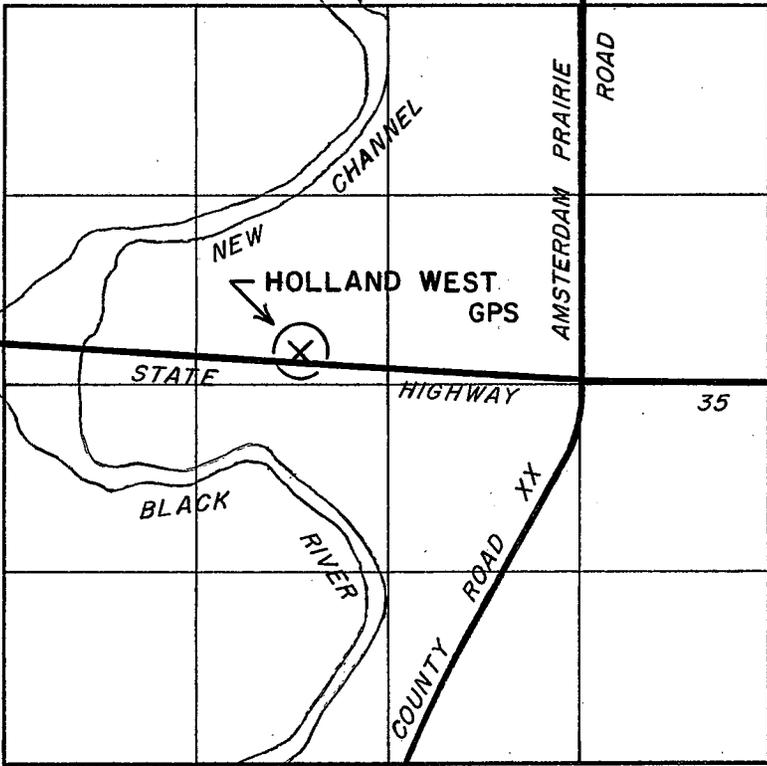

HORIZONTAL DATUM	
NAD 83(91):	
(Y)	731,443.610
(X)	1,623,469.231
NAD 27 _____:	
(Y)	_____
(X)	_____
OTHER: _____	
(Y)	_____
(X)	_____
VERTICAL DATUM	
ELEV. _____,	_____
ELEV. <u>691.8±</u> ,	<u>1929</u>
ELEV. _____,	<u>1988</u>

GPS / GEODETIC STATION DESCRIPTION


~~D.O.T. PROJECT I.D.:~~ LaCrosse Co. computer I.D.: HOLW
 STATION NAME: "HOLLAND WEST GPS" STATION NO. 188W27S
 LATITUDE: _____ LONGITUDE: _____
 LOCAL NAME: Black River East
 MONUMENT BY AGENCY: Co. Surveyor DATE: 10/04/93 TYPE: Brass cap in conc.
 SET BY: William C. Jung & Peter F. Follansbee
 MAINTENANCE RECORD: 7/17/99 OK weg
 MAINTENANCE RECORD: 6/30/04 OK weg
 MAINTENANCE RECORD: _____
 MAINTENANCE RECORD: _____
 MAINTENANCE RECORD: _____

The station is located in the Northwestern part of LaCrosse County. More easily found beginning at the intersection of State Highway 35 & County Road K in the southeastern part of the Village of Trempealeau in Trempealeau County. Then traveling east on State Hwy 35 approximately 5.8 mi. (9.3km) to the 15" x 5' concrete marker with brass cap located 64.5 Ft. (19.7m) north of the centerline on the high bank near the R/W fence.

RECORD OF DURABLE WITNESS MONUMENTS

DETAIL SKETCH

(Not to scale)

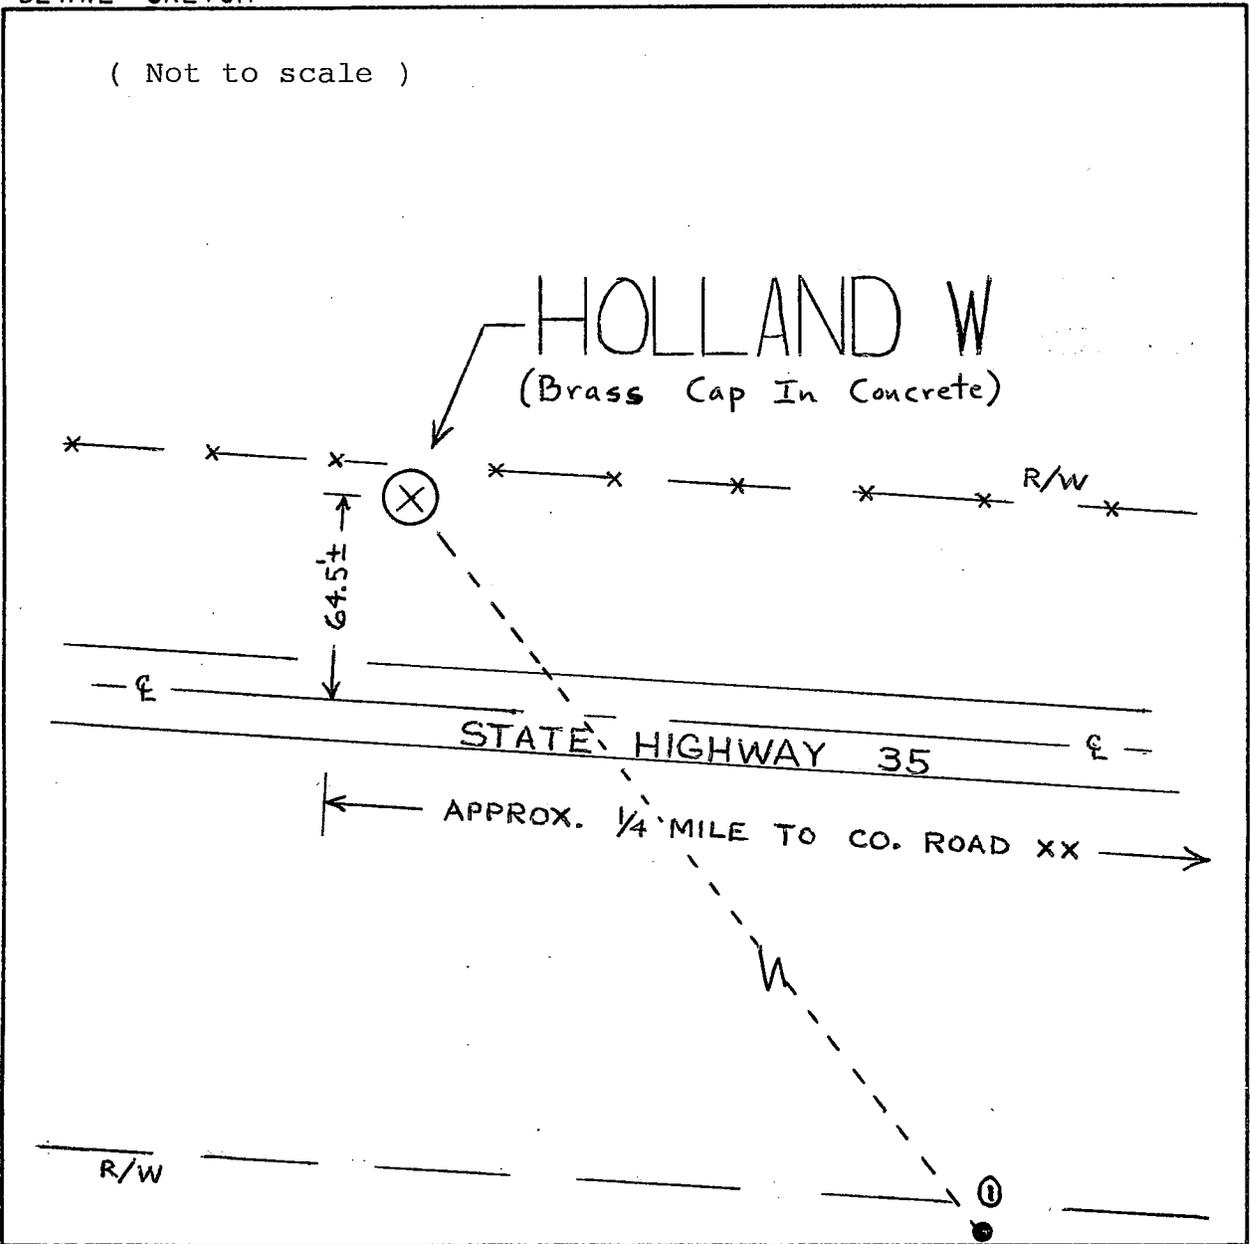

NO.	DESCRIPTION	BEARING	DISTANCE
1	Ex. I.P. @ section corner	— — —	267.99

REMARKS: _____

I, William C. Jung, County Surveyor
 HEREBY CERTIFY THAT THE MONUMENT LOCATION SHOWN
 ON THIS RECORD WAS DETERMINED UNDER MY DIRECTION
 AND CONTROL AND THAT THIS GPS/GEODETIC RECORD IS
 CORRECT AND COMPLETE TO THE BEST OF MY KNOWLEDGE
 AND BELIEF.

William C. Jung
 SIGNATURE

2/16/00
 DATE

