


G.P.S. / GEODETIC SURVEY MONUMENT RECORD

SECTION 18, T 17 N, R 6 W, CITY/TOWN/VILLAGE HAMILTON

LA CROSSE COUNTY

Lat: 43°57'02.447548 N, (+ .00340m)
 Lon: 91°08'24.522979 W, (+ .00388m)
 Ell. Hgt in m: (362.0635m), (+ .00691m)

LOCATION SKETCH

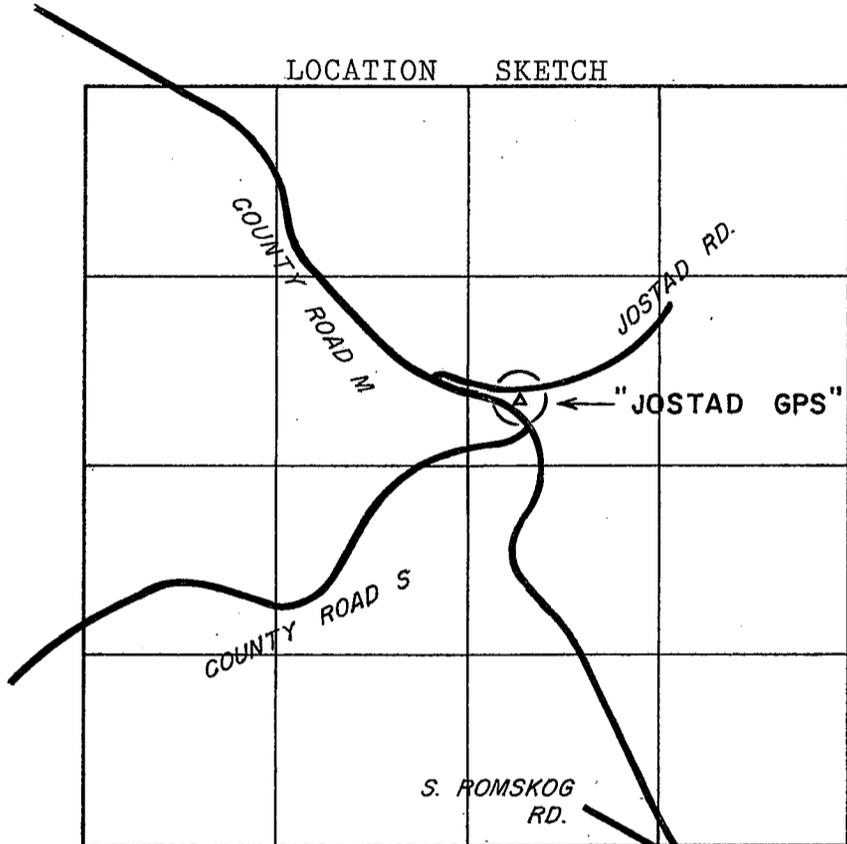

SECTION 18-17-6.

HORIZONTAL DATUM

NAD 83(91):
 (Y) 713,032.687
 (X) 1,668,245.971
 NAD 27 :
 (Y) _____
 (X) _____
 OTHER: _____
 (Y) _____
 (X) _____

VERTICAL DATUM

ELEV. 1292.903 , GPS
 ELEV. 1292.84 * , 1929
 ELEV. _____ , 1988

*Derived from level circuit from U.S.G.S. marker.


GPS / GEODETIC STATION DESCRIPTION

~~D.O.T. PROJECT I.D.:~~ LaCrosse Co. computer I.D.: JOST
 STATION NAME: "JOSTAD GPS" STATION NO. _____
 LATITUDE: _____ LONGITUDE: _____
 LOCAL NAME: _____
 MONUMENT BY AGENCY: County Surveyor DATE: 11/08/94 TYPE: Brass cap in conc.
 SET BY: William C. Jung-(County Surveyor).
 MAINTENANCE RECORD: 12/13/96 OK wcj
 MAINTENANCE RECORD: 6/7/01 OK wcj
 MAINTENANCE RECORD: 2/26/03 OK wcj
 MAINTENANCE RECORD: 5/6/05 OK wcj
 MAINTENANCE RECORD: 8/3/06 OK wcj

The station is located in the central part of LaCrosse County. More easily found beginning west of the Village of West Salem at the intersection of State Highway 16 & County Highway M. Then northwesterly along County Rd. M approximately 4.6mi (7.4km) to the intersection with Jostad Road. Then easterly along Jostad Rd. 562'± (171m) to the 12" x 3½' concrete marker with brass cap 32.5' (9.9m) south of the centerline.

RECORD OF DURABLE WITNESS MONUMENTS

DETAIL SKETCH

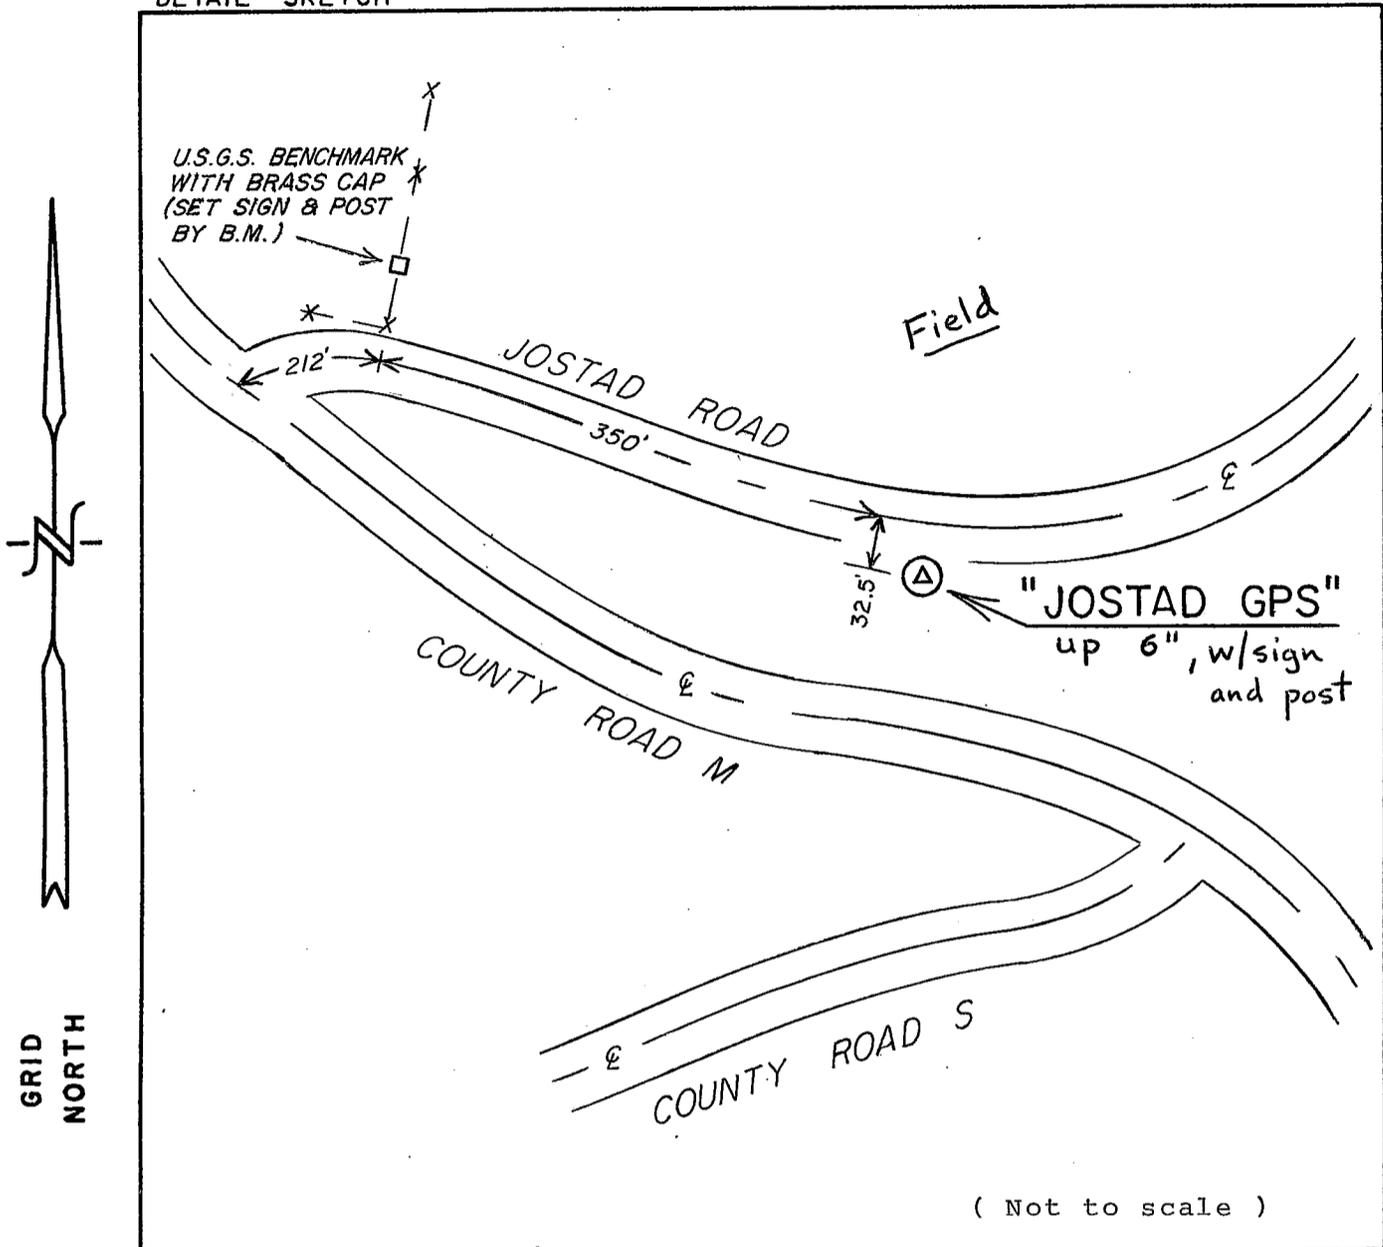

NO.	DESCRIPTION	BEARING	DISTANCE

REMARKS: Hit bedrock while digging.
(3) rebar were set in the
concrete.

I, William C. Jung, County Surveyor
 HEREBY CERTIFY THAT THE MONUMENT LOCATION SHOWN
 ON THIS RECORD WAS DETERMINED UNDER MY DIRECTION
 AND CONTROL AND THAT THIS GPS/GEODETIC RECORD IS
 CORRECT AND COMPLETE TO THE BEST OF MY KNOWLEDGE
 AND BELIEF.

William C. Jung
 SIGNATURE

3/29/00
 DATE

