


# G.P.S. / GEODETIC SURVEY MONUMENT RECORD

SECTION 6, T 17 N, R 7 W, CITY/TOWN/VILLAGE HOLLAND

LA CROSSE COUNTY

Lat: 43°59'02.027255 N, ( .00227m)  
 Lon: 91°15'19.102444 W, ( .00315m)  
 Ell. Hgt in m: (200.5985m), ( .00507m)

LOCATION SKETCH

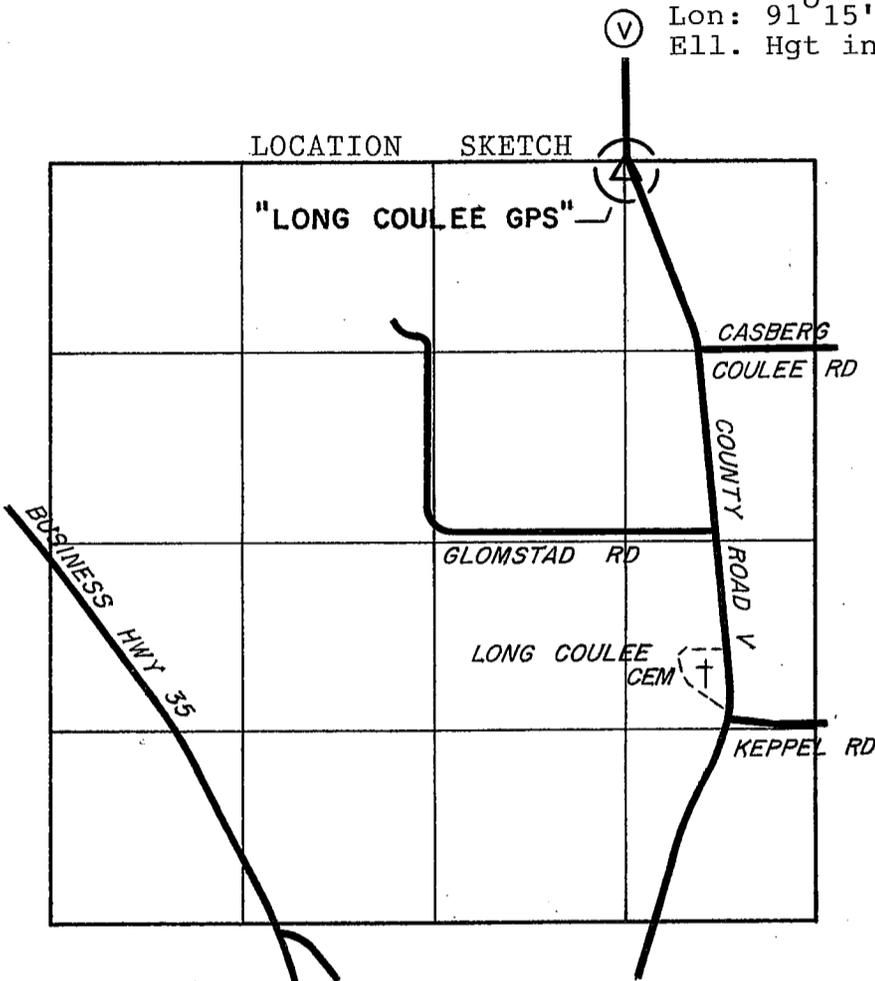

HORIZONTAL DATUM	
NAD 83(91):	
(Y)	725,575.420
(X)	1,638,103.117
NAD 27 _____:	
(Y)	_____
(X)	_____
OTHER: _____	
(Y)	_____
(X)	_____
VERTICAL DATUM	
ELEV. _____,	_____
ELEV. <u>762.0±</u> ,	<u>1929</u>
ELEV. _____,	<u>1988</u>

SECTION 6-17-7.

## GPS / GEODETIC STATION DESCRIPTION

~~D.O.T. PROJECT I.D.:~~ LaCrosse Co. computer I.D.: LONG

STATION NAME: "LONG COULEE GPS" STATION NO. \_\_\_\_\_

LATITUDE: \_\_\_\_\_ LONGITUDE: \_\_\_\_\_

LOCAL NAME: \_\_\_\_\_

MONUMENT BY AGENCY: County Surveyor DATE: 8/22/1995 TYPE: Brass cap in conc.

SET BY: William C. Jung-(County Surveyor) & Peter F. Follansbee.

MAINTENANCE RECORD: 8/30/95 OK w/cj 5/12/08 OK w/cj

MAINTENANCE RECORD: 10/31/00 OK w/cj (some chipping from mower)

MAINTENANCE RECORD: 7/23/01 OK w/cj (yellow guard post set)


MAINTENANCE RECORD: 6/7/04 OK w/cj

MAINTENANCE RECORD: 3/2/06 Fd. our yellow guard post & the DOT guard posts broken off. w/cj

The station is located in the northeastern part of La Crosse County. More easily found beginning near the center of the Village of Holmen at the intersection of County Road DH & County Road V. Then northerly along County Rd. V approximately 1.4 miles (2.3km) to the 12" x 5' concrete marker with brass cap on the west side of the road.

# RECORD OF DURABLE WITNESS MONUMENTS

DETAIL SKETCH

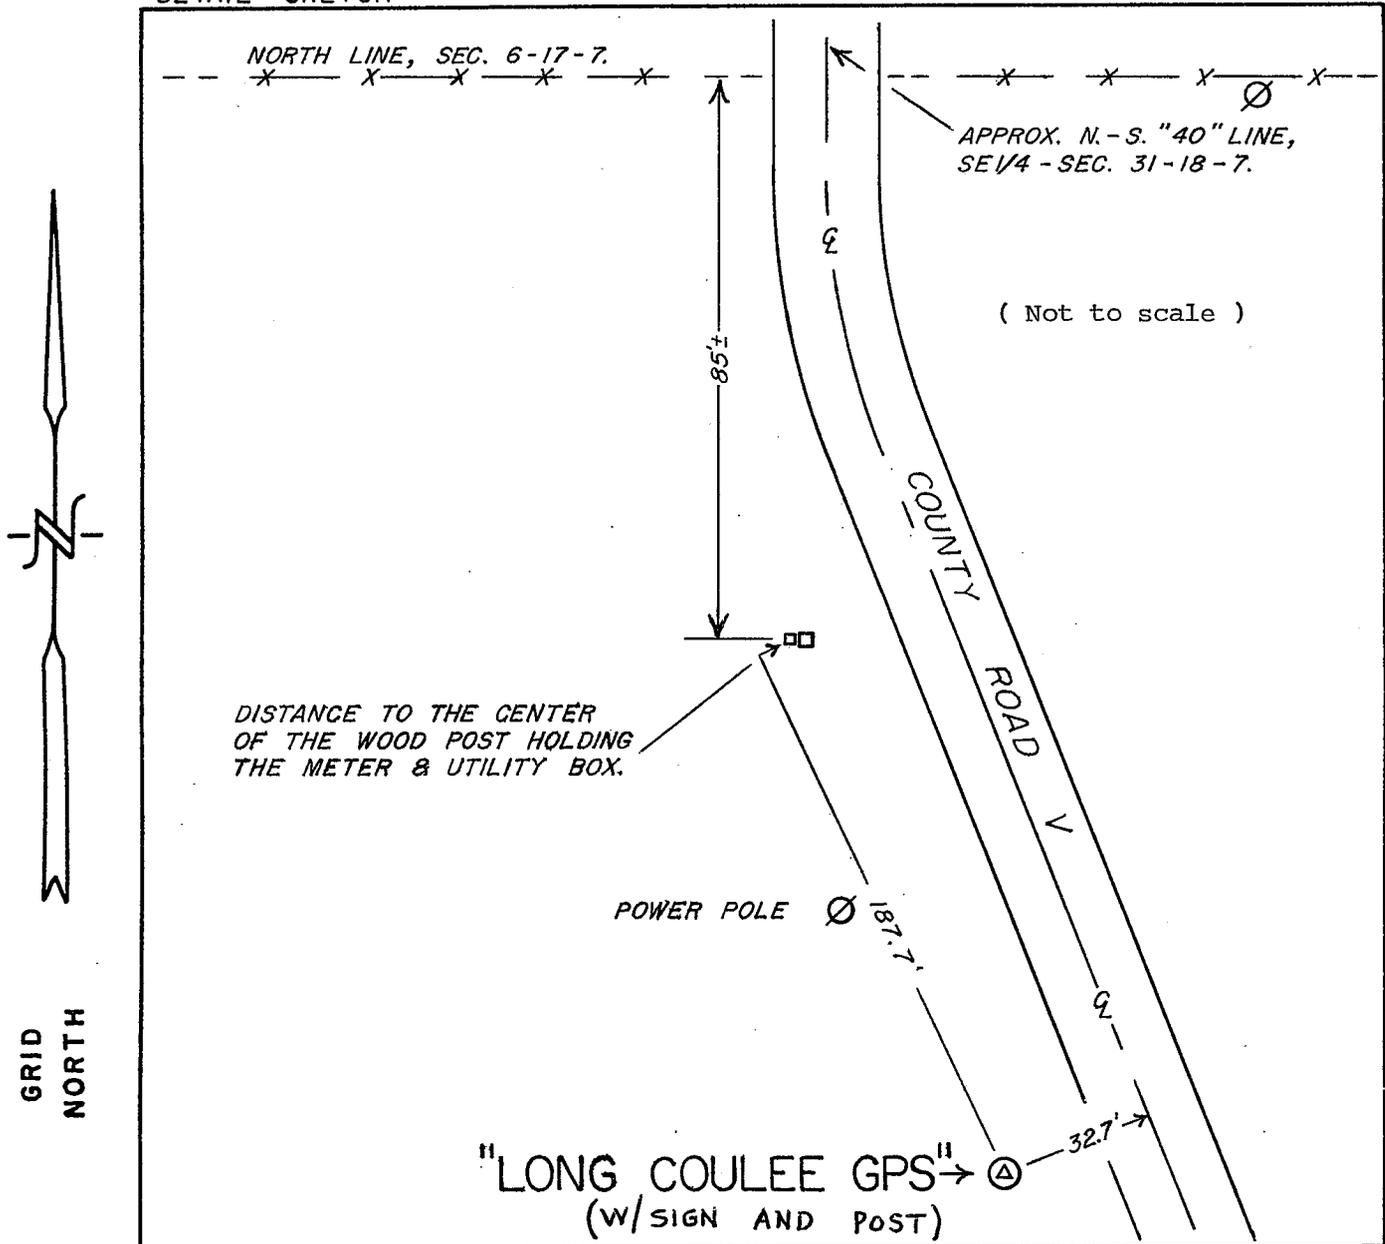

NO.	DESCRIPTION	BEARING	DISTANCE

REMARKS: \_\_\_\_\_  
 \_\_\_\_\_  
 \_\_\_\_\_  
 \_\_\_\_\_

I, William C. Jung, County Surveyor  
 HEREBY CERTIFY THAT THE MONUMENT LOCATION SHOWN  
 ON THIS RECORD WAS DETERMINED UNDER MY DIRECTION  
 AND CONTROL AND THAT THIS GPS/GEODETIC RECORD IS  
 CORRECT AND COMPLETE TO THE BEST OF MY KNOWLEDGE  
 AND BELIEF.

William C. Jung  
 SIGNATURE

3/30/00  
 DATE

