


# G.P.S. / GEODETIC SURVEY MONUMENT RECORD

SECTION 12, T 15 N, R 6 W, CITY/TOWN/VILLAGE GREENFIELD

LA CROSSE COUNTY

Lat: 43°47'51.584048 N, ( .00231m)  
 Lon: 91°02'35.152567 W, ( .00244m)  
 Ell. Hgt in m: (235.6247m), ( .00495m)

S. 1/2-SECTION 1-15-6.  
LOCATION SKETCH

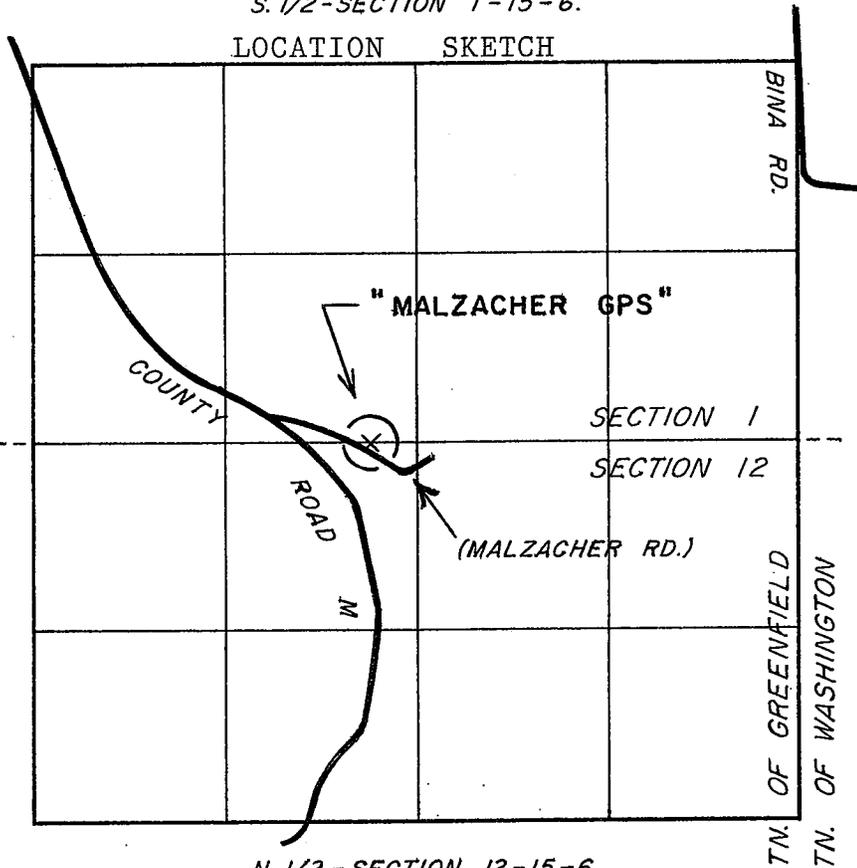

N. 1/2-SECTION 12-15-6.

HORIZONTAL DATUM	
NAD 83(91):	
(Y)	656,924.399
(X)	1,693,104.005
NAD 27 _____:	
(Y)	_____
(X)	_____
OTHER: _____	
(Y)	_____
(X)	_____
VERTICAL DATUM	
ELEV. _____,	_____
ELEV. _____,	<u>1929</u>
ELEV. _____,	<u>1988</u>


### GPS / GEODETIC STATION DESCRIPTION

~~D.O.T. PROJECT I.D.:~~ LaCrosse Co. computer I.D.: MALZ  
 STATION NAME: "MALZACHER GPS" STATION NO. \_\_\_\_\_  
 LATITUDE: \_\_\_\_\_ LONGITUDE: \_\_\_\_\_  
 LOCAL NAME: \_\_\_\_\_  
 MONUMENT BY AGENCY: County Surveyor DATE: 10/25/94 TYPE: Brass cap in conc.  
 SET BY: William C. Jung (County Surveyor) & Peter F. Follansbee  
 MAINTENANCE RECORD: 10/25/96 OK wej  
 MAINTENANCE RECORD: 4/11/00 OK wej  
 MAINTENANCE RECORD: \_\_\_\_\_  
 MAINTENANCE RECORD: \_\_\_\_\_  
 MAINTENANCE RECORD: \_\_\_\_\_

The station is located in the south-central part of LaCrosse County. More easily found beginning on the **WEST** side of the unincorporated area known as St. Joseph at the intersection of State Highway 33 & County Road M. Then traveling northerly along County Rd. M 1.0mi (1.6km) to the intersection with Malzacher Road. Then southeasterly along Malzacher Rd. approximately 450 Ft. (137m) to the 12" x 5' concrete marker with brass cap along the north side of the road.

# RECORD OF DURABLE WITNESS MONUMENTS

DETAIL SKETCH

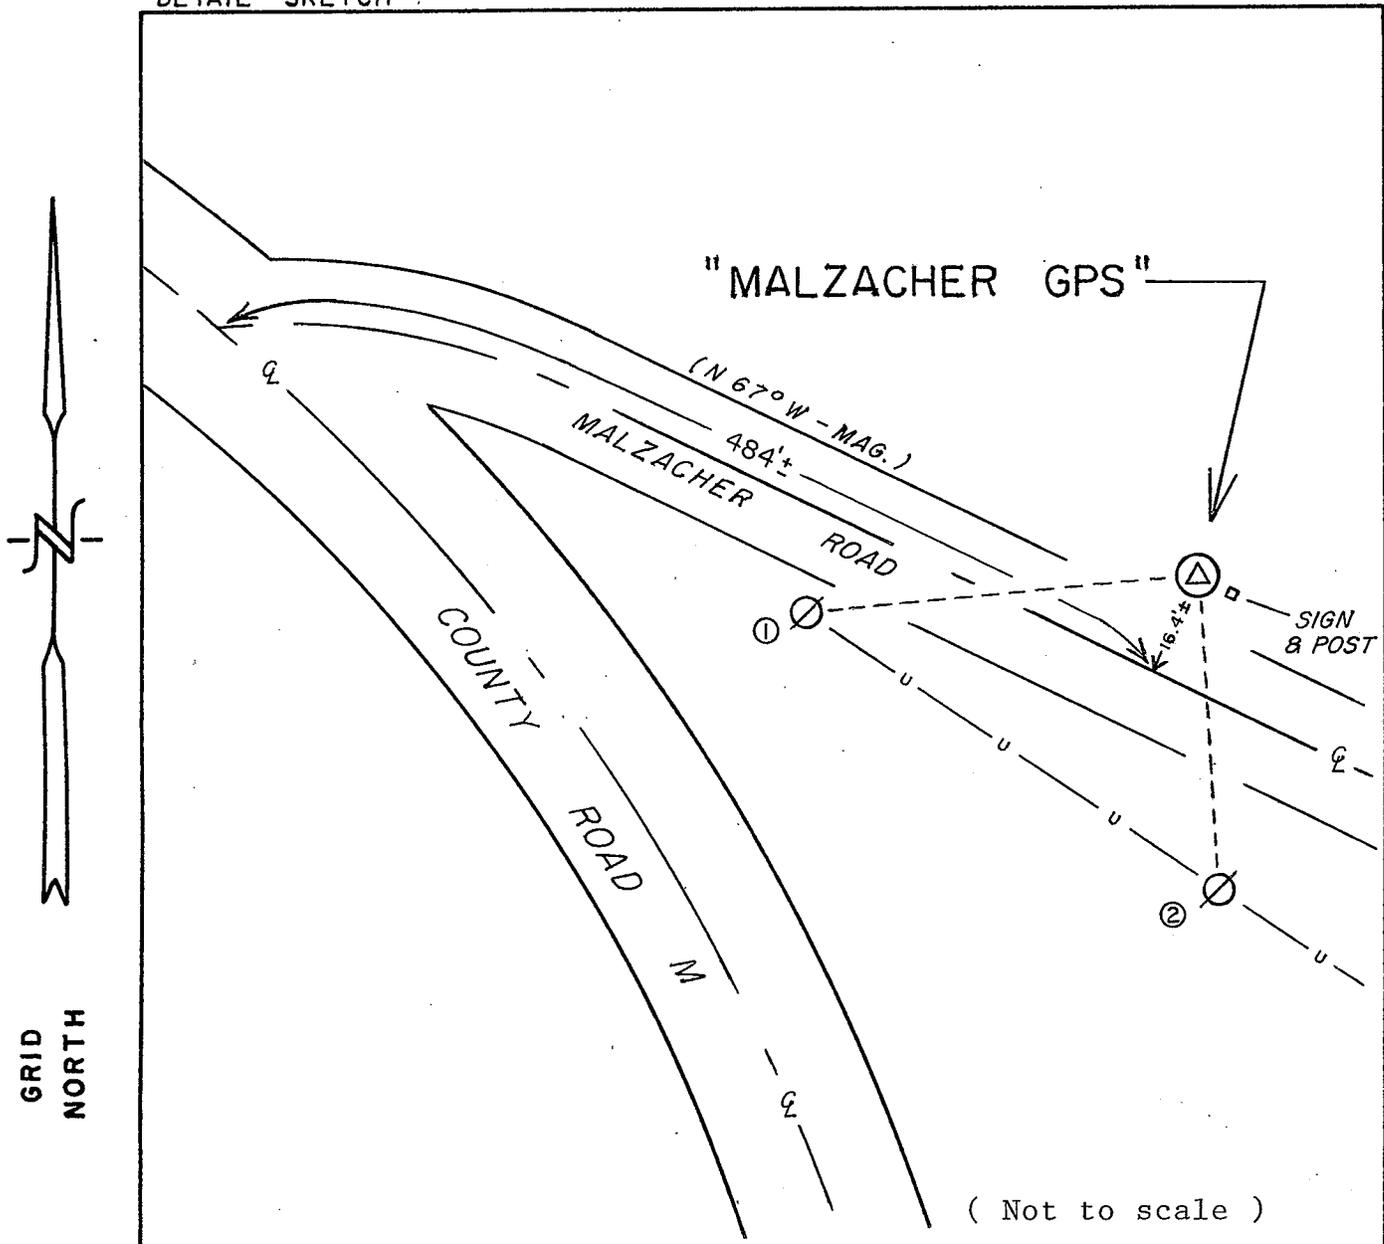

NO.	DESCRIPTION	BEARING	DISTANCE
1	Center of Power Pole	Westerly ±	Sl.=115.4'
2	Center of Power Pole	Southerly ±	Sl.=106.9'

REMARKS: \_\_\_\_\_  
 \_\_\_\_\_  
 \_\_\_\_\_  
 \_\_\_\_\_

I, William C. Jung, County Surveyor  
 HEREBY CERTIFY THAT THE MONUMENT LOCATION SHOWN  
 ON THIS RECORD WAS DETERMINED UNDER MY DIRECTION  
 AND CONTROL AND THAT THIS GPS/GEODETIC RECORD IS  
 CORRECT AND COMPLETE TO THE BEST OF MY KNOWLEDGE  
 AND BELIEF.

William C. Jung  
 SIGNATURE

3/29/00  
 DATE

