


# G.P.S. / GEODETIC SURVEY MONUMENT RECORD

SECTION 31 , T 16 N, R 5 W, CITY/TOWN/VILLAGE BANGOR

LA CROSSE COUNTY

Lat: 43°49'10.30025 N, (0.000m)  
 Lon: 91°01'12.17228 W, (0.000m)  
 Ell. Hgt in m: (214.135m), (0.001m)

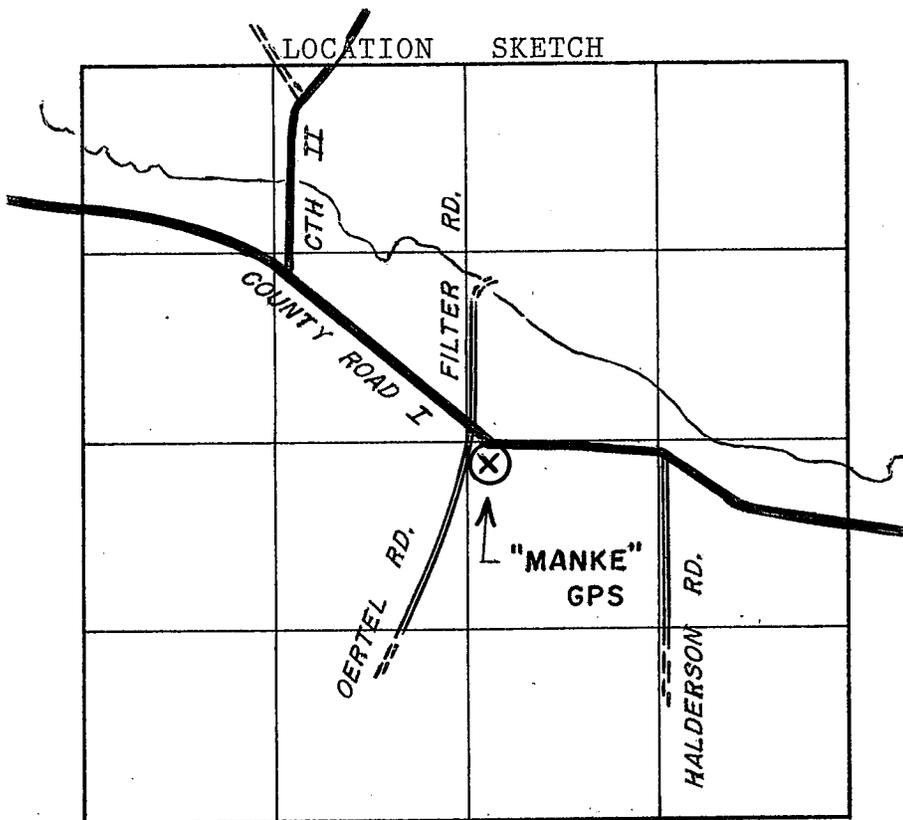

SECTION 31-16-5.

HORIZONTAL DATUM	
NAD 83(91):	
(Y)	664,818.820
(X)	1,699,286.815
NAD 27 :	
(Y)	_____
(X)	_____
OTHER: _____	
(Y)	_____
(X)	_____
VERTICAL DATUM	
ELEV.	_____
ELEV.	808.7 ± , 1929
ELEV.	_____ , 1988

## GPS / GEODETIC STATION DESCRIPTION

~~D.O.T. PROJECT I.D.:~~ LaCrosse Co. computer I.D.: MANK

STATION NAME: "MANKE" GPS STATION NO. \_\_\_\_\_

LATITUDE: 43°49'10.30025 N, LONGITUDE: 91°01'12.17228 W

LOCAL NAME: "MANKE" GPS (TT 21 MT 1946)

MONUMENT BY AGENCY: County Surveyor DATE: 7/24/2000 TYPE: Brass cap in conc. USGS

SET BY: RESET by William C. Jung & Peter E. Follansbee 7/24/2000

MAINTENANCE RECORD: OK 9/27/05 awg

MAINTENANCE RECORD: OK 10/19/06 awg

MAINTENANCE RECORD: OK 3/29/07 awg

MAINTENANCE RECORD: \_\_\_\_\_


MAINTENANCE RECORD: \_\_\_\_\_

The station is located northwest of the unincorporated area known as Newberg Corners in the Town of Bangor. More easily found beginning 1.0 mi. (1.6km) northwesterly of Newberg Corners at the intersection of State Highway "33" and County Road "I". Then northwesterly along County Road "I", approx. 3.30 mi. (5.3 km) near the center of Section 31, T16N, R5W to the 7" square x 30" concrete marker with brass cap is located 36 ft. (10.97 m) south of centerline on top of the ditch backslope.

which

# RECORD OF DURABLE WITNESS MONUMENTS

DETAIL SKETCH

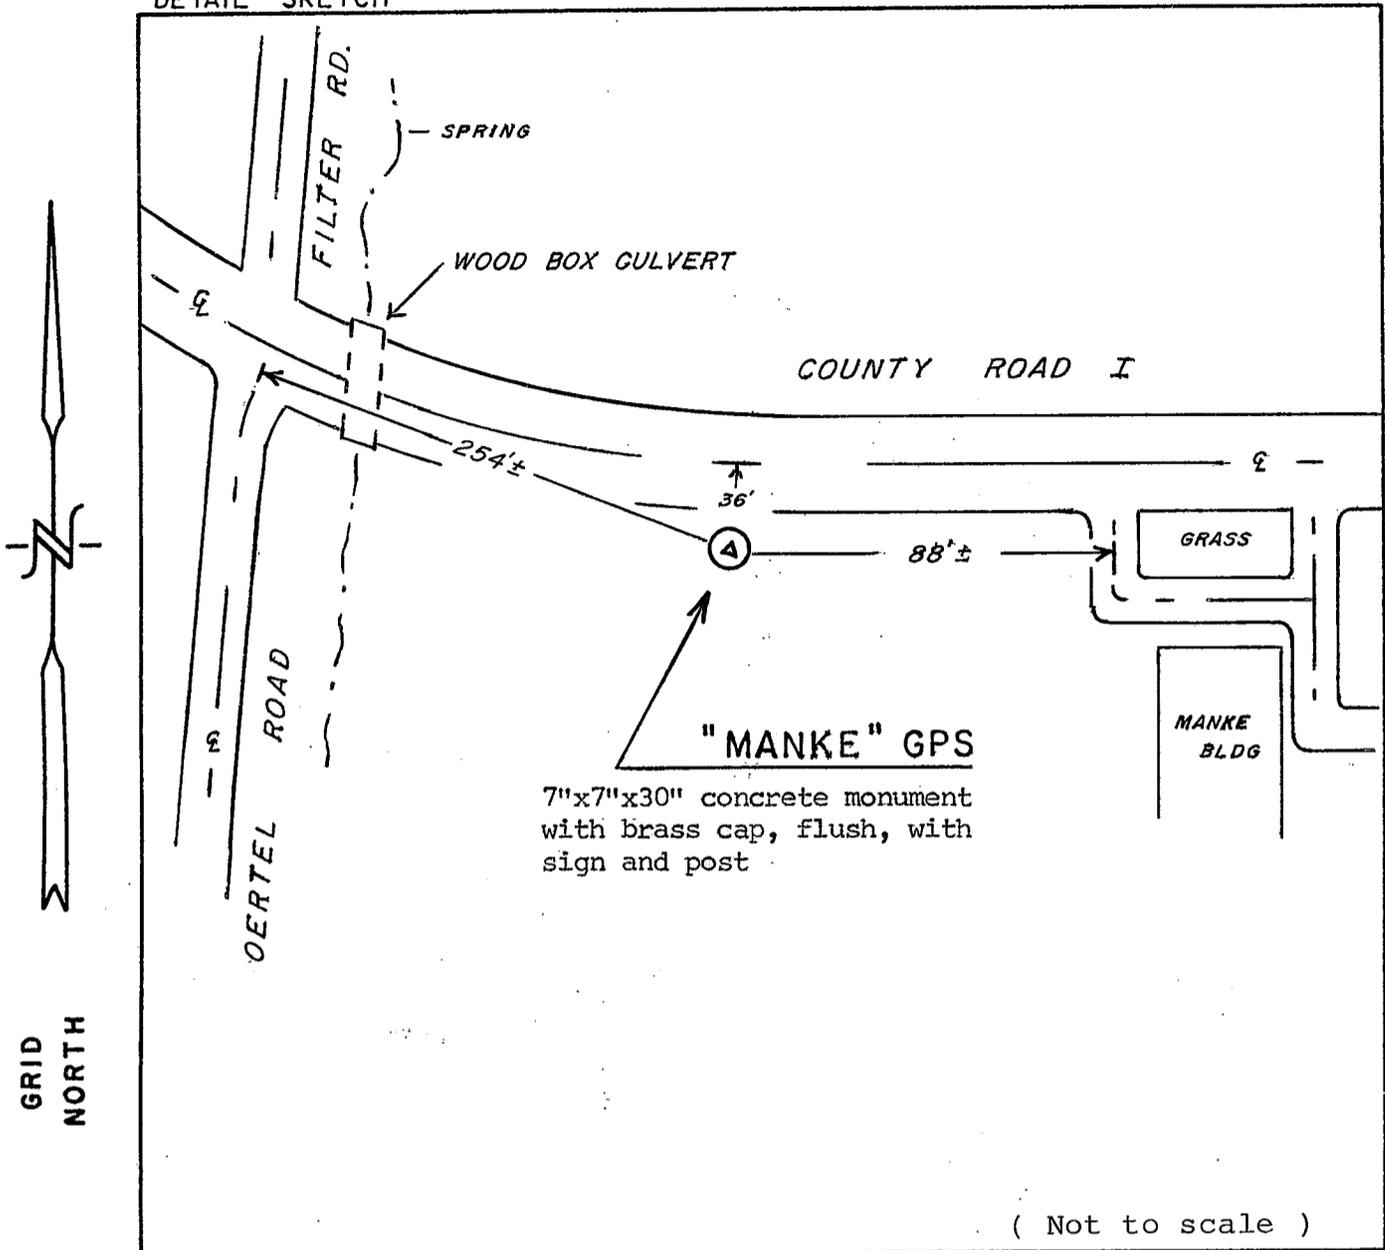

NO.	DESCRIPTION	BEARING	DISTANCE

REMARKS: The 1946 monument was knocked out during road maintenance.  
The monument was set at a different location and elevation.  
Restamped 809.

I, William C. Jung, County Surveyor  
 HEREBY CERTIFY THAT THE MONUMENT LOCATION SHOWN  
 ON THIS RECORD WAS DETERMINED UNDER MY DIRECTION  
 AND CONTROL AND THAT THIS GPS/GEODETIC RECORD IS  
 CORRECT AND COMPLETE TO THE BEST OF MY KNOWLEDGE  
 AND BELIEF.

William C. Jung  
 SIGNATURE

11/17/00  
 DATE

