


G.P.S. / GEODETIC SURVEY MONUMENT RECORD

SECTION 10, T 15 N, R 5 W, CITY/TOWN/VILLAGE WASHINGTON

LA CROSSE COUNTY

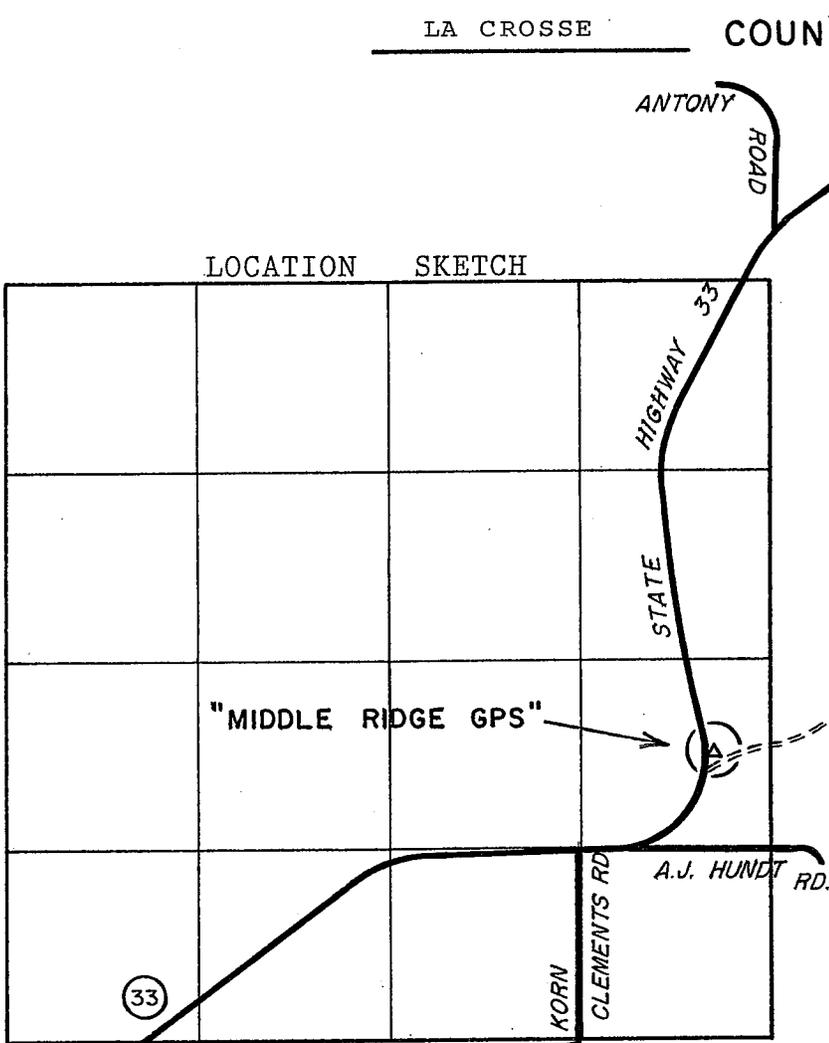

HORIZONTAL DATUM	
NAD 83(91):	
(Y)	653,318.009
(X)	1,716,988.225
NAD 27 _____:	
(Y)	_____
(X)	_____
OTHER: _____	
(Y)	_____
(X)	_____
VERTICAL DATUM	
ELEV.	_____
ELEV.	1343.3 ±, 1929
ELEV.	_____, 1988

SECTION 10-15-5. Lat: 43°47'18.791529 N, (.00242m)
 Lon: 90°57'08.948111 W, (.00252m)
 Ell. Hgt in m: (376.8844m), (.00485m)

GPS / GEODETIC STATION DESCRIPTION

D.O.T. PROJECT I.D.: LaCrosse Co. computer I.D.: MIDD

STATION NAME: "MIDDLE RIDGE GPS" STATION NO. _____

LATITUDE: _____ LONGITUDE: _____

LOCAL NAME: _____

MONUMENT BY AGENCY: County Surveyor DATE: 10/20/94 TYPE: Brass cap in conc.

SET BY: William C. Jung-(County Surveyor) & Peter F. Follansbee

MAINTENANCE RECORD: 6/18/97 OK weg

MAINTENANCE RECORD: 10/22/03 OK weg

MAINTENANCE RECORD: 4/15/04 weg Monument is "chipped". Hit by snowplow? Or mower?


MAINTENANCE RECORD: 9/15/05 weg

MAINTENANCE RECORD: 8/5/08 weg

The station is located in the southeastern part of LaCrosse County. More easily found beginning at the unincorporated area known as Middle Ridge at the intersection of State Highway 33 & County Road G. Then southwesterly along State Hwy 33 0.98mi. (1.57km) to the 12" x 5' concrete marker with brass cap on the east side of the highway.

RECORD OF DURABLE WITNESS MONUMENTS

DETAIL SKETCH

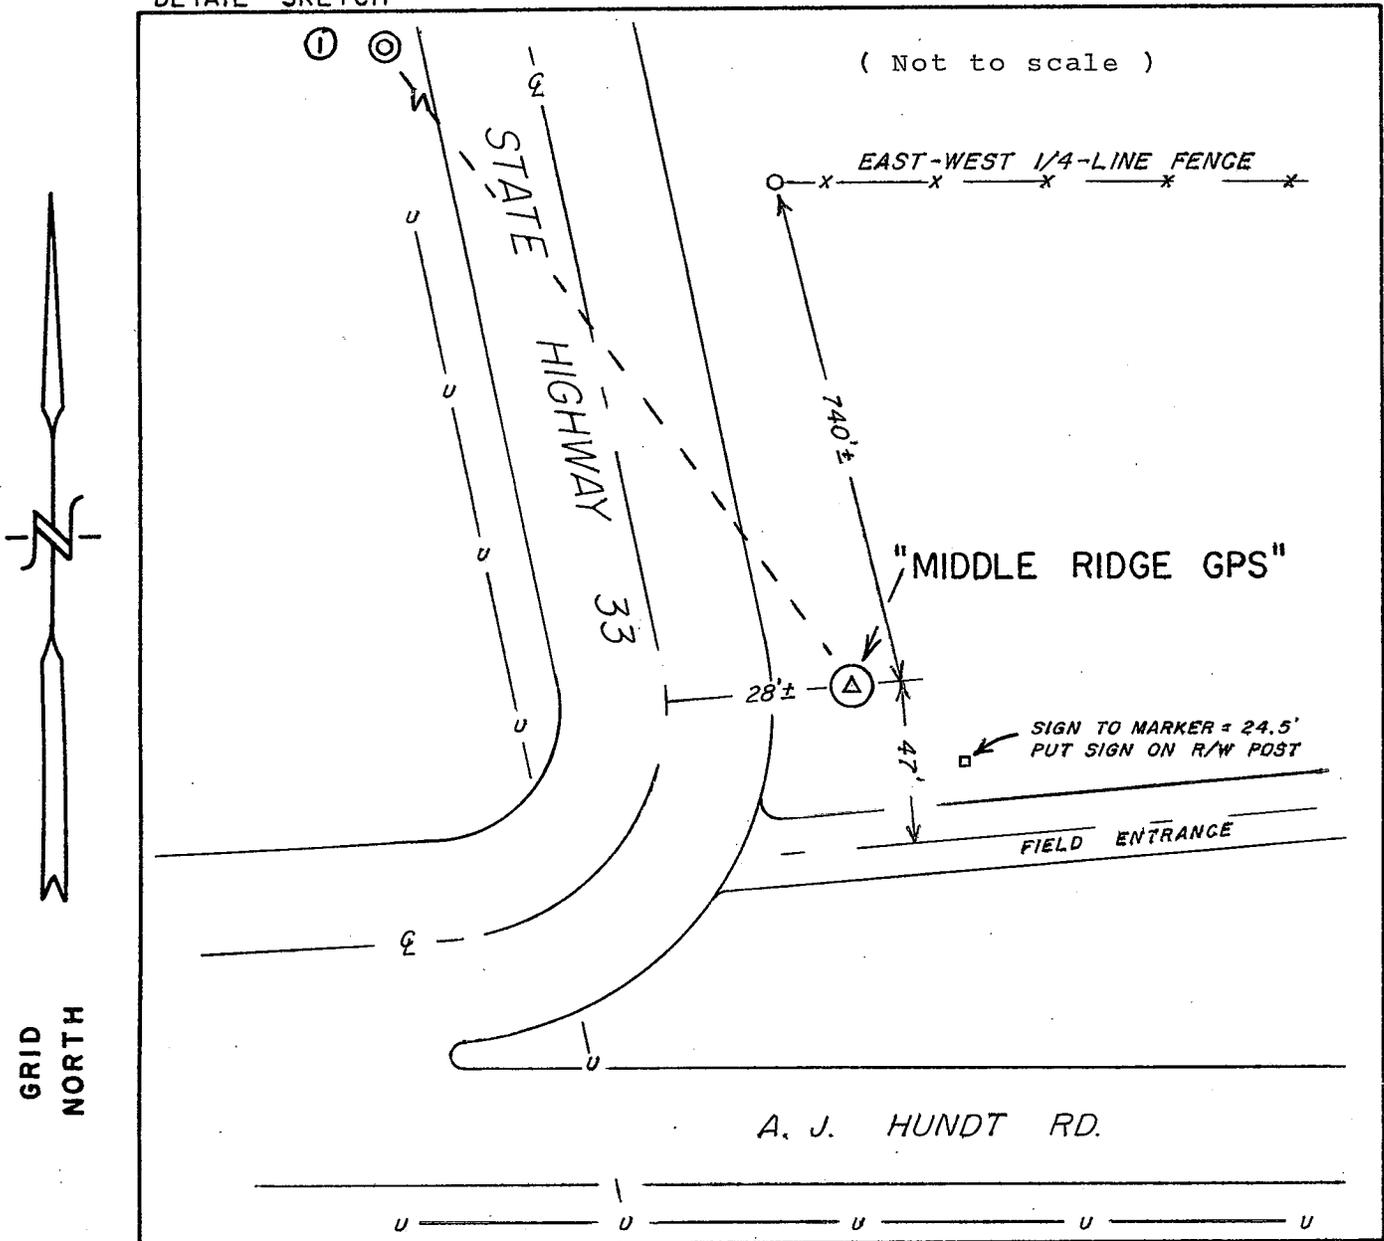

NO.	DESCRIPTION	BEARING	DISTANCE
1	DOT Berntsen Aluminum Top, "Middle", 1987	S10°02'40" E	1923,936'

REMARKS: _____

I, William C. Jung, County Surveyor
 HEREBY CERTIFY THAT THE MONUMENT LOCATION SHOWN
 ON THIS RECORD WAS DETERMINED UNDER MY DIRECTION
 AND CONTROL AND THAT THIS GPS/GEODETIC RECORD IS
 CORRECT AND COMPLETE TO THE BEST OF MY KNOWLEDGE
 AND BELIEF.

William C. Jung
 SIGNATURE

3/3/00
 DATE

