


G.P.S. / GEODETIC SURVEY MONUMENT RECORD

SECTION 24, T 18 N, R 7 W, CITY/TOWN/VILLAGE FARMINGTON

LA CROSSE COUNTY

Lat: 44°01'16.118367 N, (.00275m)
 Lon: 91°09'32.702517 W, (.00290m)
 Ell. Hgt in m: (206.6137m), (.00505m)

LOCATION SKETCH

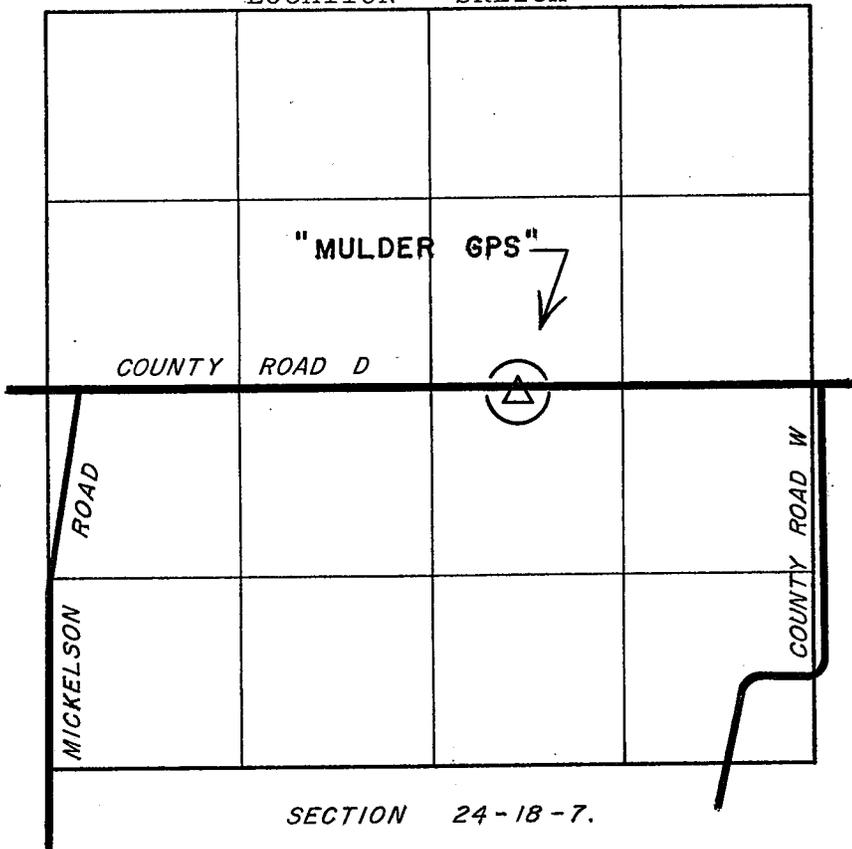

HORIZONTAL DATUM	
NAD 83(91):	
(Y)	<u>738,785.549</u>
(X)	<u>1,663,615.853</u>
NAD 27 :	
(Y)	_____
(X)	_____
OTHER: _____	
(Y)	_____
(X)	_____
VERTICAL DATUM	
ELEV.	_____
ELEV.	<u>782.7 ±</u> , <u>1929</u>
ELEV.	_____, <u>1988</u>

GPS / GEODETIC STATION DESCRIPTION

D.O.T. PROJECT I.D.: LaCrosse Co. computer I.D.: MULD

STATION NAME: "MULDER GPS" STATION NO. _____

LATITUDE: _____ LONGITUDE: _____

LOCAL NAME: _____

MONUMENT BY AGENCY: County Surveyor DATE: 8/23/1995 TYPE: Brass cap in conc.

SET BY: William C. Jung-(County Surveyor) & Peter F. Follansbee.

MAINTENANCE RECORD: 12/13/96 OK weg

MAINTENANCE RECORD: 10/27/05 OK weg

MAINTENANCE RECORD: _____


MAINTENANCE RECORD: _____

MAINTENANCE RECORD: _____

The station is located in the north-central part of La Crosse County. More easily found beginning at the unincorporated area known as Mindoro at the intersection of State Highway 108 & County Road D. Then traveling west along County Rd. D 2.9 miles (4.7km) to the 12" x 5' concrete marker with brass cap on the south side of the roadway.

RECORD OF DURABLE WITNESS MONUMENTS

DETAIL SKETCH

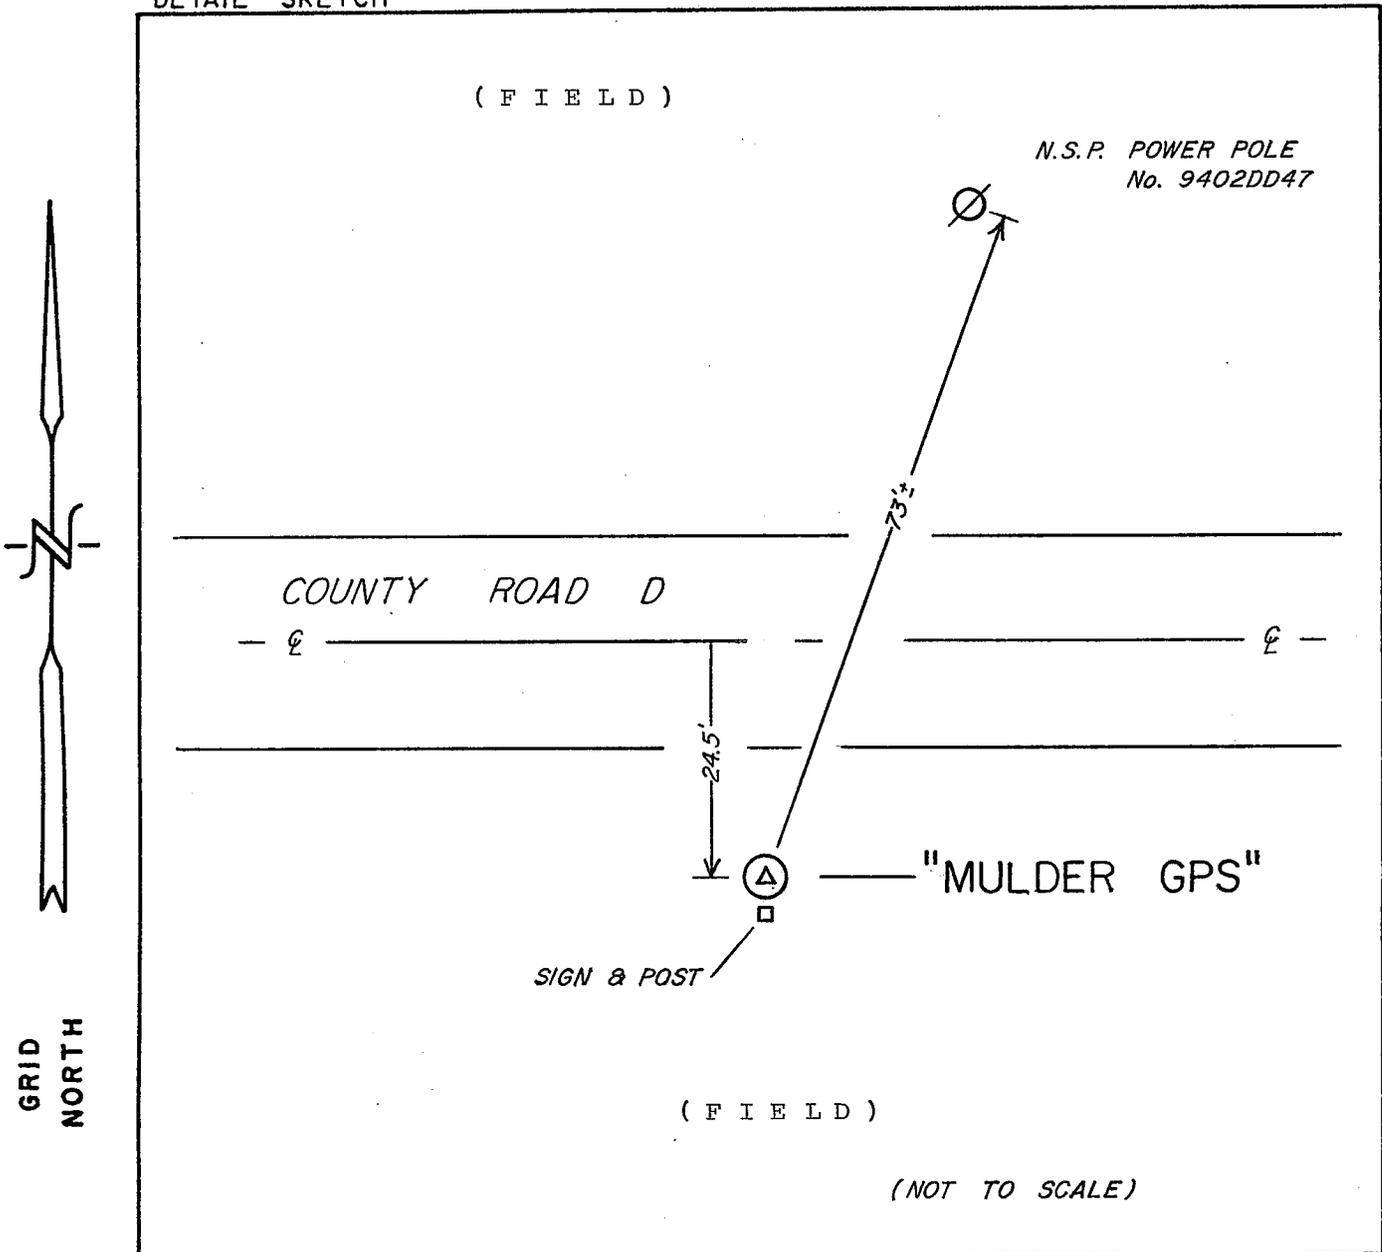

NO.	DESCRIPTION	BEARING	DISTANCE

REMARKS: _____

I, William C. Jung, County Surveyor
 HEREBY CERTIFY THAT THE MONUMENT LOCATION SHOWN
 ON THIS RECORD WAS DETERMINED UNDER MY DIRECTION
 AND CONTROL AND THAT THIS GPS/GEODETIC RECORD IS
 CORRECT AND COMPLETE TO THE BEST OF MY KNOWLEDGE
 AND BELIEF.

William C. Jung 3/29/00
 SIGNATURE DATE

