


# G.P.S. / GEODETIC SURVEY MONUMENT RECORD

SECTION 10, T 17 N, R 7 W, CITY/TOWN/VILLAGE ONALASKA

LA CROSSE COUNTY

Lat: 43°58'13.987508 N, (± .00000m)  
 Lon: 91°12'37.779346 W, (± .00000m)  
 Ell. Hgt in m: (195.9088m), (± .00000m)

LOCATION SKETCH

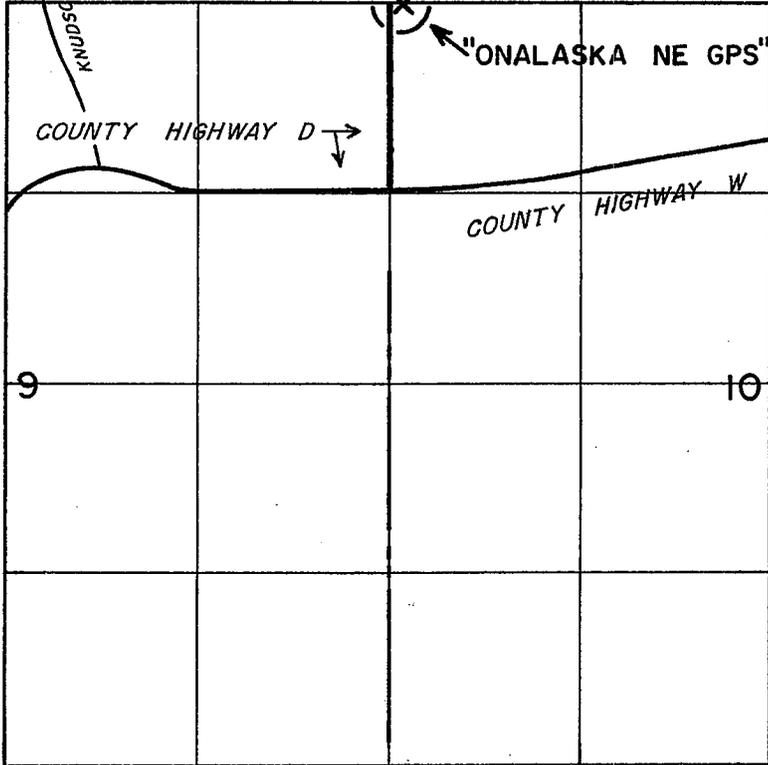

E. 1/2 - SEC. 9-17-7.

W. 1/2 - SEC. 10-17-7.

HORIZONTAL DATUM

NAD 83(91):

(Y) 720,537.081

(X) 1,649,826.182

NAD 27:

(Y) \_\_\_\_\_

(X) \_\_\_\_\_

OTHER: \_\_\_\_\_

(Y) \_\_\_\_\_

(X) \_\_\_\_\_

VERTICAL DATUM

ELEV. \_\_\_\_\_,

ELEV. 747.1±, 1929

ELEV. \_\_\_\_\_, 1988

GPS / GEODETIC STATION DESCRIPTION

D.O.T. PROJECT I.D.: LaCrosse Co. computer I.D.: ONAL

STATION NAME: "Onalaska NE GPS" STATION NO. 177W10S

LATITUDE: \_\_\_\_\_ LONGITUDE: \_\_\_\_\_

LOCAL NAME: Halfway Creek

MONUMENT BY AGENCY: County Surveyor DATE: 10/01/93 TYPE: Brass Cap in Conc.

SET BY: William C. Jung & Peter F. Follansbee

MAINTENANCE RECORD: 12/12/96 OK wcy

MAINTENANCE RECORD: 9/2/04 OK wcy

MAINTENANCE RECORD: 7/21/06 OK wcy


MAINTENANCE RECORD: 7/9/08 OK wcy

MAINTENANCE RECORD: \_\_\_\_\_

The station is located east of the Village of Holmen beginning at the intersection of County Hwy DH & County Hwy D. Then traveling 2.45 mi. East on Co. Hwy D to the intersection with Co Hwy W. Then 0.25 mi. North on Co. Hwy D to the 15" x 5' concrete marker with brass cap located on top of the bank east of the road and 36.96 Ft. east of a Berntsen monument located in the centerline marking the NW-Corner of Section 10-17-7. (2.45mi. = 3.94km, 0.25mi. = 0.40km)

# RECORD OF DURABLE WITNESS MONUMENTS

DETAIL SKETCH

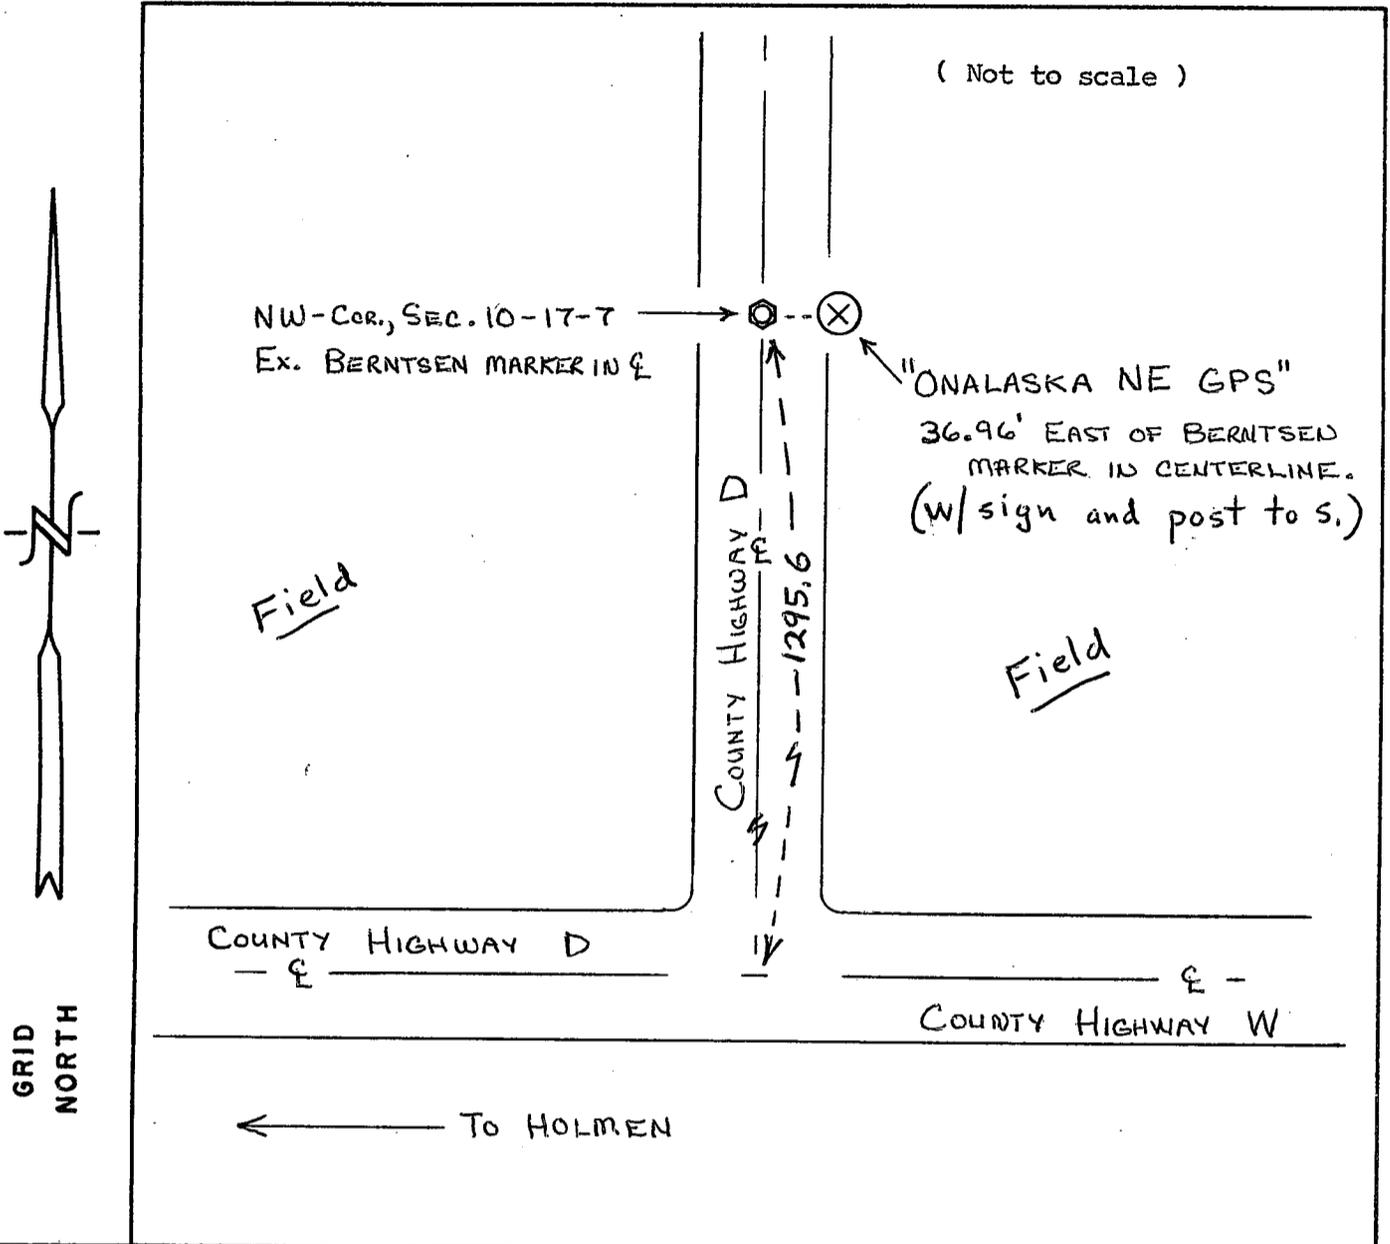

NO.	DESCRIPTION	BEARING	DISTANCE

REMARKS: \_\_\_\_\_  
 \_\_\_\_\_  
 \_\_\_\_\_  
 \_\_\_\_\_

I, William C. Jung, County Surveyor  
 HEREBY CERTIFY THAT THE MONUMENT LOCATION SHOWN  
 ON THIS RECORD WAS DETERMINED UNDER MY DIRECTION  
 AND CONTROL AND THAT THIS GPS/GEODETIC RECORD IS  
 CORRECT AND COMPLETE TO THE BEST OF MY KNOWLEDGE  
 AND BELIEF.

William C. Jung  
 SIGNATURE

3/24/00  
 DATE

