

# G.P.S. / GEODETIC SURVEY MONUMENT RECORD


SECTION 13, T 15 N, R 5 W, CITY/TOWN/VILLAGE WASHINGTON

LA CROSSE COUNTY

Lat: 43°46'07.648844 N, ( .00262m)  
 Lon: 90°54'50.307236 W, ( .00322m)  
 Ell. Hgt in m: (270.9500m), ( .00527m)

S. 1/2-SECTION 13-15-5.

LOCATION SKETCH

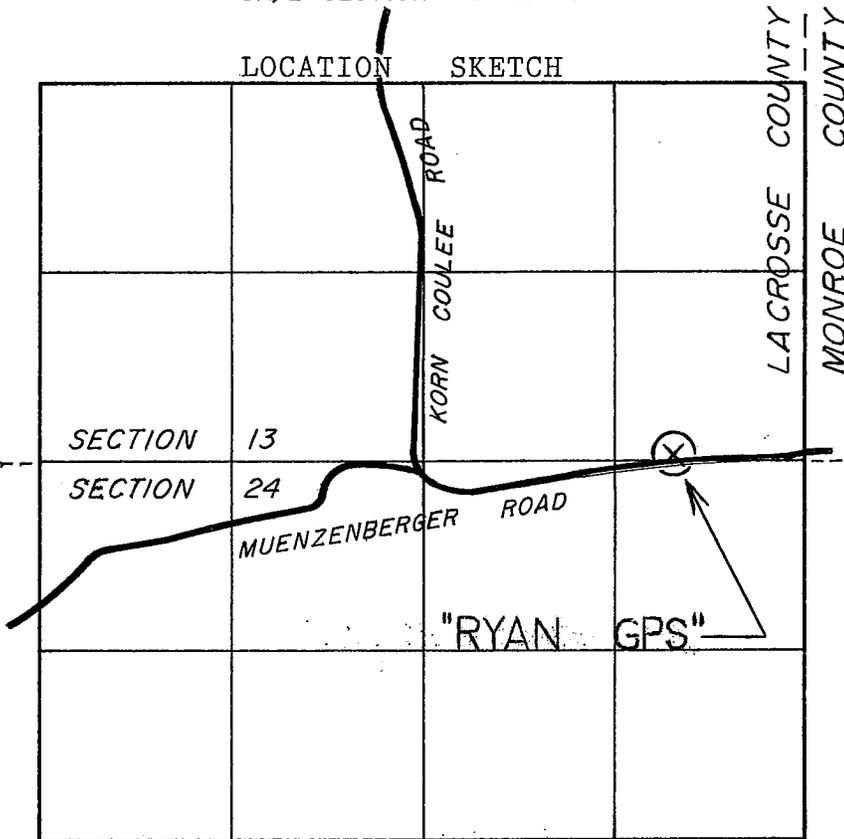

N. 1/2-SECTION 24-15-5.

HORIZONTAL DATUM	
NAD 83(91):	
(Y)	646,001.240
(X)	1,727,078.102
NAD 27:	
(Y)	_____
(X)	_____
OTHER: _____	
(Y)	_____
(X)	_____
VERTICAL DATUM	
ELEV.	_____
ELEV.	996.2±, 1929
ELEV.	_____, 1988

## GPS / GEODETIC STATION DESCRIPTION

D.O.T. PROJECT I.D.: LaCrosse Co. computer I.D.: RYAN

STATION NAME: "RYAN GPS" STATION NO. \_\_\_\_\_

LATITUDE: \_\_\_\_\_ LONGITUDE: \_\_\_\_\_

LOCAL NAME: \_\_\_\_\_

MONUMENT BY AGENCY: County Surveyor DATE: 10/24/94 TYPE: Brass cap in conc.

SET BY: William C. Jung-(County Surveyor) & Peter F. Follansbee

MAINTENANCE RECORD: 7/20/95 OK weg

MAINTENANCE RECORD: 4/19/04 OK weg

MAINTENANCE RECORD: 8/5/08 OK weg


MAINTENANCE RECORD: \_\_\_\_\_

MAINTENANCE RECORD: \_\_\_\_\_

The station is located in the southeastern part of LaCrosse County near the east County Line. More easily found beginning at the unincorporated area known as Middle Ridge at the intersection of State Highway 33 & County Road G. Then southerly along County Rd. G 2.8mi. (4.5km) to the intersection with Muenzenberger Road. Then traveling easterly along Muenzenberger Rd. 1.8mi. (2.8km) to the 12" x 5' concrete marker with brass cap near the fence on the north side of the road.

# RECORD OF DURABLE WITNESS MONUMENTS

DETAIL SKETCH

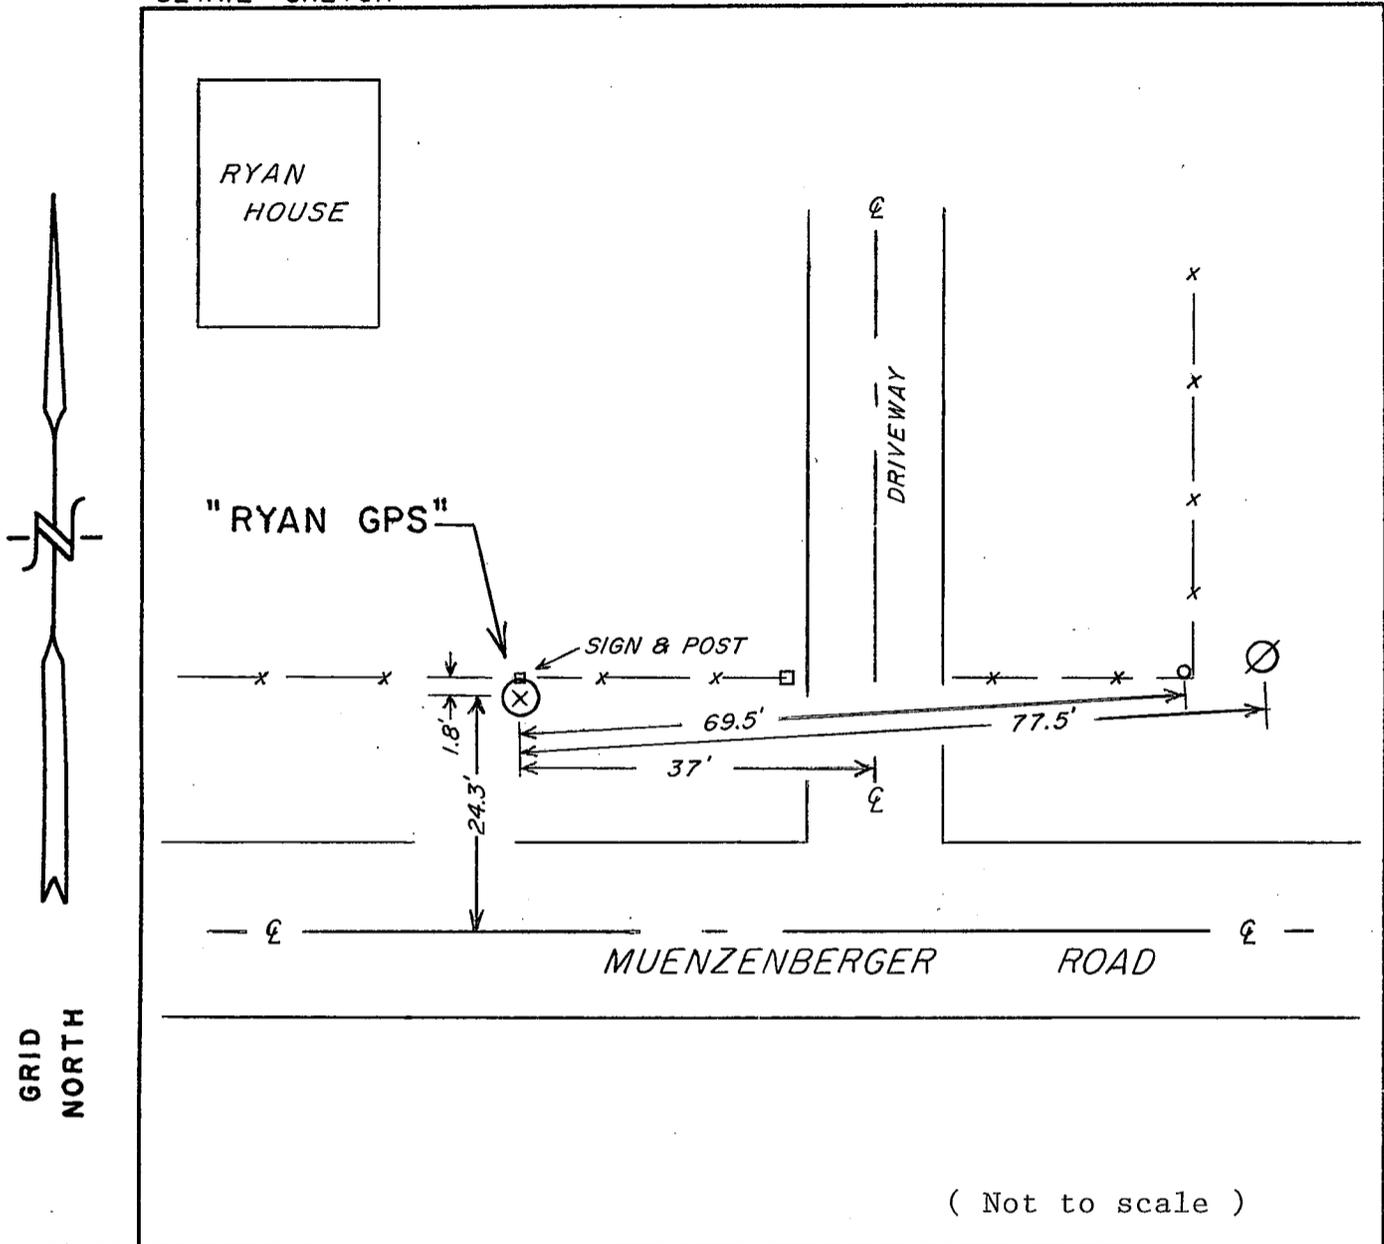

( Not to scale )

NO.	DESCRIPTION	BEARING	DISTANCE
1	Center of post at the end of the fence.	East $\pm$	69.5' $\pm$
2	Center of power pole.	East $\pm$	77.5' $\pm$
3	Centerline of the driveway.	East $\pm$	37' $\pm$

REMARKS: \_\_\_\_\_  
 \_\_\_\_\_  
 \_\_\_\_\_  
 \_\_\_\_\_

I, William C. Jung, County Surveyor  
 HEREBY CERTIFY THAT THE MONUMENT LOCATION SHOWN  
 ON THIS RECORD WAS DETERMINED UNDER MY DIRECTION  
 AND CONTROL AND THAT THIS GPS/GEODETIC RECORD IS  
 CORRECT AND COMPLETE TO THE BEST OF MY KNOWLEDGE  
 AND BELIEF.

William C. Jung  
 SIGNATURE

3/30/00  
 DATE

