


G.P.S. / GEODETIC SURVEY MONUMENT RECORD

SECTION 5, T 17 N, R 5 W, CITY/TOWN/VILLAGE BURNS

La Crosse COUNTY

Lat: 43°58'19.01647 N, (.002m)
 Lon: 91°00'09.74810 W, (.002m)
 Ell. Hgt. in m: (378.942m), (.004m)

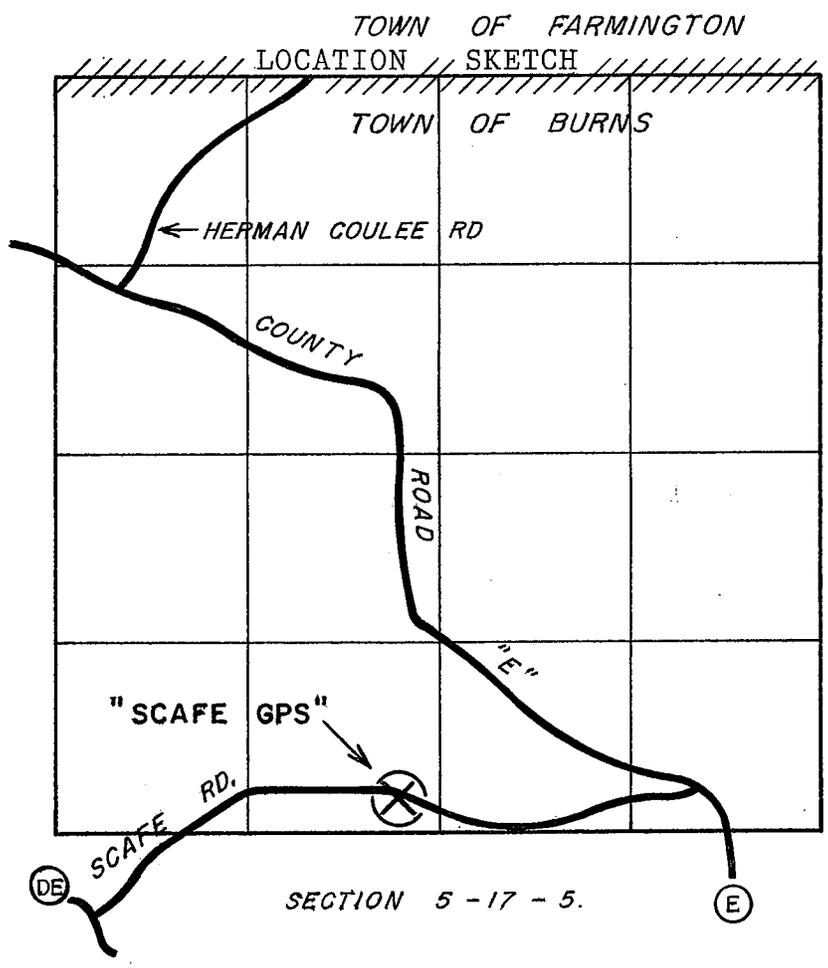

HORIZONTAL DATUM	
NAD 83(91):	
(Y)	720,320.344
(X)	1,704,531.103
NAD 27 _____:	
(Y)	_____
(X)	_____
OTHER: _____	
(Y)	_____
(X)	_____
VERTICAL DATUM	
ELEV. _____,	_____
ELEV. _____,	<u>1929</u>
ELEV. _____,	<u>1988</u>

GPS / GEODETIC STATION DESCRIPTION

D.O.T. PROJECT I.D.: LaCrosse Co. computer I.D.: SCAF

STATION NAME: "SCAFE GPS" STATION NO. _____

LATITUDE: _____ LONGITUDE: _____

LOCAL NAME: _____

MONUMENT BY AGENCY: Lax Co. Surveyor DATE: 9/08/1995 TYPE: I.P. over brass cap.

SET BY: William C. Jung-(County Surveyor) & Peter F. Follansbee

MAINTENANCE RECORD: 12/14/99 OK wcf

MAINTENANCE RECORD: _____

MAINTENANCE RECORD: _____


MAINTENANCE RECORD: _____

MAINTENANCE RECORD: _____

The station is located in the northeastern part of LaCrosse County. More easily found beginning northeasterly of the Village of West Salem at the intersection of State Highway 16 & County Road DE. Then northerly along County Rd. DE approximately 4.44 miles (7.15 km) to the top of the hill and the intersection with Scafe Road. Then easterly along Scafe Rd. 0.44 miles (0.71 km) to the 1" Iron Pipe in the roadway.

RECORD OF DURABLE WITNESS MONUMENTS

DETAIL SKETCH

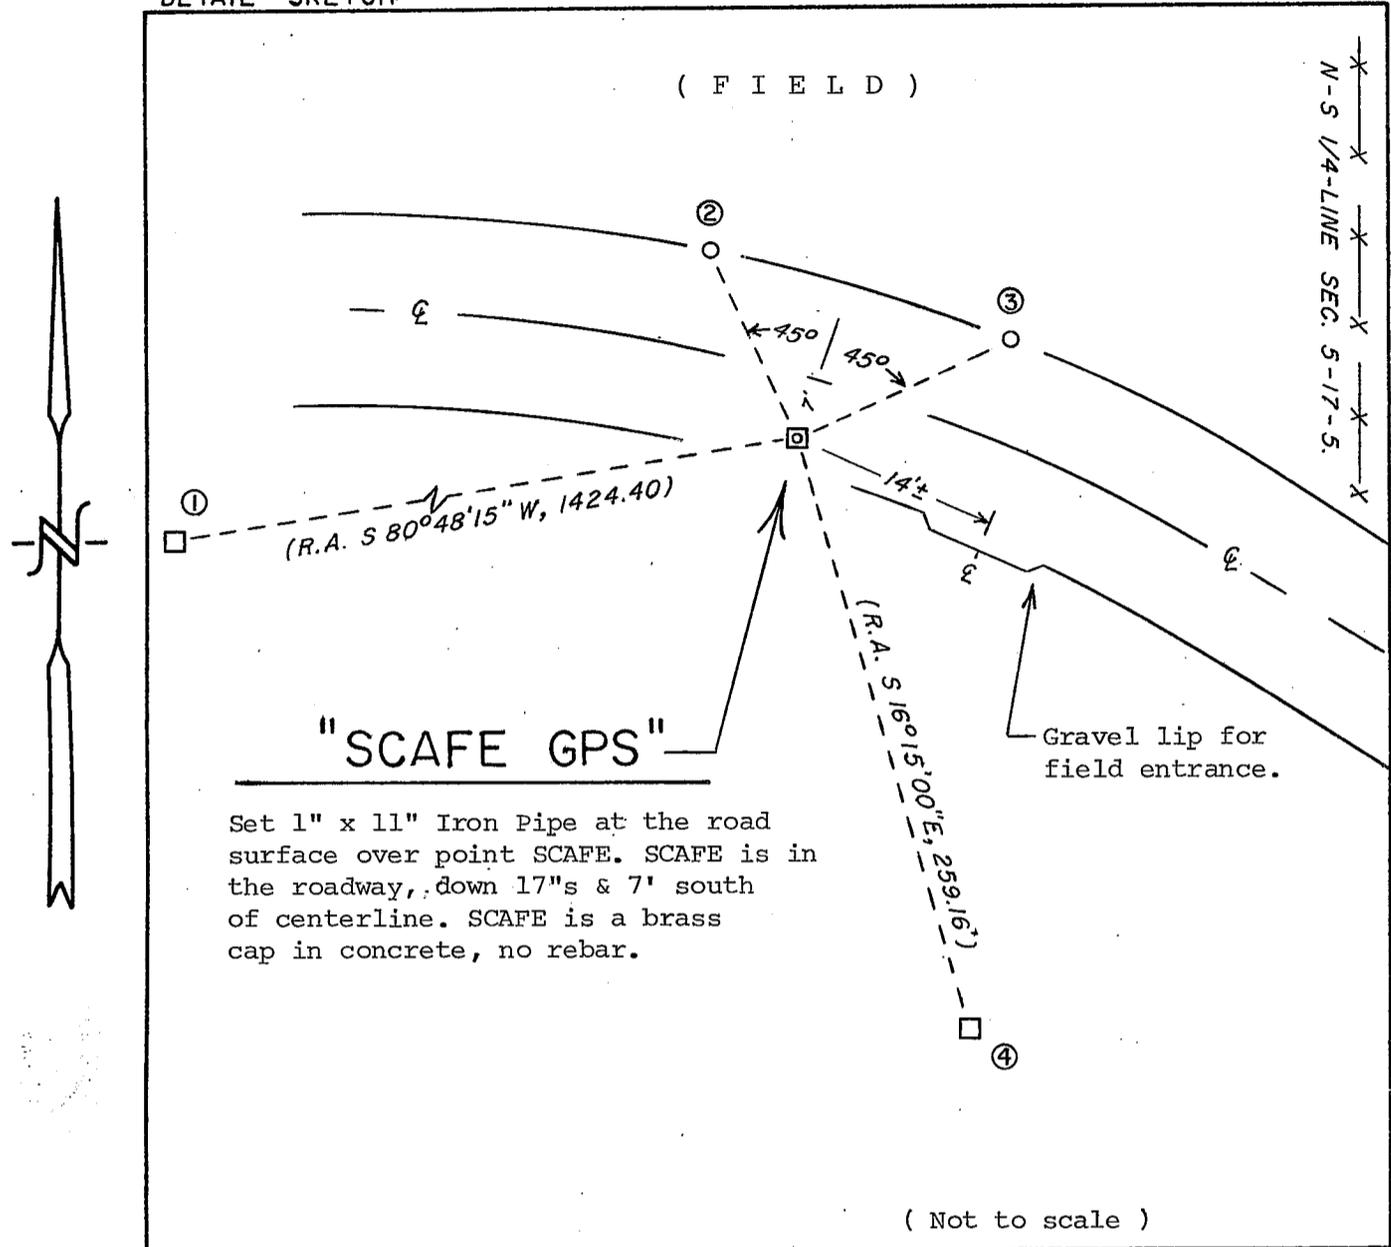

NO.	DESCRIPTION	BEARING	DISTANCE
1	Scafe No. 2 (Reference marker) brass cap in concr.	S 80°54'38" W(Tr.)	1422.39 Ft.
2	Set roundhead bolt on edge of roadway	Northwesterly +	23.77 Ft.
3	Set roundhead bolt on edge of roadway	Northeasterly +	25.32 Ft.
4	Scafe No. 1 (Reference marker) brass cap in concr.	S 16°15'00" E(Tr.)	258.78 Ft.

REMARKS: _____

I, William C. Jung, County Surveyor
 HEREBY CERTIFY THAT THE MONUMENT LOCATION SHOWN
 ON THIS RECORD WAS DETERMINED UNDER MY DIRECTION
 AND CONTROL AND THAT THIS GPS/GEODETIC RECORD IS
 CORRECT AND COMPLETE TO THE BEST OF MY KNOWLEDGE
 AND BELIEF.

William C. Jung
 SIGNATURE

2/14/00
 DATE

