


G.P.S. / GEODETIC SURVEY MONUMENT RECORD

SECTION 28, T 15 N, R 6 W, CITY/TOWN/VILLAGE GREENFIELD

LA CROSSE COUNTY

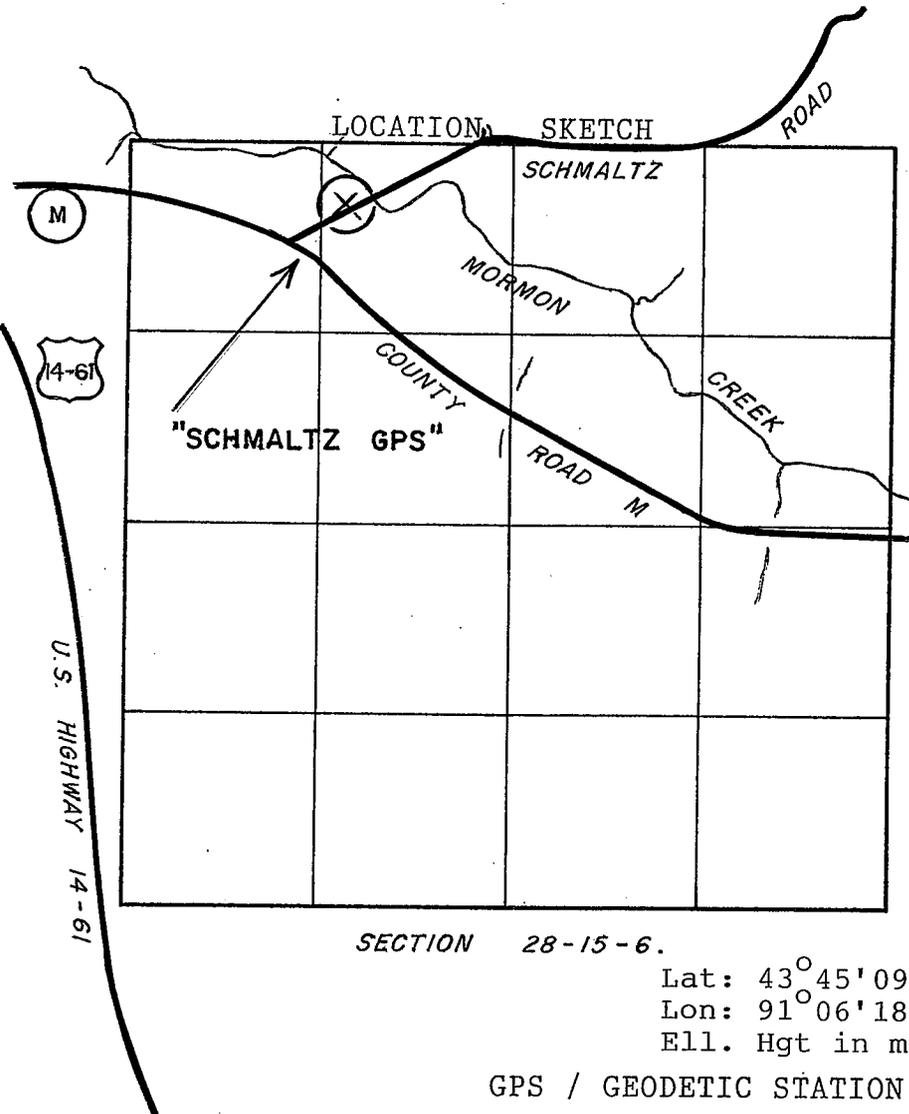

HORIZONTAL DATUM	
NAD 83(91):	
(Y)	640,712.123
(X)	1,676,540.060
NAD 27 :	
(Y)	_____
(X)	_____
OTHER: _____	
(Y)	_____
(X)	_____
VERTICAL DATUM	
ELEV.	_____
ELEV.	<u>749.9 ±</u> , <u>1929</u>
ELEV.	_____, <u>1988</u>

SECTION 28-15-6.

Lat: 43°45'09.373225-N, (.00272m)
 Lon: 91°06'18.054709 W, (.00282m)
 Ell. Hgt in m: (196.5016m), (.00460m)

GPS / GEODETIC STATION DESCRIPTION

D.O.T. PROJECT I.D.: LaCrosse Co. computer I.D.: SCHM

STATION NAME: "SCHMALTZ GPS" STATION NO. _____

LATITUDE: _____ LONGITUDE: _____

LOCAL NAME: _____

MONUMENT BY AGENCY: County Surveyor DATE: 10/19/94 TYPE: Brass cap in concr.


SET BY: William C. Jung-(County Surveyor) & Peter F. Follansbee

MAINTENANCE RECORD:	12/29/99	OK	<u>weg</u>
MAINTENANCE RECORD:	4/16/04	OK	<u>weg</u>
MAINTENANCE RECORD:	10/18/04	OK	<u>weg</u>
MAINTENANCE RECORD:	7/31/07	OK	<u>weg</u>
MAINTENANCE RECORD:	_____		

The station is located in the south-central part of LaCrosse County. More easily found beginning near the south side of the City of LaCrosse at the intersection of U.S. Highway 14-61 & State Highway 35. Then easterly along U.S. Highway 14-61 approximately 4.75mi. (7.64km) to the intersection with County Road M. Then east along County Road M 0.61mi. (0.98km) to the intersection with Schmaltz Road. Then northeasterly along Schmaltz Rd. approximately 400ft. (122m) to the 12" x 4½' concrete marker with brass cap on the north side of the roadway.

RECORD OF DURABLE WITNESS MONUMENTS

DETAIL SKETCH

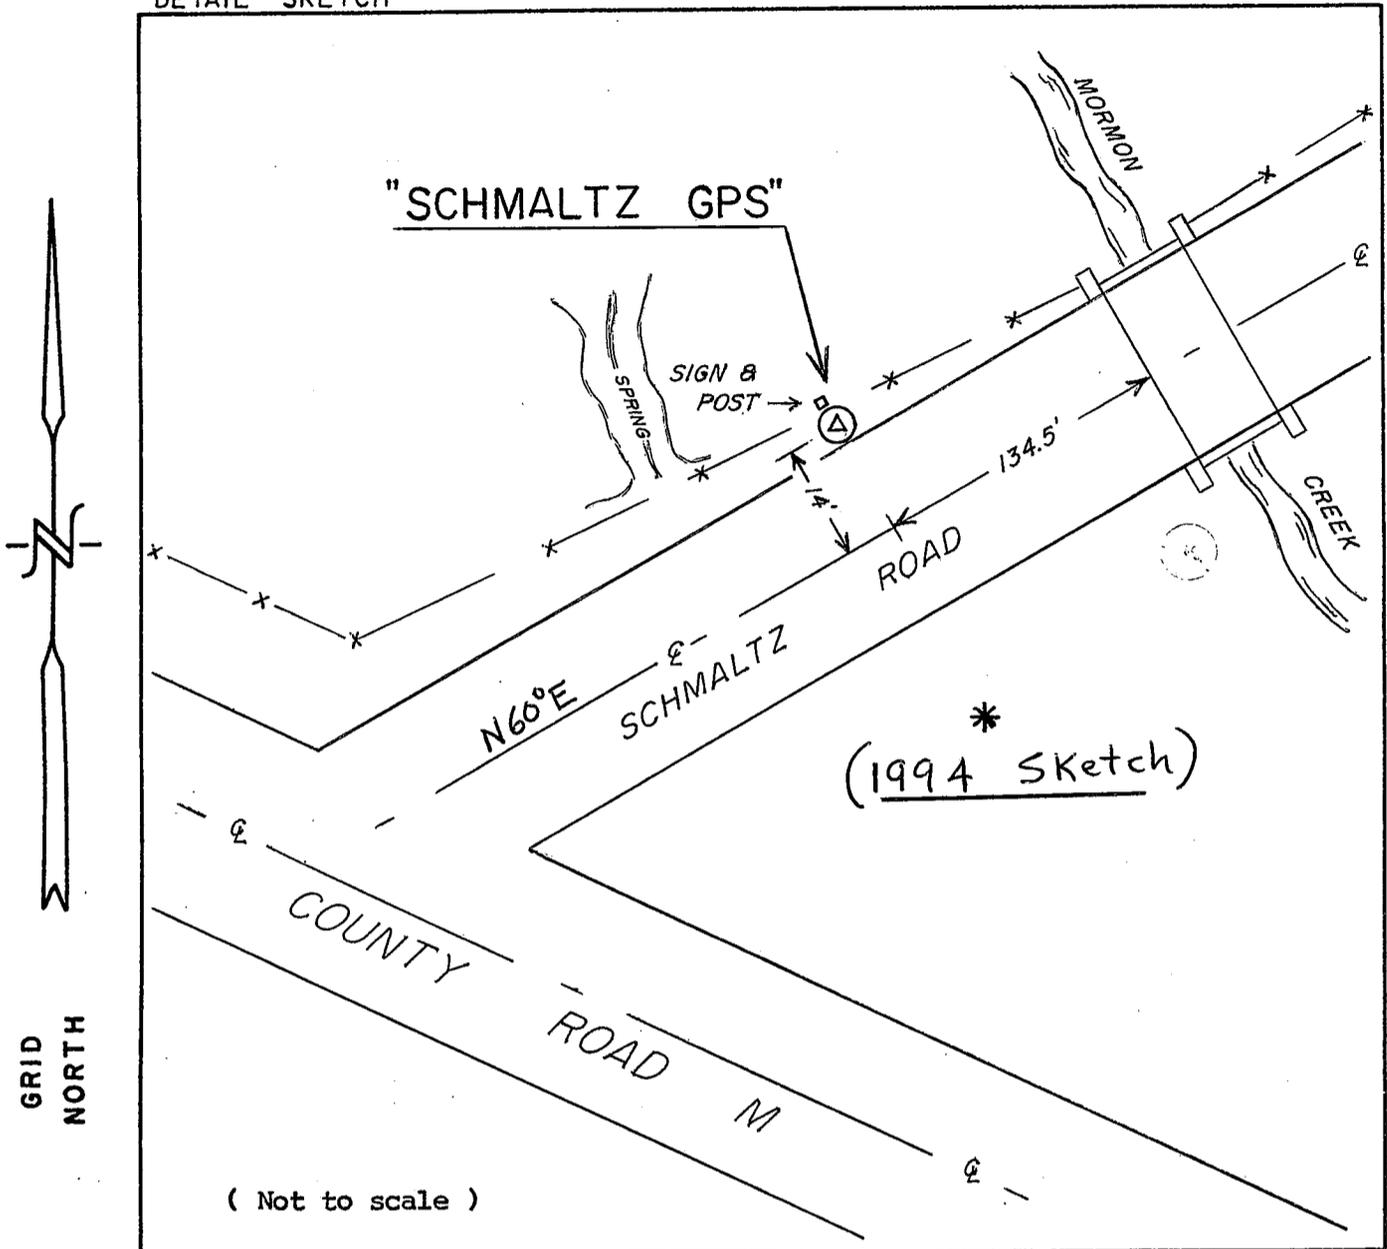

NO.	DESCRIPTION	BEARING	DISTANCE

REMARKS: _____

I, William C. Jung - County Surveyor
 HEREBY CERTIFY THAT THE MONUMENT LOCATION SHOWN
 ON THIS RECORD WAS DETERMINED UNDER MY DIRECTION
 AND CONTROL AND THAT THIS GPS/GEODETIC RECORD IS
 CORRECT AND COMPLETE TO THE BEST OF MY KNOWLEDGE
 AND BELIEF.

William C. Jung
 SIGNATURE

2/8/00
 DATE

