


# G.P.S. / GEODETIC SURVEY MONUMENT RECORD

SECTION 23, T 17 N, R 7 W, CITY/TOWN/VILLAGE HAMILTON

LA CROSSE COUNTY

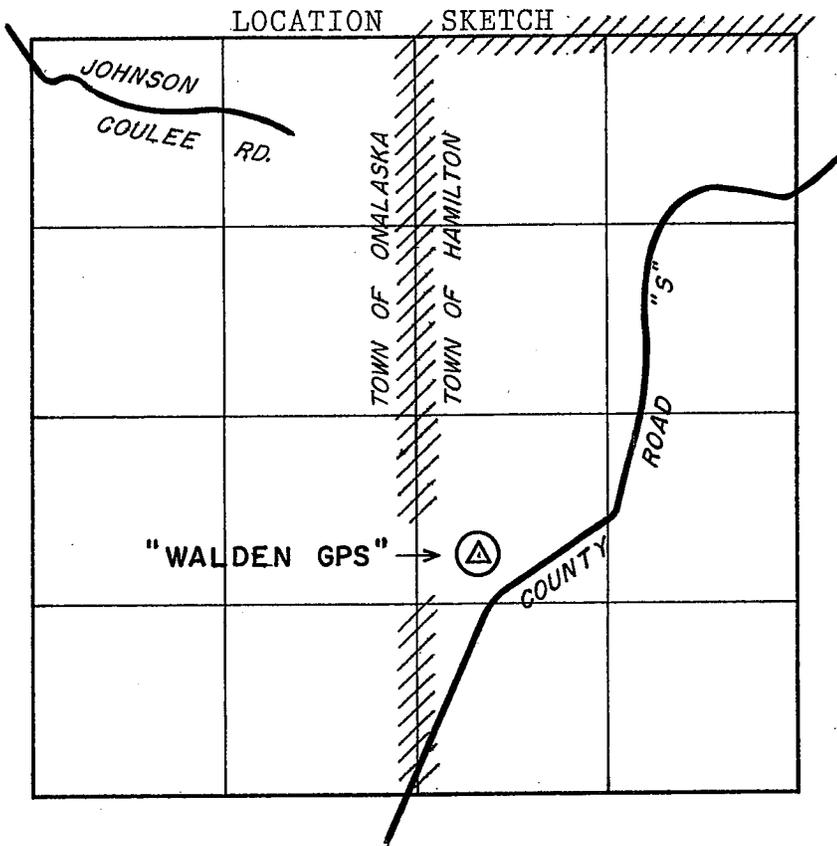

HORIZONTAL DATUM	
NAD 83(91):	
(Y)	_____
(X)	_____
NAD 27 _____:	
(Y)	_____
(X)	_____
OTHER: _____	
(Y)	_____
(X)	_____
VERTICAL DATUM	
ELEV. _____,	_____
ELEV. _____,	<u>1929</u>
ELEV. _____,	<u>1988</u>

SECTION 23-17-7.

## GPS / GEODETIC STATION DESCRIPTION

~~N.O.T. PROJECT I.D.~~ : LaCrosse Co. computer I.D.: WALD

STATION NAME: "WALDEN GPS" STATION NO. \_\_\_\_\_

LATITUDE: \_\_\_\_\_ LONGITUDE: \_\_\_\_\_

LOCAL NAME: Same as above

MONUMENT BY AGENCY: County Surveyor DATE: 7/23/96 TYPE: Brass cap in conc.

SET BY: N.G.S.



MAINTENANCE RECORD: \_\_\_\_\_

The station is located in the west-central part of La Crosse County. More easily found beginning at the intersection of County Road "s" and County Road "SN" ( Sand Lake Coulee Road ). Then east and northeasterly along County Rd. "S" approximately 3.0 mi. ( 4.8 km ) to the concrete marker with brass cap located northwesterly of the road. The marker is buried down 11 inches ( 28 cm ) in a field and northerly of a railroad communication tower. When traveling northeasterly along Co. Rd. "S", the marker would be approximately 1000 ft. ( 300 m ) before the entrance to a quarry.

# RECORD OF DURABLE WITNESS MONUMENTS

## DETAIL SKETCH


( Not to scale )  
( Grid Bearings )

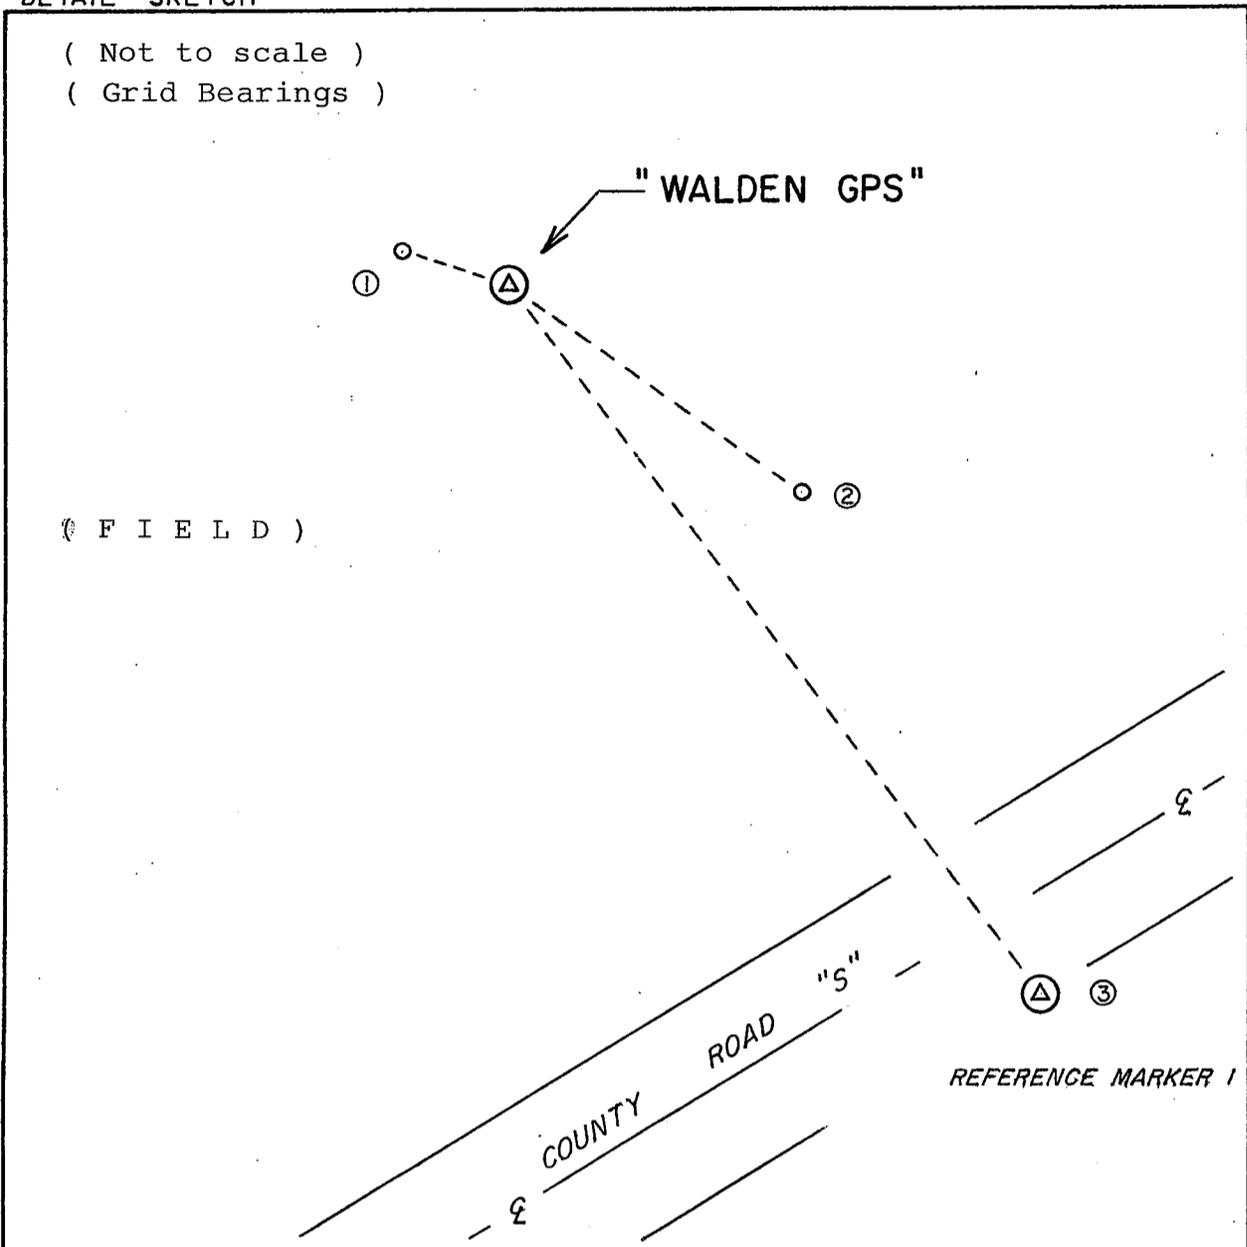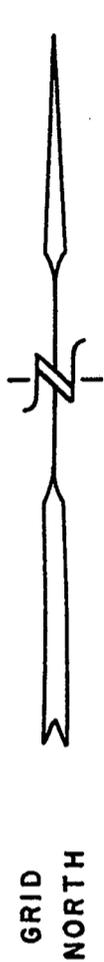

NO.	DESCRIPTION	BEARING	DISTANCE
1	Ex. I.P. set by P.E. Fairchild (down 14"s)	N 72°05'48"W	34.09 Ft.
2	Ex. I.P. buried in the field	S 54°53'23"E	130.95 Ft.
3	Fd. brass cap in concr. reference mark #1	S 37°00'42"E	324.95 Ft.

REMARKS: \_\_\_\_\_  
 \_\_\_\_\_  
 \_\_\_\_\_  
 \_\_\_\_\_

I, William C. Jung, County Surveyor  
 HEREBY CERTIFY THAT THE MONUMENT LOCATION SHOWN  
 ON THIS RECORD WAS DETERMINED UNDER MY DIRECTION  
 AND CONTROL AND THAT THIS GPS/GEODETIC RECORD IS  
 CORRECT AND COMPLETE TO THE BEST OF MY KNOWLEDGE  
 AND BELIEF.

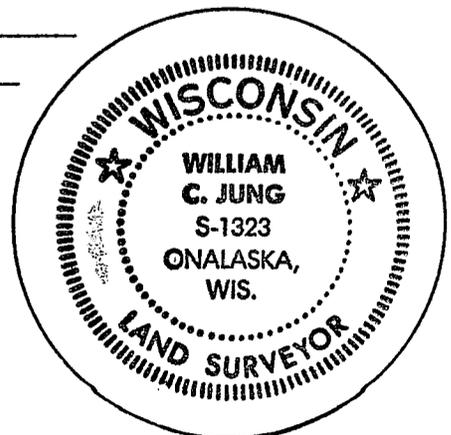

SIGNATURE \_\_\_\_\_ DATE \_\_\_\_\_