


G.P.S. / GEODETIC SURVEY MONUMENT RECORD

SECTION 36, T 15 N, R 5 W, CITY/TOWN/VILLAGE WASHINGTON

LA CROSSE COUNTY

Lat: 43°43'31.337791 N, (.00000m)
 Lon: 90°54'38.665775 W, (.00000m)
 Ell. Hgt in m: (222.4502m), (.00000m)

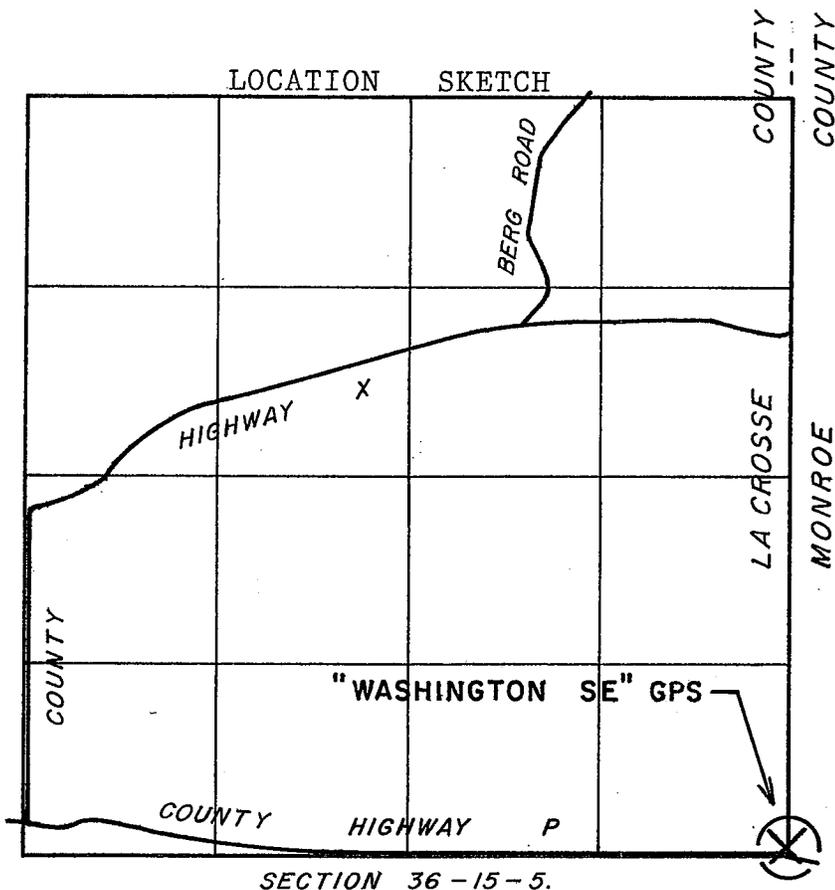

HORIZONTAL DATUM	
NAD 83(91):	
(Y)	630,166.058
(X)	1,727,759.392
NAD 27 _____:	
(Y)	_____
(X)	_____
OTHER: _____	
(Y)	_____
(X)	_____
VERTICAL DATUM	
ELEV. _____,	_____
ELEV. _____,	1929
ELEV. _____,	1988

GPS / GEODETIC STATION DESCRIPTION


~~D.O.T. PROJECT I.D.:~~ LaCrosse Co. computer I.D.: WASE
 STATION NAME: "WASHINGTON SE" GPS STATION NO. 155W36S
 LATITUDE: _____ LONGITUDE: _____
 LOCAL NAME: SE County Corner-Timber Coulee
 MONUMENT BY AGENCY: Co. Surveyor DATE: 9/24/93 TYPE: Brass cap in conc.
 SET BY: William C. Jung & Peter F. Follansbee
 MAINTENANCE RECORD: 10/28/99 wcj OK
 MAINTENANCE RECORD: 7/7/03 wcj OK
 MAINTENANCE RECORD: 8/5/08 wcj OK
 MAINTENANCE RECORD: _____
 MAINTENANCE RECORD: _____

The station is located at the southeast corner of LaCrosse County. More easily found beginning at the east side of the Village of Coon Valley in Vernon County at the intersection of U.S. Hwy 14-61 & County Hwy P. Then northeasterly approx. 6.1 mi. (9.8 km) along Co. Hwy P to the 15" x 5' concrete marker with brass cap on the north side of the road. Note: the intersection of Co. Hwy X & Co. Hwy P is 1 mi. (1.6 km) west of the marker.

RECORD OF DURABLE WITNESS MONUMENTS

DETAIL SKETCH

(Not to scale)

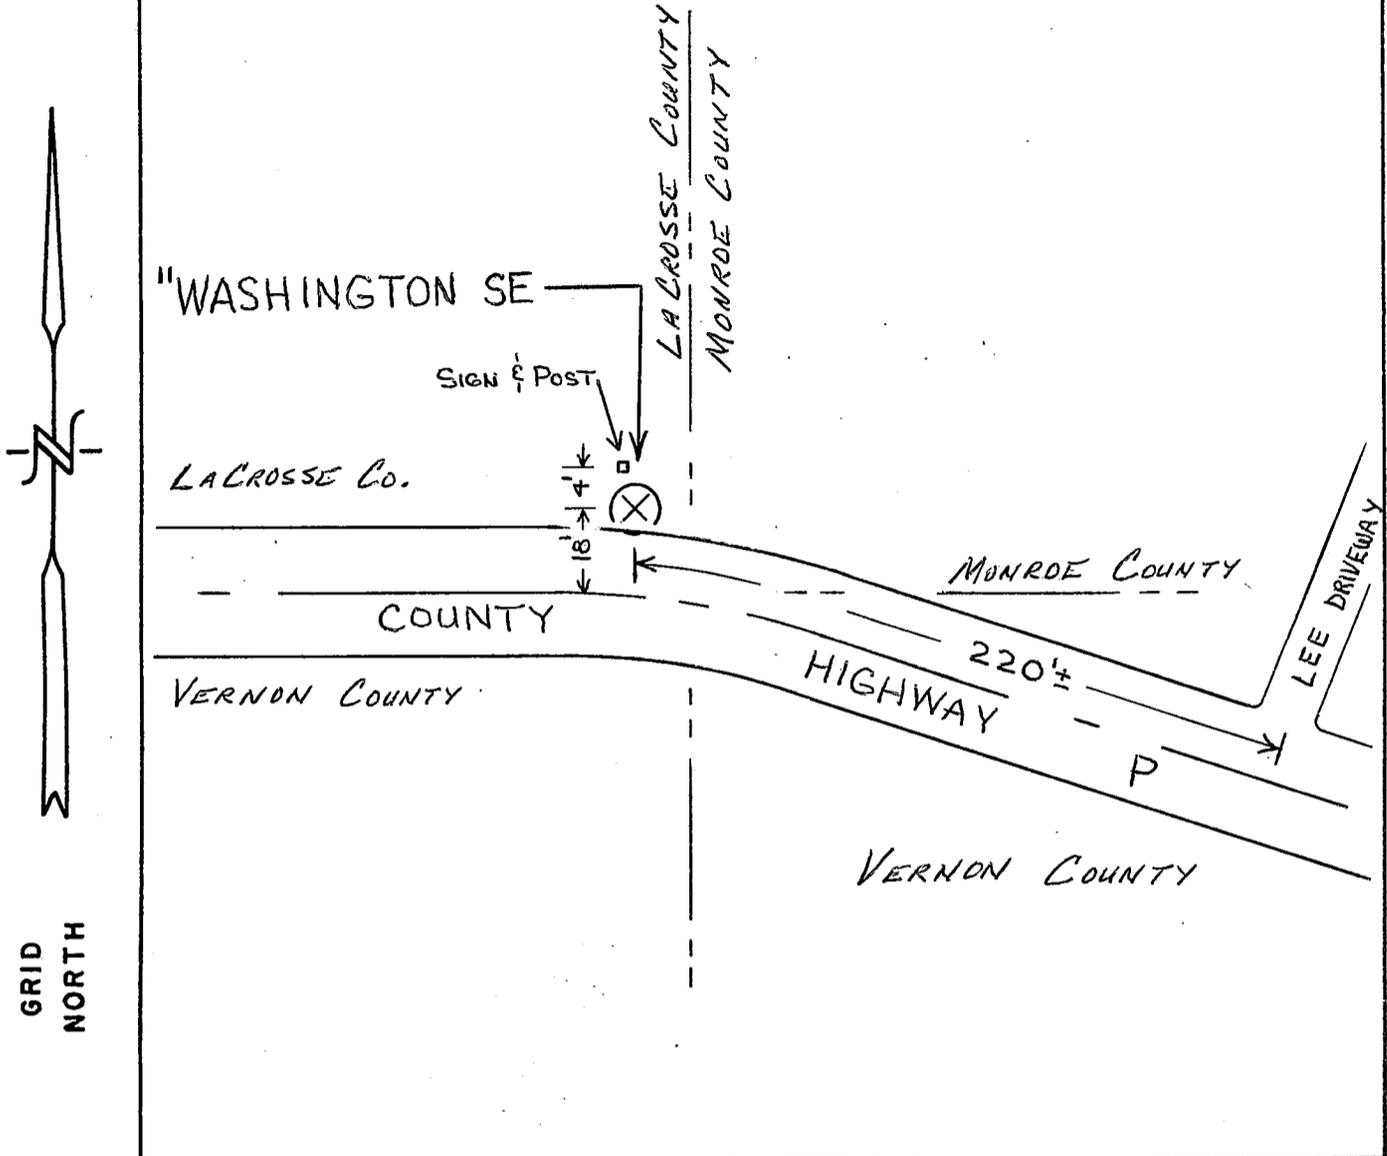

NO.	DESCRIPTION	BEARING	DISTANCE

REMARKS: _____

I, William C. Jung, County Surveyor
 HEREBY CERTIFY THAT THE MONUMENT LOCATION SHOWN
 ON THIS RECORD WAS DETERMINED UNDER MY DIRECTION
 AND CONTROL AND THAT THIS GPS/GEODETIC RECORD IS
 CORRECT AND COMPLETE TO THE BEST OF MY KNOWLEDGE
 AND BELIEF.

William C. Jung
 SIGNATURE

2/8/00
 DATE

