


G.P.S. / GEODETIC SURVEY MONUMENT RECORD

SECTION 30, T 15 N, R 5 W, CITY/TOWN/VILLAGE WASHINGTON

LA CROSSE COUNTY

Lat: 43°44'50.023498 N, (.00000m)
 Lon: 91°01'31.437030 W, (.00000m)
 Ell. Hgt in m: (366.7513m), (.00000m)

LOCATION SKETCH

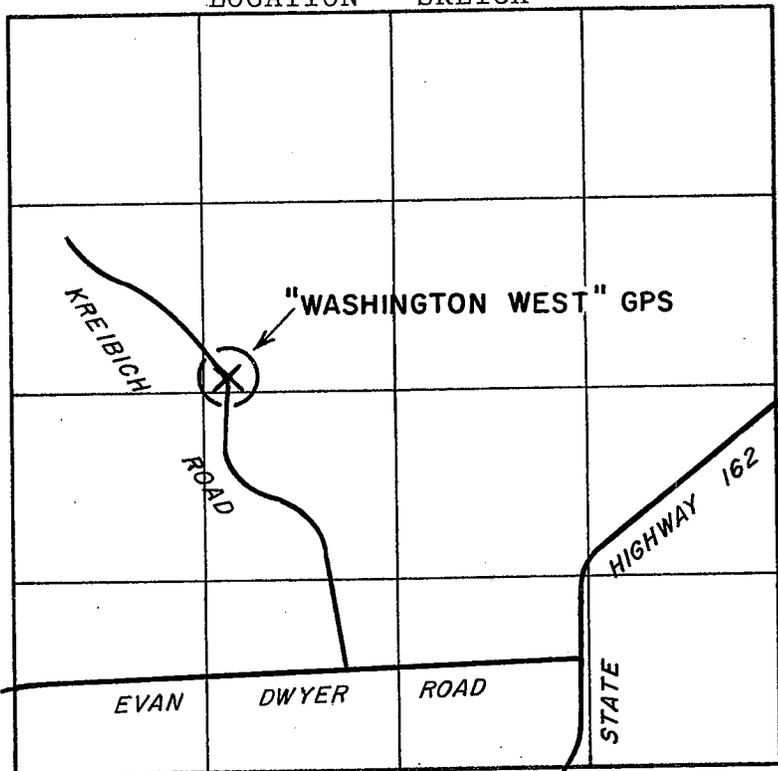

SECTION 30-15-5

HORIZONTAL DATUM	
NAD 83(91):	
(Y)	<u>638,484.361</u>
(X)	<u>1,697,550.495</u>
NAD 27 _____:	
(Y)	_____
(X)	_____
OTHER: _____	
(Y)	_____
(X)	_____
VERTICAL DATUM	
ELEV. _____,	_____
ELEV. <u>1309.3±</u> ,	<u>1929</u>
ELEV. _____,	<u>1988</u>

GPS / GEODETIC STATION DESCRIPTION

D.O.T. PROJECT I.D.: LaCrosse Co. computer I.D.: WAVE

STATION NAME: WASHINGTON WEST GPS STATION NO. 155W30S

LATITUDE: _____ LONGITUDE: _____

LOCAL NAME: Kreibich Road

MONUMENT BY AGENCY: County Surveyor DATE: 9/17/93 TYPE: Brass cap in conc.

SET BY: William C. Jung & Peter F. Follansbee

MAINTENANCE RECORD: 2/10/00 OK wcj

MAINTENANCE RECORD: 10/24/06 OK wcj

MAINTENANCE RECORD: _____


MAINTENANCE RECORD: _____

MAINTENANCE RECORD: _____

The station is located in the southeastern part of LaCrosse County. More easily found beginning at the intersection of U.S. Hwy 14-61 & State Hwy 162 on the west side of the Village of Coon Valley in Vernon County. Then northerly on State Hwy 162 3.3mi. (5.3km) to the intersection with Evans Dwyer Road. Then west along Evans Dwyer Rd. 0.3mi. (0.5km) to the intersection with Kreibich Road. Then north along Kreibich Rd. 0.4mi. (0.7km) to the 15" x 5' concrete marker with brass cap.

RECORD OF DURABLE WITNESS MONUMENTS

DETAIL SKETCH

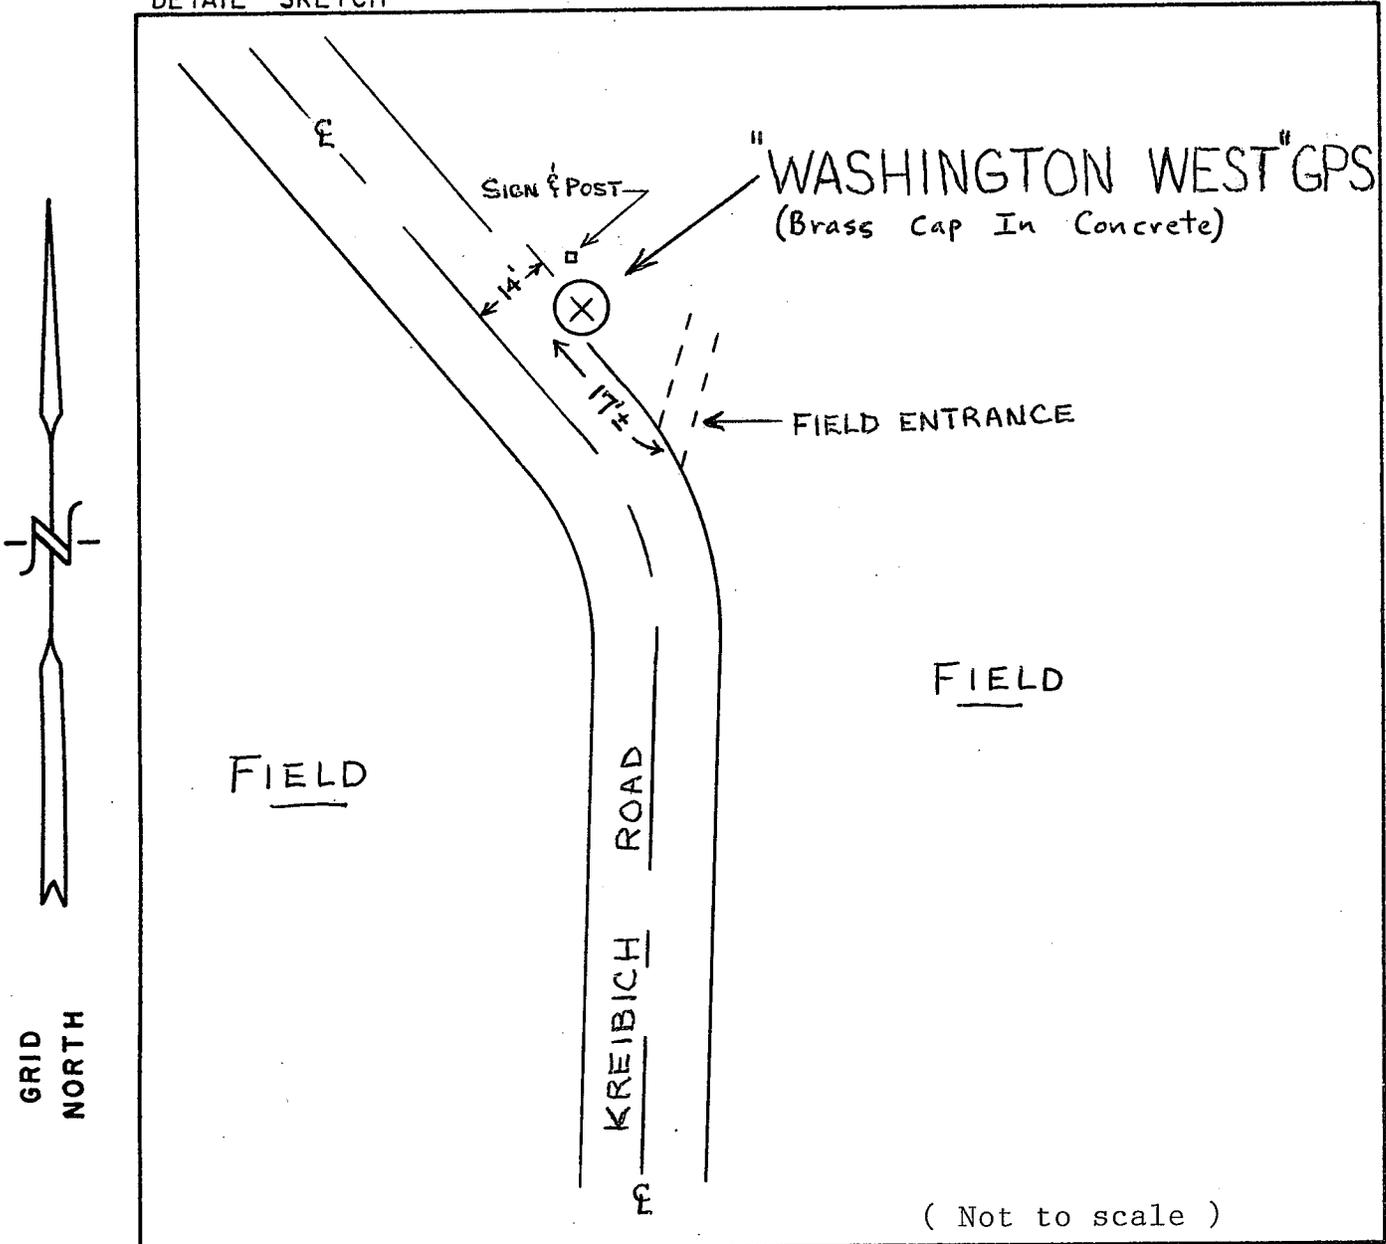

NO.	DESCRIPTION	BEARING	DISTANCE

REMARKS: _____

I, William C. Jung, County Surveyor
 HEREBY CERTIFY THAT THE MONUMENT LOCATION SHOWN
 ON THIS RECORD WAS DETERMINED UNDER MY DIRECTION
 AND CONTROL AND THAT THIS GPS/GEODETIC RECORD IS
 CORRECT AND COMPLETE TO THE BEST OF MY KNOWLEDGE
 AND BELIEF.

William C. Jung
 SIGNATURE

2/17/00
 DATE

