



E.T.C., INC.  
(608) 784-4070

REGISTERED ENGINEERS AND LAND SURVEYORS  
432 DIVISION STREET — LACROSSE, WISCONSIN

# PLAT OF SURVEY

# VB-2

PROPERTY OF RODNEY BERG  
DESCRIBED AS FOLLOWS: PART OF OUT LOT 30, VILLAGE OF BANGOR, LA CROSSE CO., WISCONSIN

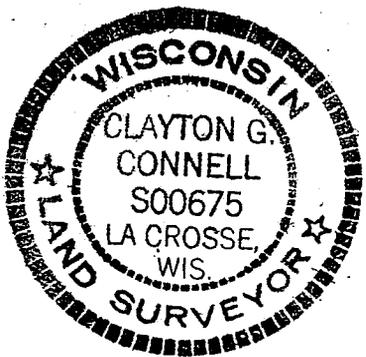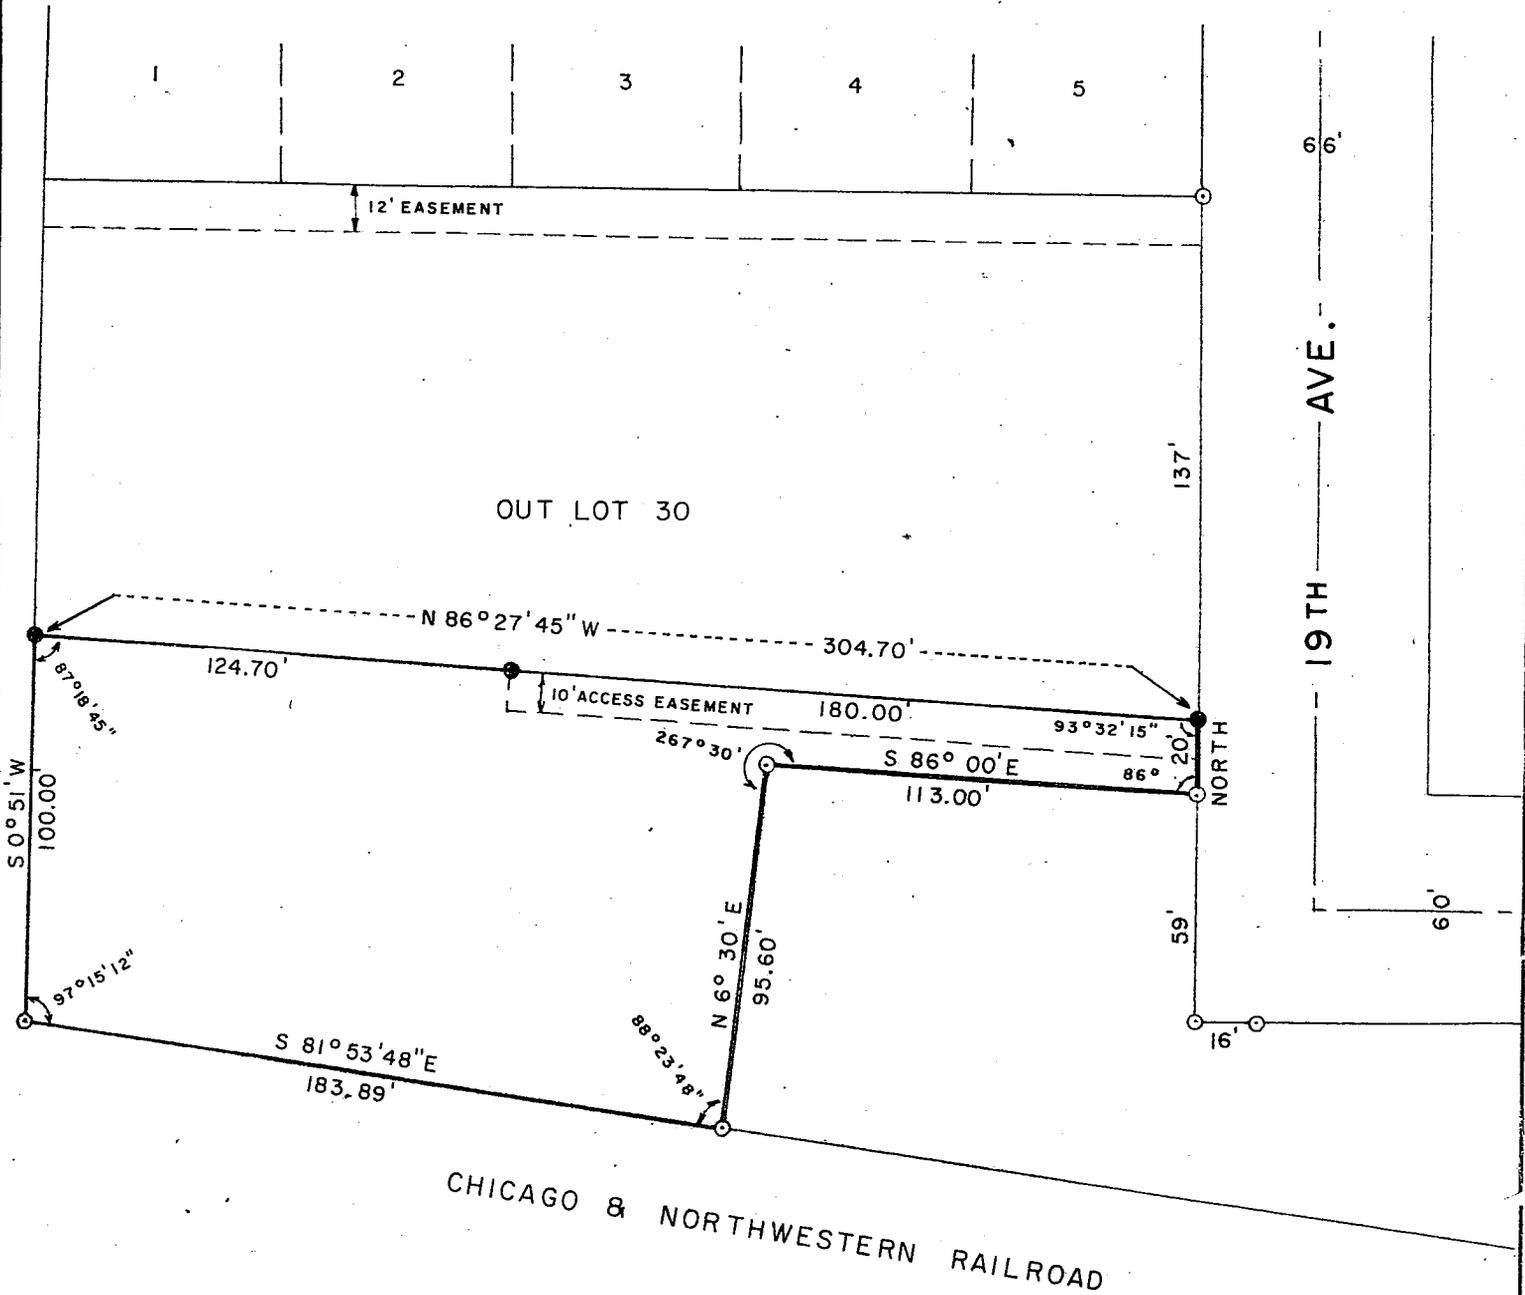

### CERTIFICATE OF SURVEY

I HEREBY CERTIFY THAT ON MAY 24, 1976 I SURVEYED THE PROPERTY DESCRIBED ABOVE AND THAT THE ABOVE PLAT IS A CORRECT REPRESENTATION OF SAID SURVEY.

*Clayton G. Connell*

REG. NO. S00675

SCALE: 1" INCH = 50' FEET  
● - INDICATES IRON PIPE SET  
○ - INDICATES IRON PIPE FOUND  
BK. 11A PG. 62 JOB NO. 235