


U. S. PUBLIC LAND SURVEY MONUMENT RECORD

SECTION 4 T 16 N, R 5 W, ^{Village} ~~TOWN~~ OF BANGOR
 LA CROSSE COUNTY

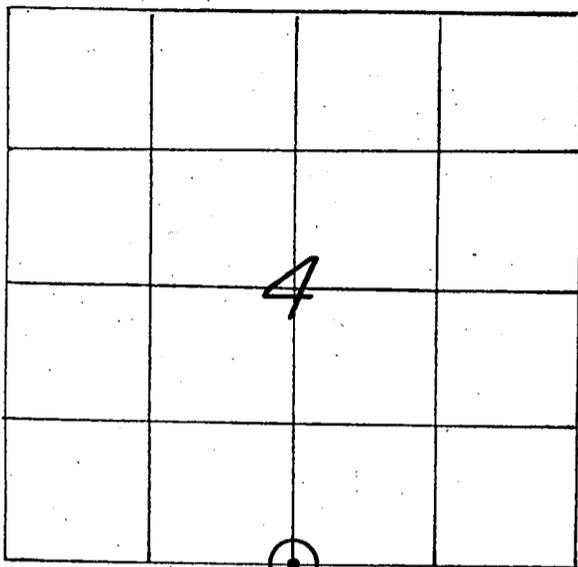

LOCATION OF LANDMARK

CREW: WILLIAM C. JUNG
 PETER F. FOLLANSBEE
 DATE: 6/07/2005

WISCONSIN COORDINATE SYSTEM	
North	688,476.441
East	1,709,974.812
Theta Angle	
Horiz. Order	
Vert. Order	
DATUM:	1983('91)

TYPE OF LANDMARK
 3/4" x 30" I. BAR w/RED PLASTIC CAP IN I. PIPE.

BEARINGS ARE REFERENCED TO
 GRID NORTH AS PER SECTION DATA.

Describe any record evidence, monument evidence, testimonial evidence or any other material evidence you considered and whether the monument was found or restored through acceptance of an obliterated evidence location.


I found the iron pipe that I set back in 1986, set an iron bar with cap in it, drove them down, and took new ties. This pipe has been used in numerous surveys since I set it.

Describe or show any material discrepancy between the location of the restored corner and that of the corner previously restored or reestablished.

NONE KNOWN.


RECORD OF DURABLE WITNESS MONUMENTS

NO	DESCRIPTION	BEARING	DISTANCE
1	SET A 3/4"x30" IRON BAR WITH A RED PLASTIC CAP	N 03° E (MAG.)	54.55 FT.
2	EXISTING 3/4" IRON BAR IN THE LAWN	EASTERLY ±	35.16 FT.
3	EXISTING 1-1/4" IRON PIPE, UP 14"s	S.'EASTERLY ±	48.56 FT.
4	SET A DRILL HOLE NEAR END OF N.E. WINGWALL	S.'WESTERLY ±	17.73 FT.

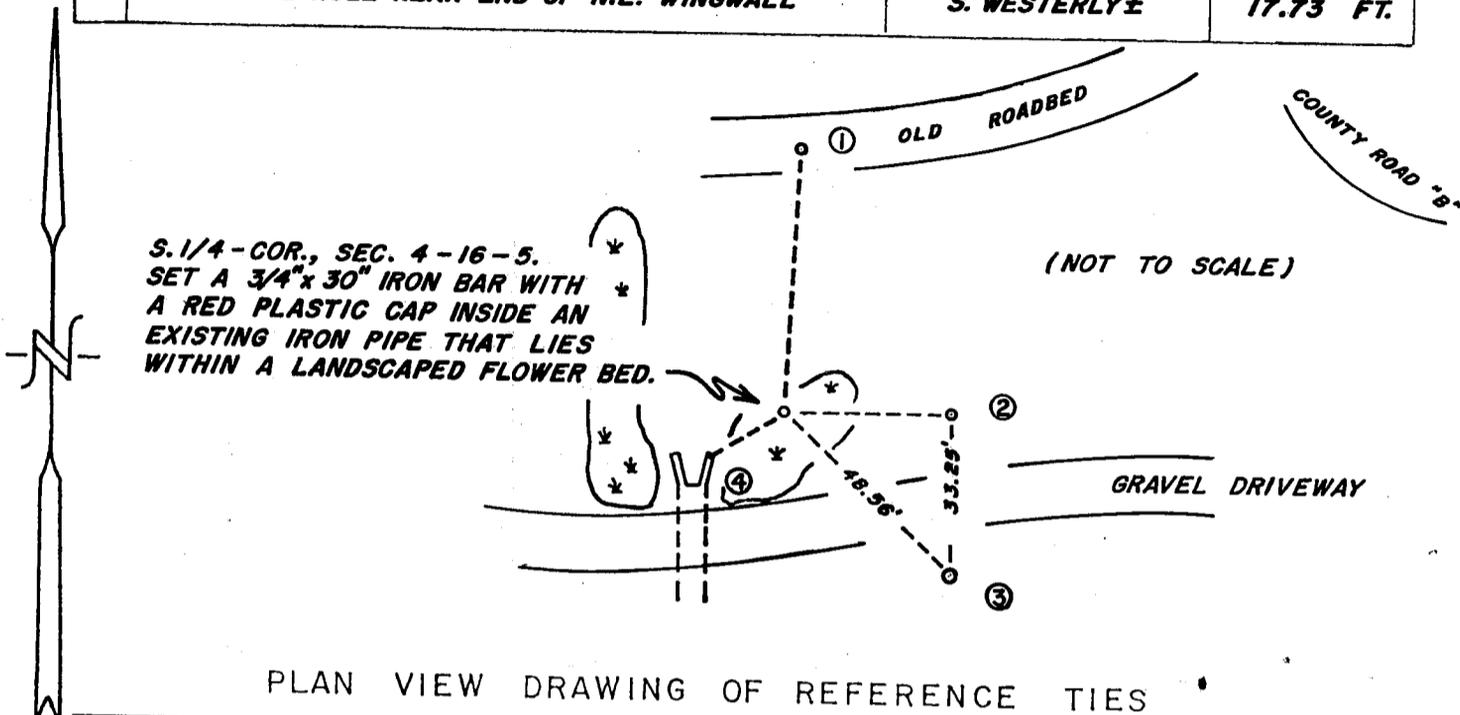


MAP SHOWING DISTANCE AND DIRECTION TO OTHER PUBLIC LAND SURVEY CORNERS USED FOR REESTABLISHING THE CORNER

(GRID BEARINGS AND DISTANCES)
 (GRID FACTOR: 0.999938)
 (NOT TO SCALE)

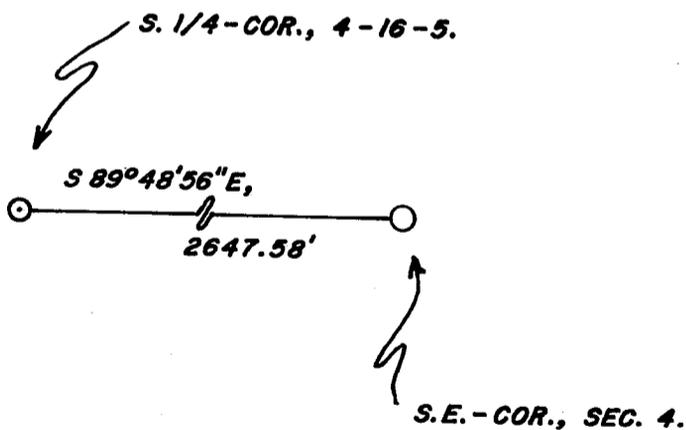

I, WILLIAM C. JUNG, COUNTY SURVEYOR
 HEREBY CERTIFY THAT THE CORNER LOCATION SHOWN ON THIS RECORD WAS DETERMINED BY ME OR UNDER MY DIRECTION AND CONTROL AND THAT THIS U. S. PUBLIC LAND SURVEY MONUMENT RECORD IS CORRECT AND COMPLETE TO THE BEST OF MY KNOWLEDGE AND BELIEF.

William C. Jung 11/18/05
 Signature Date

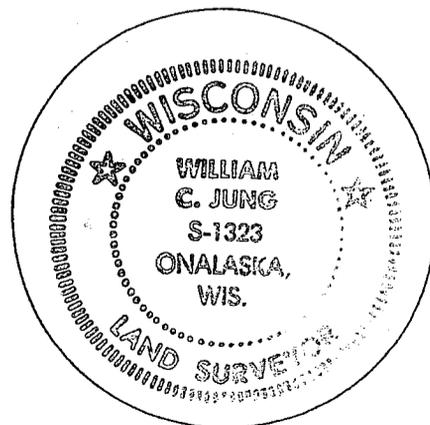


Seal

U. S. PUBLIC LAND SURVEY MONUMENT RECORD

SECTION 4 T 16 N, R 5 W, ^{Village} ~~TOWN~~ OF BANGOR

LA CROSSE COUNTY

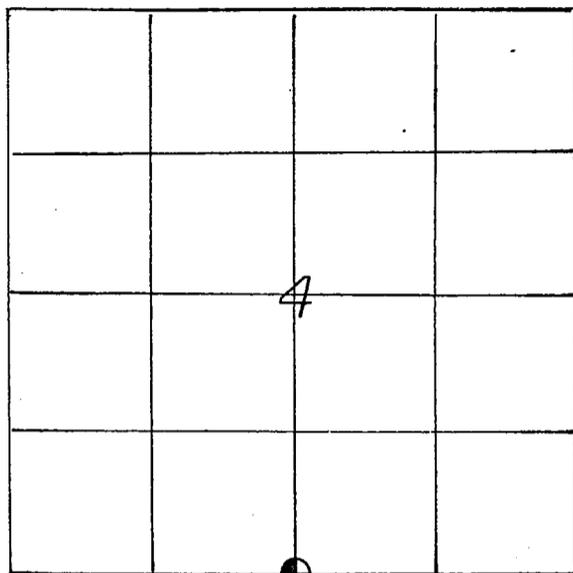

LOCATION OF LANDMARK

DATE: 11-19-86

CREW: BILL JUNG, PERRY DAHL

WISCONSIN COORDINATE SYSTEM
North
East
Theta Angle
Horiz. Order
Vert. Order
TYPE OF LANDMARK
1" iron pipe
BEARINGS ARE REFERENCED TO
True

Describe any record evidence, monument evidence, testimonial evidence or any other material evidence you considered and whether the monument was found or restored through acceptance of an obliterated evidence location.

I set the corner at a location as shown in Robert Schelbe's survey done in 1944. This fits the section data and occupation very well. There was probably a stone here at one time, but was either washed out by erosion or knocked out by C.C.C. construction over 50 years ago. I set an iron pipe at the corner.


Describe or show any material discrepancy between the location of the restored corner and that of the corner previously restored or reestablished.

None known.


VOID

RECORD OF DURABLE WITNESS MONUMENTS
MAGNETIC

NO	DESCRIPTION	BEARING	DISTANCE
1	CHISLED "X" ON N.E. CORNER OF WINGWL.	S57°W	18'
2	2" IRON PIPE	S48°E	48.5'
3			
4			

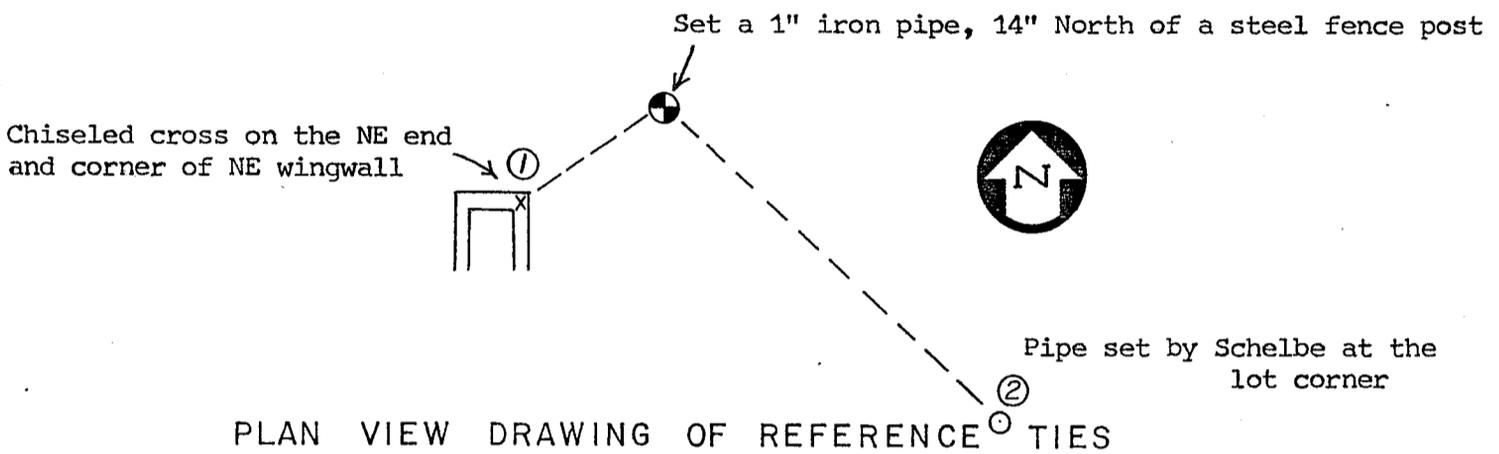


MAP SHOWING DISTANCE AND DIRECTION TO OTHER PUBLIC LAND SURVEY CORNERS USED FOR REESTABLISHING THE CORNER

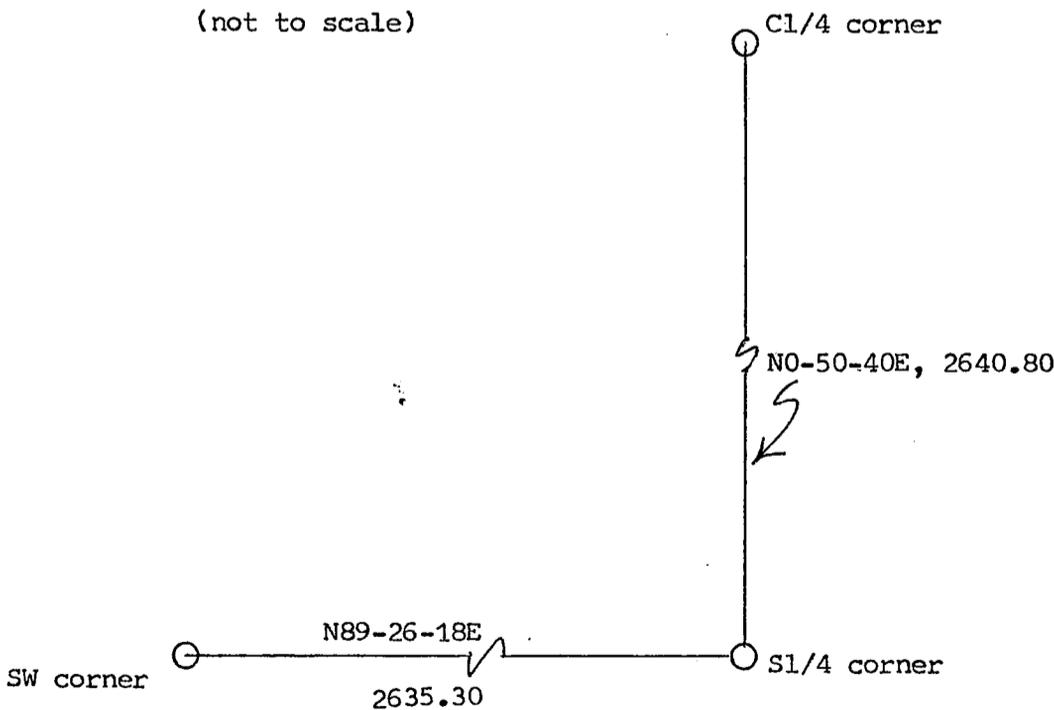

I, William C. Jung, Deputy County Surveyor,
HEREBY CERTIFY THAT THE CORNER LOCATION SHOWN ON THIS RECORD
WAS DETERMINED BY ME OR UNDER MY DIRECTION AND CONTROL AND
THAT THIS U. S. PUBLIC LAND SURVEY MONUMENT RECORD IS CORRECT
AND COMPLETE TO THE BEST OF MY KNOWLEDGE AND BELIEF.

William C. Jung March 17, 1987
Signature Date

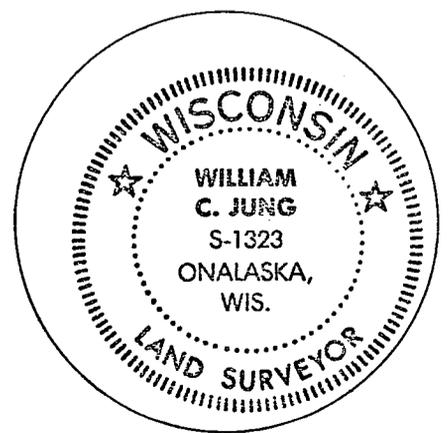

Seal