


MORTGAGE SURVEY

ROBERT KIRCHNER PROPERTY  
PART OF LOT 8, LOTS 9-12,  
H. BOSSHARD ADDITION  
BANGOR, WIS.

FOR: ROBERT KIRCHNER  
1606 DAYTON ST.  
BANGOR, WIS.

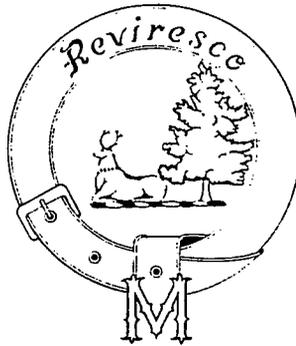

APRIL 5, 1994

MAXWELL SURVEYING


122 Tower Street, Sparta, WI 54656  
608-269-1664

Rodney Maxwell

94-03-19

SCALE  
1" = 60'

O.L. 61

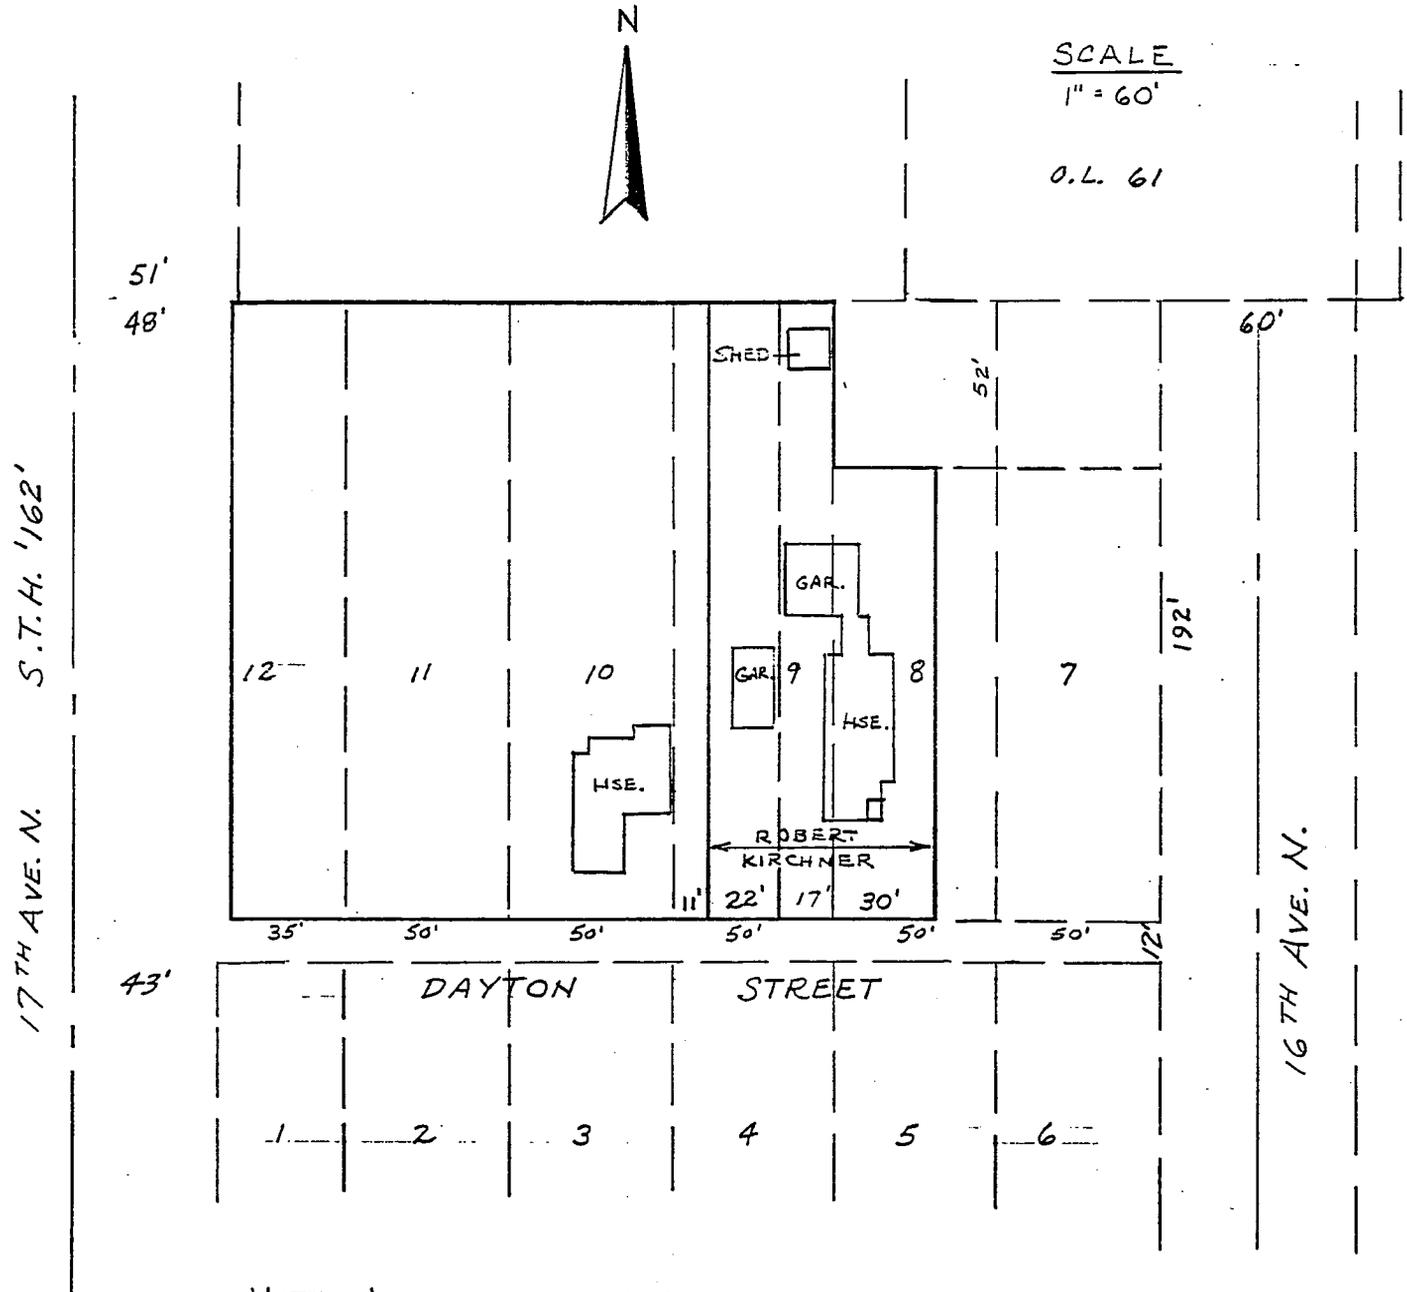

NOTE, LACK OF MONUMENTS IN THIS VICINITY  
MAKE IT DIFFICULT TO DETERMINE LOCATIONS.  
WITHOUT FURTHER SURVEYING. ALL LOCATING  
IS ESTIMATED.

MORTGAGE SURVEY, page 2 of 2

RODNEY H. MAXWELL, Registered Land Surveyor, and  
ROBERT KIRCHNER

hereby agree that in the performance of this Mortgage Survey  
of Part of Lot 8, Lots 9 - 12, H. Bosshard Addition, Bangor, Wisconsin,

the following work is excluded from the requirements of the  
Minimum Standards for Property Surveys established by A-E7 of  
the Wisconsin Administrative Code:

- 1) Boundary Location: No traversing between monuments has been  
made other than rough measurements. No monuments have  
been set.
- 2) Descriptions: Description is as recorded on deed. All bearings  
and distances shown are recorded.
- 3) Mapping: Not referenced as provided in s.59.61 Stats. Does  
not show bearing and distances to related monuments other  
than recorded bearings and distances.

Is not stamped or signed by the surveyor and is not  
certified that the survey is correct to the best of the  
surveyor's knowledge and belief.

- 4) Measurements: Have not been made with instruments or methods  
capable of attaining any required accuracy. No accuracy  
of measurements has been made by horizontal or angular  
monument. Bearings and distances are recorded.

**RELEASE**

Maxwell Surveying is released from all responsibility in  
the preparation of this Mortgage Survey.

Dated this 5th day of April , 19 94 .

~~XXXX~~  
~~XXXX~~ REPRESENTATIVE:

Robert J. Kirchner

MAXWELL SURVEYING

Rodney H. Maxwell  
Rodney H. Maxwell,  
Registered Land Surveyor, #1826