


Bangor

16-5-7-2

VB-45

RE-SURVEY OF LOT 35, JOHN
BOSSHARD ADDITION, BANGOR, WI.

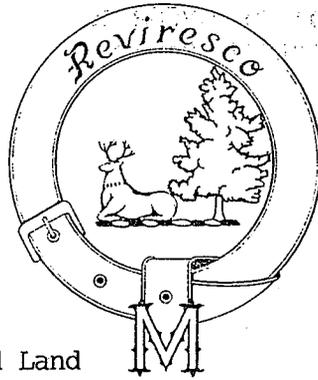

MAXWELL

CIVIL ENGINEERING
& LAND SURVEYING

7457 HIGHWAY 16 SUITE C
SPARTA, WI 54656 • (608) 269-1664


Surveyor's Certificate

I, Rodney H. Maxwell, Registered Land
Surveyor, hereby certify that the Survey
shown & represented herein is true & correct
to the best of my knowledge and belief.


Rodney H. Maxwell

Rodney H. Maxwell
MAXWELL SURVEYING
7457 HWY 16, Suite C
Sparta, Wisconsin
31 March, 1998

Ordered by: Bill Bosshard
1st Natl' Bank of Bangor
Commercial St.
Bangor, WI 54614

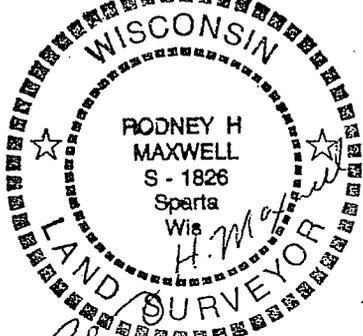

3/31/98

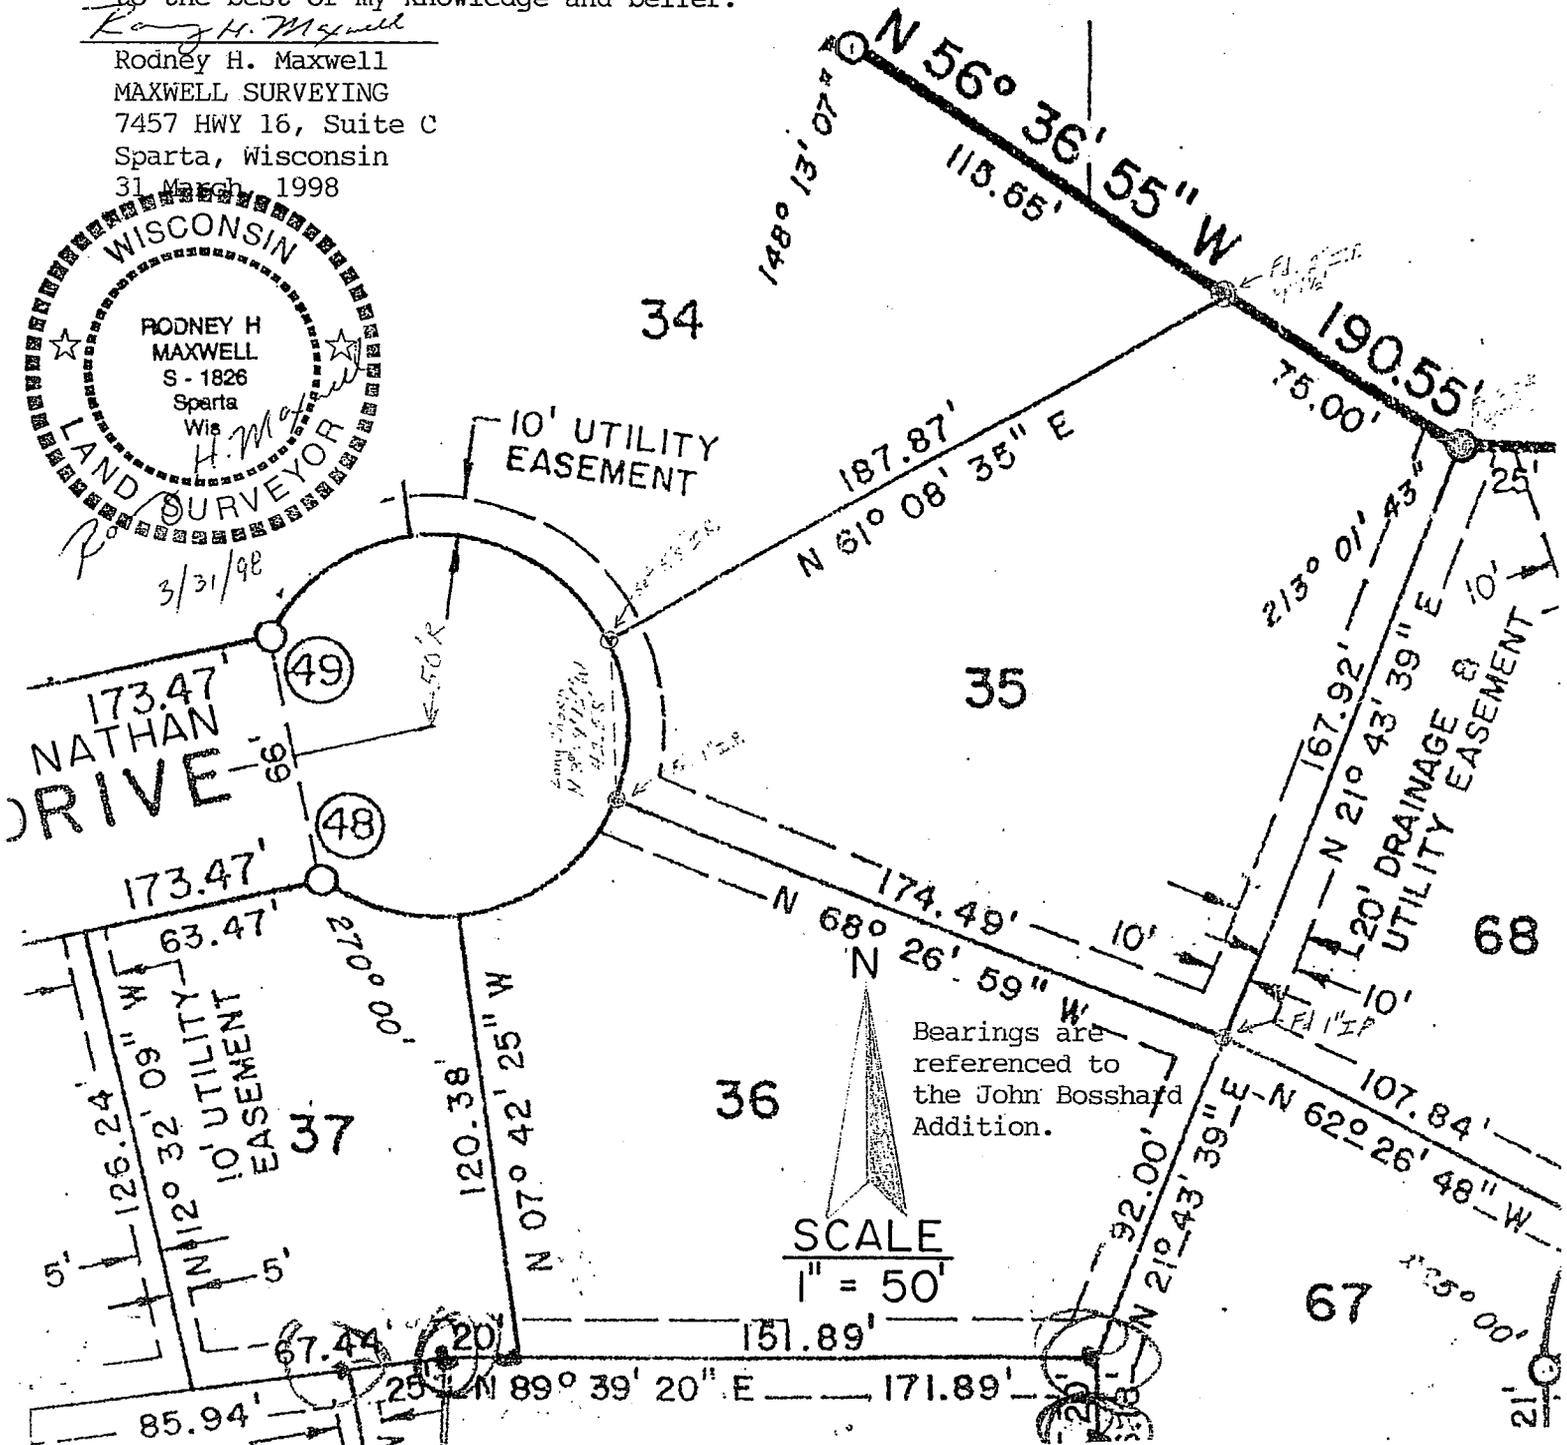

Bearings are
referenced to
the John Bosshard
Addition.

SCALE
1" = 50'