



RECEIVED
OCT 02 2006
 COUNTY SURVEYOR'S OFFICE

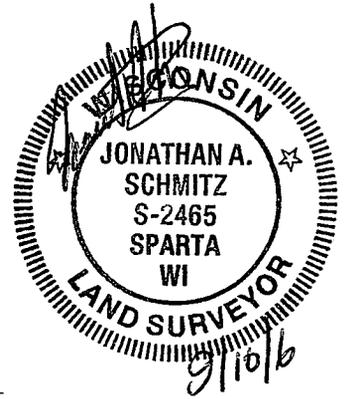

NW CORNER
 S4-T16N-R5W

PLAT OF SURVEY
 LOCATED IN THE SW ¼ OF THE NW ¼ OF
 SECTION 4, T16N, R5W, VILLAGE OF BANGOR,
 LACROSSE COUNTY, WISCONSIN.

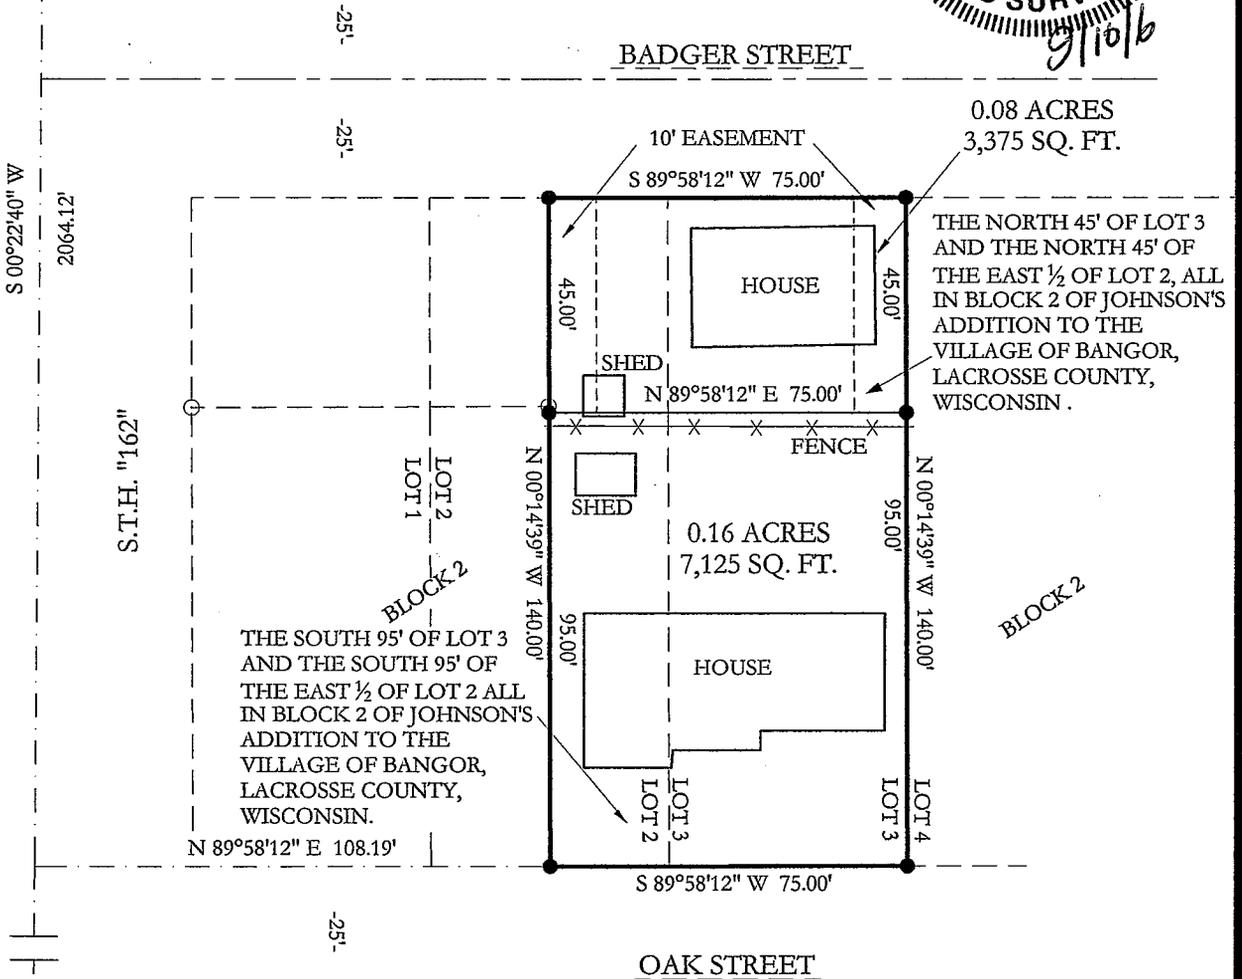


0.08 ACRES
 3,375 SQ. FT.
 THE NORTH 45' OF LOT 3
 AND THE NORTH 45' OF
 THE EAST ½ OF LOT 2, ALL
 IN BLOCK 2 OF JOHNSON'S
 ADDITION TO THE
 VILLAGE OF BANGOR,
 LACROSSE COUNTY,
 WISCONSIN.

0.16 ACRES
 7,125 SQ. FT.
 THE SOUTH 95' OF LOT 3
 AND THE SOUTH 95' OF
 THE EAST ½ OF LOT 2 ALL
 IN BLOCK 2 OF JOHNSON'S
 ADDITION TO THE
 VILLAGE OF BANGOR,
 LACROSSE COUNTY,
 WISCONSIN.

SURVEYORS CERTIFICATE

I, JONATHAN SCHMITZ, REGISTERED LAND SURVEYOR, DO HEREBY CERTIFY BY THE DIRECTION OF WILLIE AND BARBARA STRATMAN, THAT I HAVE SURVEYED AND MAPPED THE DESCRIBED SURVEY ACCORDING TO THE INFORMATION FURNISHED AND THE MAP SHOWN WITHIN IS A TRUE AND CORRECT REPRESENTATION OF LANDS SURVEYED TO THE BEST OF MY KNOWLEDGE AND BELIEFS.

Jonathan A. Schmitz 9/10/6
 JONATHAN A. SCHMITZ, DATE
 REGISTERED LAND SURVEYOR 2465

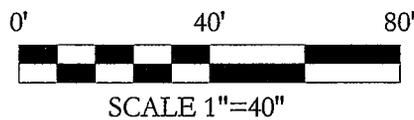

BEARINGS ARE BASED ON THE WEST LINE OF
 SECTION 4, T16N, R5W. N 00°22'40"E REFERENCED
 TO JUNG'S TIE SHEET OF THE WEST ¼ AND THE
 NW CORNER.

POINT SURVEYING LLC. 519 LINCOLN STREET SPARTA, WI 54656 608-269-0744 JONATHAN SCHMITZ RLS #2465	THIS INSTRUMENT WAS DRAFTED AND DRAWN BY JONATHAN SCHMITZ	JOB #S4165W
CLIENT: WILLIE AND BARBARA STRATMAN 1610 OAK STREET BANGOR, WI	PAGE 1 OF 1 PAGES	