


Scale: 1" = 60'

Note: Other improvements on the property were not located at this time due to the fact that the actual property lines could not be established without an actual property survey.

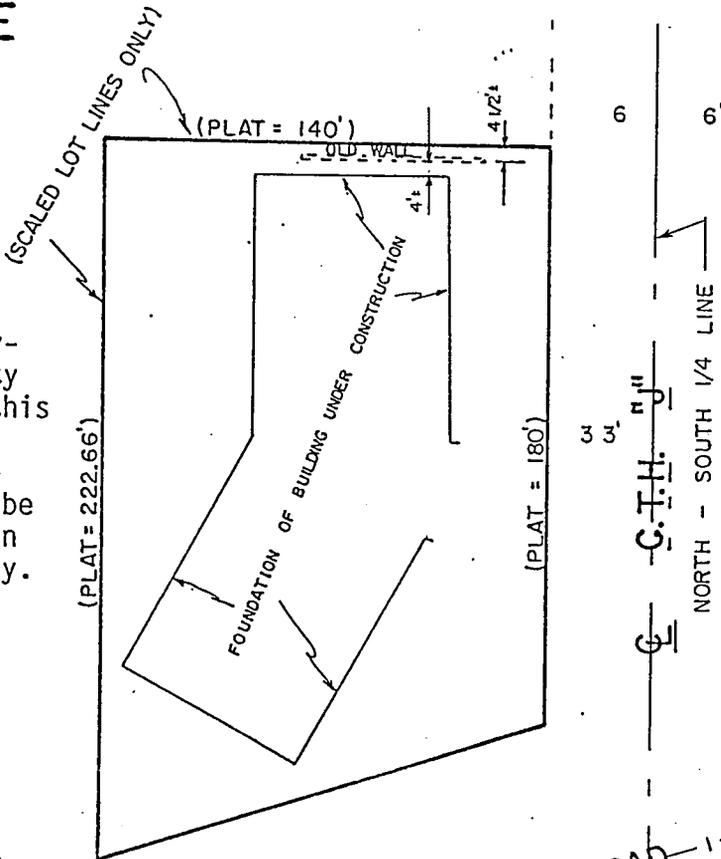

50' (SOO LINE R.R.)
E. C. M. ST. P. & P. RAILROAD
3 5' G.T.H. NORTH - SOUTH 1/4 LINE

SURVEYOR'S CERTIFICATE

I, Garold A. Sime, being a duly qualified Surveyor do hereby certify that by the order and under the direction of Mr. Tim Beron, I have located the foundation of the building under construction this 19th day of May, 1989 located on Lots 9, 10, 11 & 12, Block K, W. O. Jones Add. to Rockland, located in Section 36, T17N-R5W, LaCrosse County, Wisconsin, and that the within map is a true and correct representation of the foundation location to the best of my knowledge and belief.

Revised: Aug. 24, 1989 G.S.

Garold A. Sime
GAROLD A. SIME, REGISTERED LAND SURVEYOR
H. A. Sime & Associates
Tomah, Wisconsin 54660

MINIMUM STANDARDS FOR PROPERTY SURVEY WAIVER

I, as client, hereby waive all the requirements as set forth in Chapter A-E 7 of the Wisconsin Administrative Code regarding minimum standards for property surveys. The sole purpose of the work performed was to show the location of the foundation of the building under construction on the lands as described in the Surveyor's Certificate. This is not an actual property survey in which property corners and boundary lines were accurately established.

Tim Beron 6/5/89
Client (Signature) Date

COPY

LOCATION SKETCH

Located in Lots 9, 10, 11 & 12, Block K, W. O. Jones Add. to Rockland, located in Sec. 36, T17N-R5W, LaCrosse County, WI