


## U. S. PUBLIC LAND SURVEY MONUMENT RECORD

SECTION 1 T 15 N, R 5 W, TOWN OF WASHINGTON

LA CROSSE COUNTY

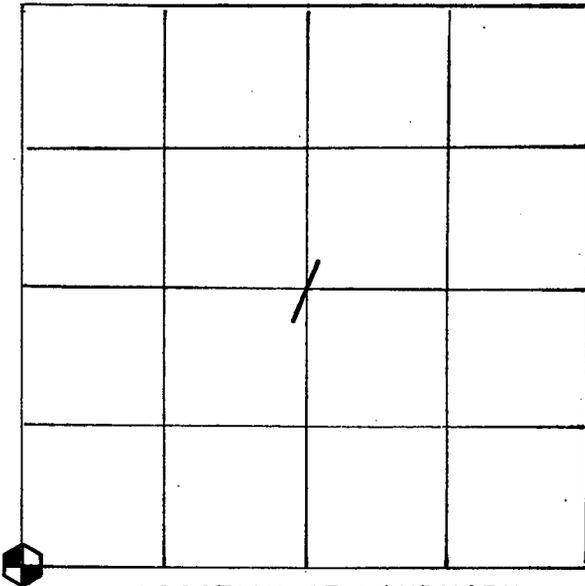

LOCATION OF LANDMARK

Crew: WILLIAM C. JUNG  
 PETER F. FOLLANSBEE  
 Date: 5/27/1997

Describe any record evidence, monument evidence, testimonial evidence or any other material evidence you considered and whether the monument was found or restored through acceptance of an obliterated evidence location.

At the old fence corner I found the iron pipe of record and replaced it with a brass capped Lunde marker.

Describe or show any material discrepancy between the location of the restored corner and that of the corner previously restored or reestablished.

None Known.

WISCONSIN COORDINATE SYSTEM

North

East

Theta Angle

Horiz. Order

Vert. Order

TYPE OF LANDMARK

Brass cap Lunde marker.


BEARINGS ARE REFERENCED TO

GRID NORTH

RECORD OF DURABLE WITNESS MONUMENTS


Magnetic

NO	DESCRIPTION	BEARING	DISTANCE
1	Set a nail in SE-side 14" Cherry	S 38°W	21.62 Ft.
2	Set a nail in NW-side 32" Oak	N 89°E	5.73 Ft.
3	Set a nail in S.-side 37" Oak	S 77°E	34.67 Ft.
4	Set a nail in SW-side 10" White Oak	S 34°E	34.33 Ft.

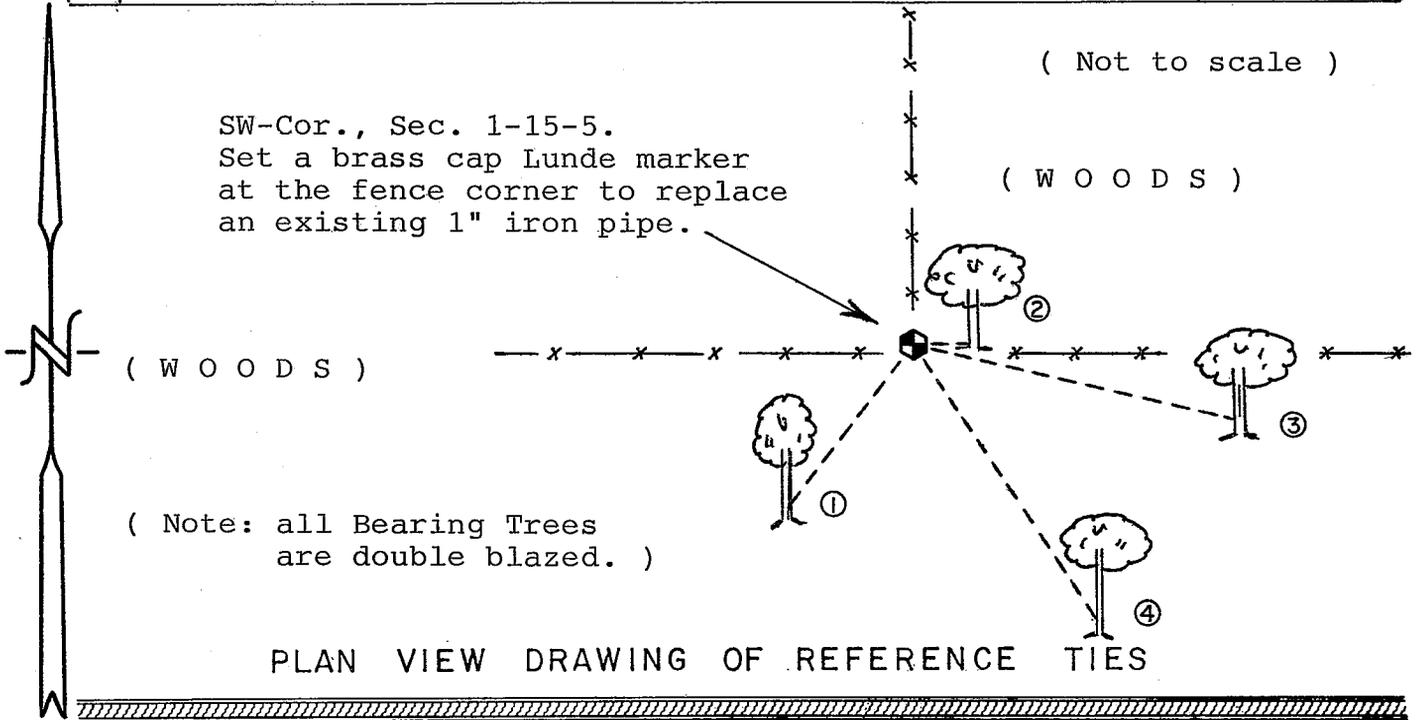

MAP SHOWING DISTANCE AND DIRECTION TO OTHER PUBLIC LAND SURVEY CORNERS USED FOR REESTABLISHING THE CORNER


(not to scale)

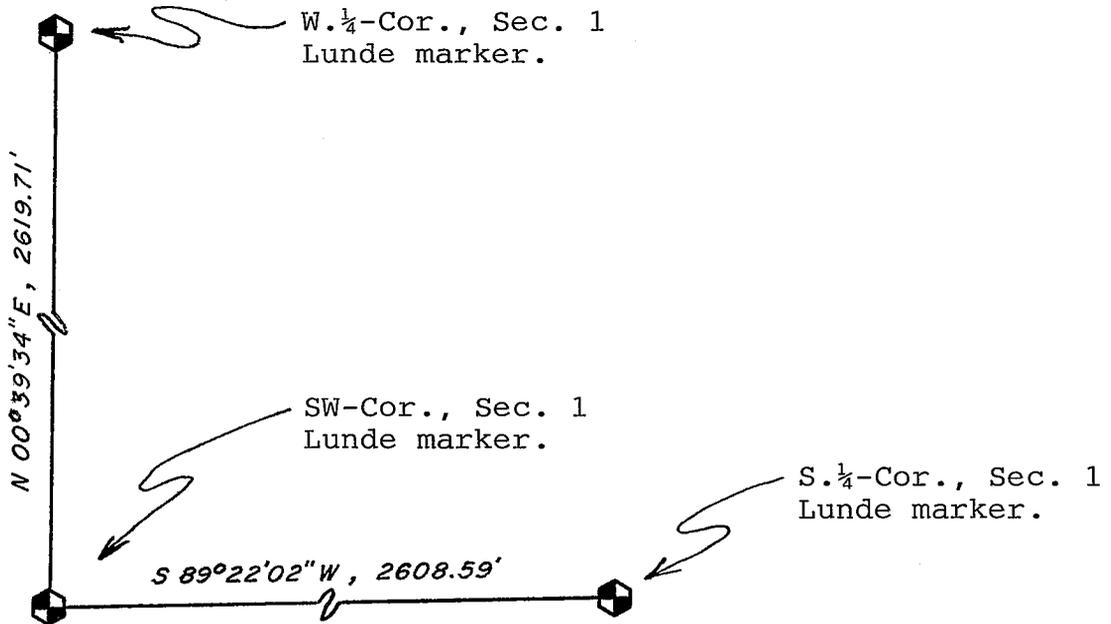

I, William C. Jung, County Surveyor  
HEREBY CERTIFY THAT THE CORNER LOCATION SHOWN ON THIS RECORD  
WAS DETERMINED BY ME OR UNDER MY DIRECTION AND CONTROL AND  
THAT THIS U. S. PUBLIC LAND SURVEY MONUMENT RECORD IS CORRECT  
AND COMPLETE TO THE BEST OF MY KNOWLEDGE AND BELIEF.

William C. Jung  
Signature

7/28/97  
Date

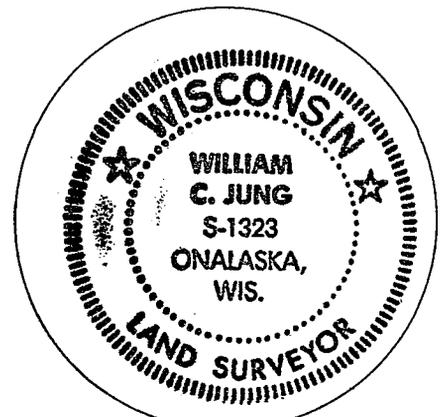

Seal

RECORD OF LAND CORNER PERPETUATION

No. \_\_\_\_\_

STATE OF WISCONSIN

County of La Crosse } ss.

Gary A. Watts, hereby certify that the information shown hereon correctly describes the original corner, resurvey information, evidence found, type of monument found or placed, and witness monuments and accessories used to perpetuate the location of the original or established corner.

Dated this 17 day of Oct., 1983

at La Crosse, Wisconsin.


Gary A. Watts  
Registered Land Surveyor  
Title

COUNTY <u>La Crosse</u>		
TOWN <u>Washington</u>		
HIGHWAY		
SECTION <u>1</u>	TOWNSHIP <u>15 North</u>	RANGE <u>5 West</u>
TYPE OF LANDMARK <u>1" iron pipe</u>		


Date of Survey May 1983

Drafted by GAW

Date Oct. 17, 1983

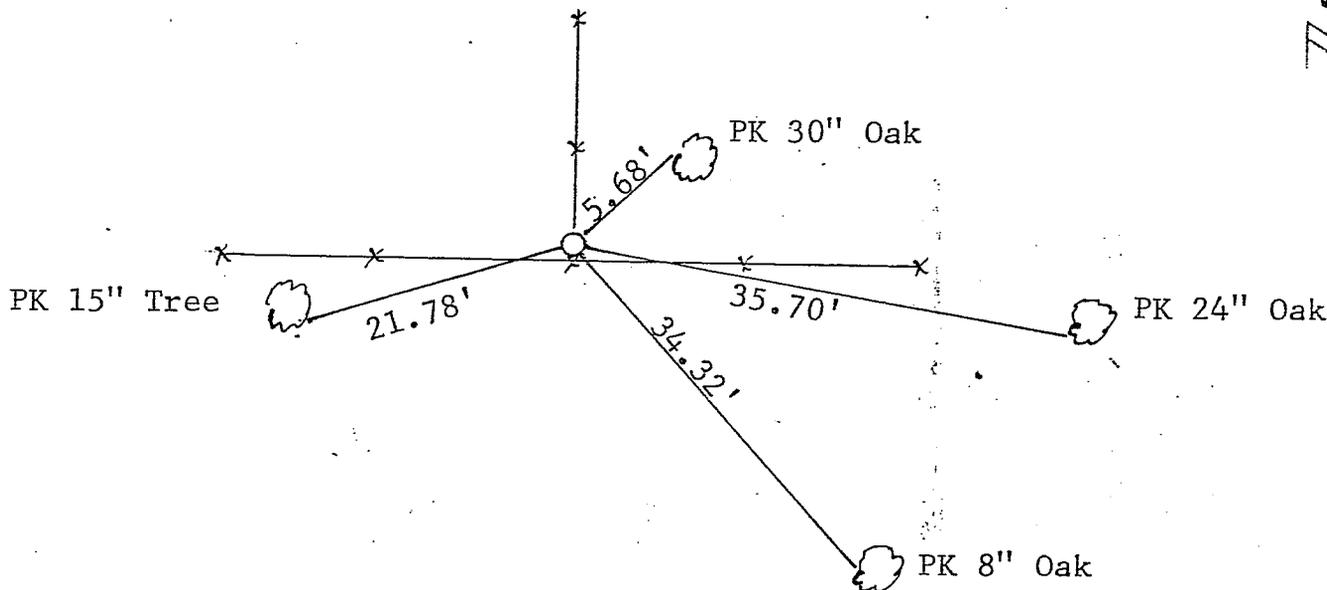

WISCONSIN COORDINATE SYSTEM	
North	Zone
East	
Elevation	Theta Angle
Vertical control order	
Horizontal control order	

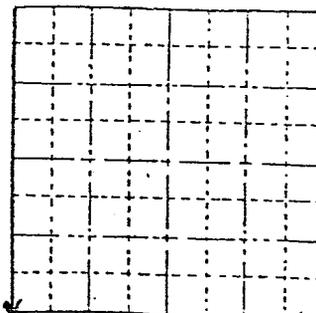

REMARKS: Fence intersection fits old topo calls to corner. Corner set on extension of straight line from SE corner thru the South 1/4 corner to intersect fence line.

LOCATION SKETCH  
(Location of landmark indicated by "x")



RECORD OF LAND CORNER PERPETUATION

No. \_\_\_\_\_

STATE OF WISCONSIN

County of La Crosse } ss.

I, Gary A. Watts, hereby certify that the information shown hereon correctly describes the original corner, resurvey information, evidence found, type of monument found or placed, and witness monuments and accessories used to perpetuate the location of the original or established corner.

Dated this 17 day of Oct., 1983

at La Crosse, Wisconsin.


Gary A. Watts  
Registered Land Surveyor  
Title

COUNTY		
La Crosse		
TOWN		
Washington		
HIGHWAY		
SECTION		
2	TOWNSHIP	RANGE
	15 North	5 West
TYPE OF LANDMARK		
1" iron pipe		


Date of Survey May 1983

Drafted by GAW

Date Oct. 17, 1983

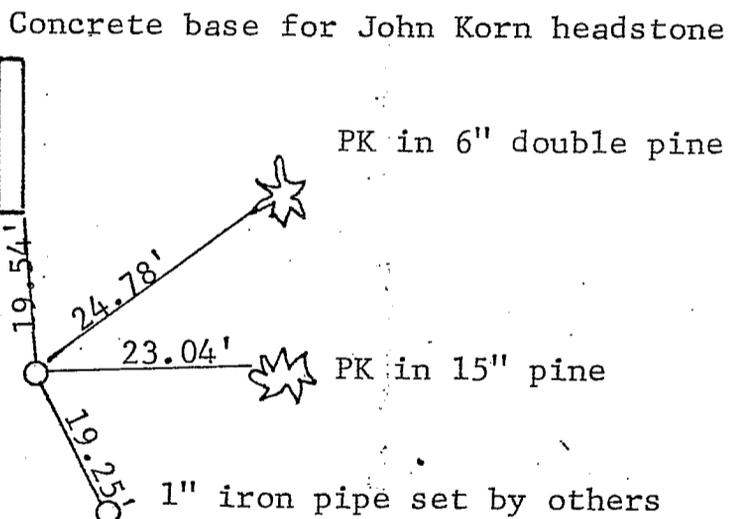

WISCONSIN COORDINATE SYSTEM	
North	Zone
East	
Elevation	Theta Angle
Vertical control order	
Horizontal control order	

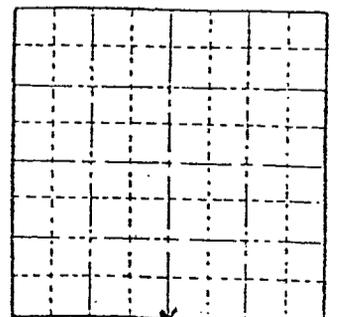

REMARKS: Corner set by single proportionate measurement between corners. Old descriptions best fit this location. Original stone was supposedly dug out for a grave. This point occupies a grave site.

LOCATION SKETCH  
(Location of landmark indicated by "x")

