


U. S. PUBLIC LAND SURVEY MONUMENT RECORD

SECTION 2 T 15 N, R 5 W, TOWN OF WASHINGTON

LA CROSSE COUNTY

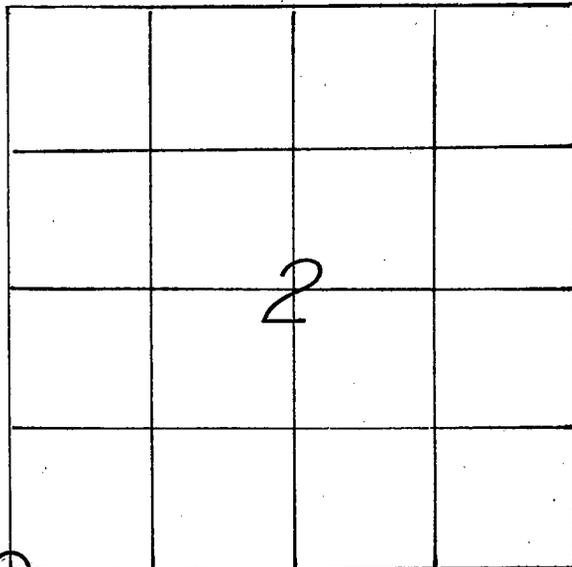

LOCATION OF LANDMARK

Crew: WILLIAM C. JUNG
 PETER F. FOLLANSBEE
 Date: 7/22/1997

WISCONSIN COORDINATE SYSTEM

North 656,680.892

East 1,717,476.383

Theta Angle

Horiz. Order

Vert. Order

DATUM: 1983('91)

TYPE OF LANDMARK

Existing 1½" Iron Pipe.(flush)

BEARINGS ARE REFERENCED TO

Grid North

wey
11/16/05

Describe any record evidence, monument evidence, testimonial evidence or any other material evidence you considered and whether the monument was found or restored through acceptance of an obliterated evidence location.

I found an iron pipe at the corner that had been used in several previous surveys. I accepted this pipe by "common report".

Describe or show any material discrepancy between the location of the restored corner and that of the corner previously restored or reestablished.

None Known.

RECORD OF LAND CORNER PERPETUATION

No. _____

STATE OF WISCONSIN

County of La Crosse } ss.

I, Gary A. Watts, hereby certify that the information shown hereon correctly describes the original corner, resurvey information, evidence found, type of monument found or placed, and witness monuments and accessories used to perpetuate the location of the original or established corner.

Dated this 17 day of Oct., 1983
at La Crosse, Wisconsin.


Gary A. Watts
Registered Land Surveyor
Title

COUNTY		
La Crosse		
TOWN		
Washington		
HIGHWAY		
SECTION	TOWNSHIP	RANGE
2	15 North	5 West
TYPE OF LANDMARK		
1 1/2" iron pipe		


Date of Survey May 1983

Drafted by GAW

Date Oct. 17, 1983

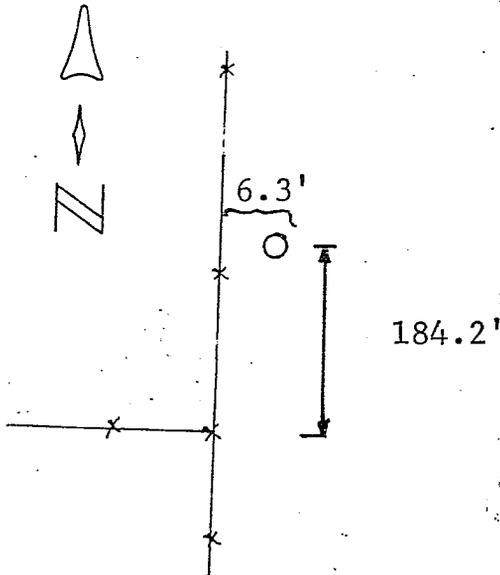

WISCONSIN COORDINATE SYSTEM	
North	Zone
East	
Elevation	Theta Angle
Vertical control order	
Horizontal control order	

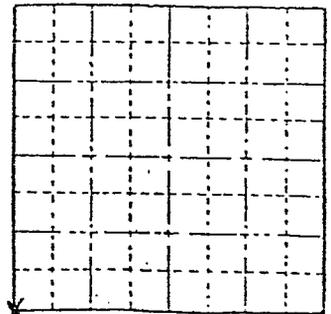

REMARKS: No evidence found. Set corner by double proportionment measurement.

LOCATION SKETCH
(Location of landmark indicated by "x")

