


21505030020

U. S. PUBLIC LAND SURVEY MONUMENT RECORD

SECTION 3 T 15 N, R 5 W, TOWN OF WASHINGTON

LA CROSSE COUNTY

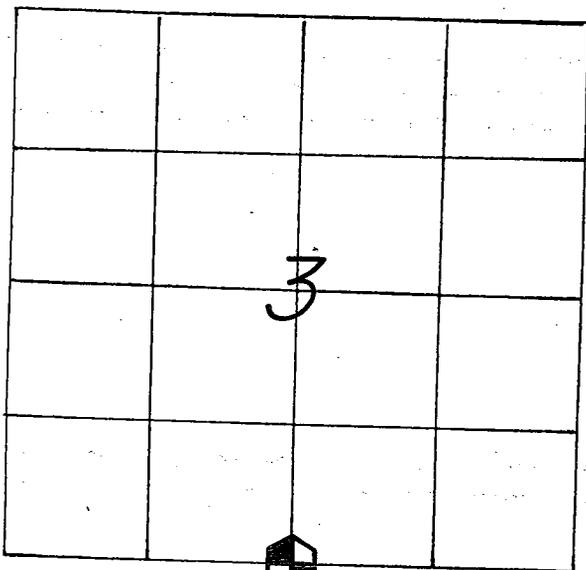

LOCATION OF LANDMARK

CREW: **WILLIAM G. JUNG**
PETER F. FOLLANSBEE
 DATE: 10/07/2005

WISCONSIN COORDINATE SYSTEM	
North	656,657.562
East	1,714,841.518
Theta Angle	
Horiz. Order	
Vert. Order	
DATUM:	1983('91)
TYPE OF LANDMARK	
BRASS CAP LUNDE MARKER.	
BEARINGS ARE REFERENCED TO	
GRID NORTH AS PER SECTION DATA.	

Describe any record evidence, monument evidence, testimonial evidence or any other material evidence you considered and whether the monument was found or restored through acceptance of an obliterated evidence location.

On his 1876 survey Middlebrook shows that there is a "kink" at this corner and that the corner is not equidistant between the section corners. I fit his 1876 mile distance within about 3 inches. Therefore I set the corner in the old East-West line fence and proportionately between the section corners. The proportion was set up with Middlebrook's distances. I set a Lunde at the corner. Old Mr. Kotek, a long time resident to the South, knew nothing about the corner location. Describe or show any material discrepancy between the location of the restored corner and that of the corner previously restored or reestablished.

Chris Fechner has surveys in Sections 3 and 10 that indicate that he needed this corner location for his work. I don't know what he did. In his 1982 survey, Dick Berg did not really commit himself to the location of this corner.

