


U. S. PUBLIC LAND SURVEY MONUMENT RECORD

SECTION 2 T 15 N, R 5 W, TOWN OF WASHINGTON

LA CROSSE COUNTY

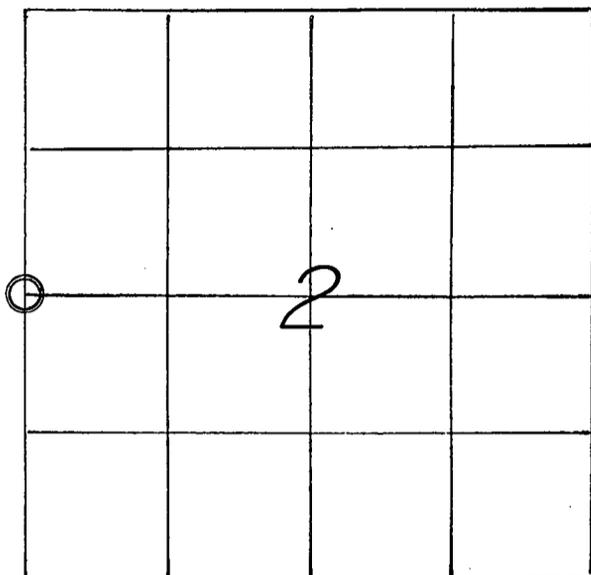

LOCATION OF LANDMARK

WISCONSIN COORDINATE SYSTEM
North
East
Theta Angle
Horiz. Order
Vert. Order
TYPE OF LANDMARK
1" x 30" I.P. in an I.P.
BEARINGS ARE REFERENCED TO

Crew: WILLIAM C. JUNG
 PETER F. FOLLANSBEE
 Date: 7/22/1997

Describe any record evidence, monument evidence, testimonial evidence or any other material evidence you considered and whether the monument was found or restored through acceptance of an obliterated evidence location.


I found an existing iron pipe at the old occupied corner. This pipe had been used as the corner in several previous surveys. I accepted this point as the best available evidence of the original government corner location. I drove another pipe inside of the existing pipe.

Describe or show any material discrepancy between the location of the restored corner and that of the corner previously restored or reestablished.

None Known.

RECORD OF DURABLE WITNESS MONUMENTS

NO	DESCRIPTION	BEARING	DISTANCE
1	SET A 1" x 30" IRON PIPE FLUSH IN A PASTURE	NORTHWESTERLY ±	33.30 FT.
2	DISTANCE TO THE NORTHWEST CORNER OF PHONE BOX	NORTH ±	3.80 FT.
3	SET A NAIL IN THE NW-SIDE 12" CHERRY(DOUBLE BLAZED)	N 52° E	28.23 FT.
4	SET A NAIL IN THE NW-SIDE 8-1/2" W. OAK (UNBLAZED)	N 52° E	49.75 FT.

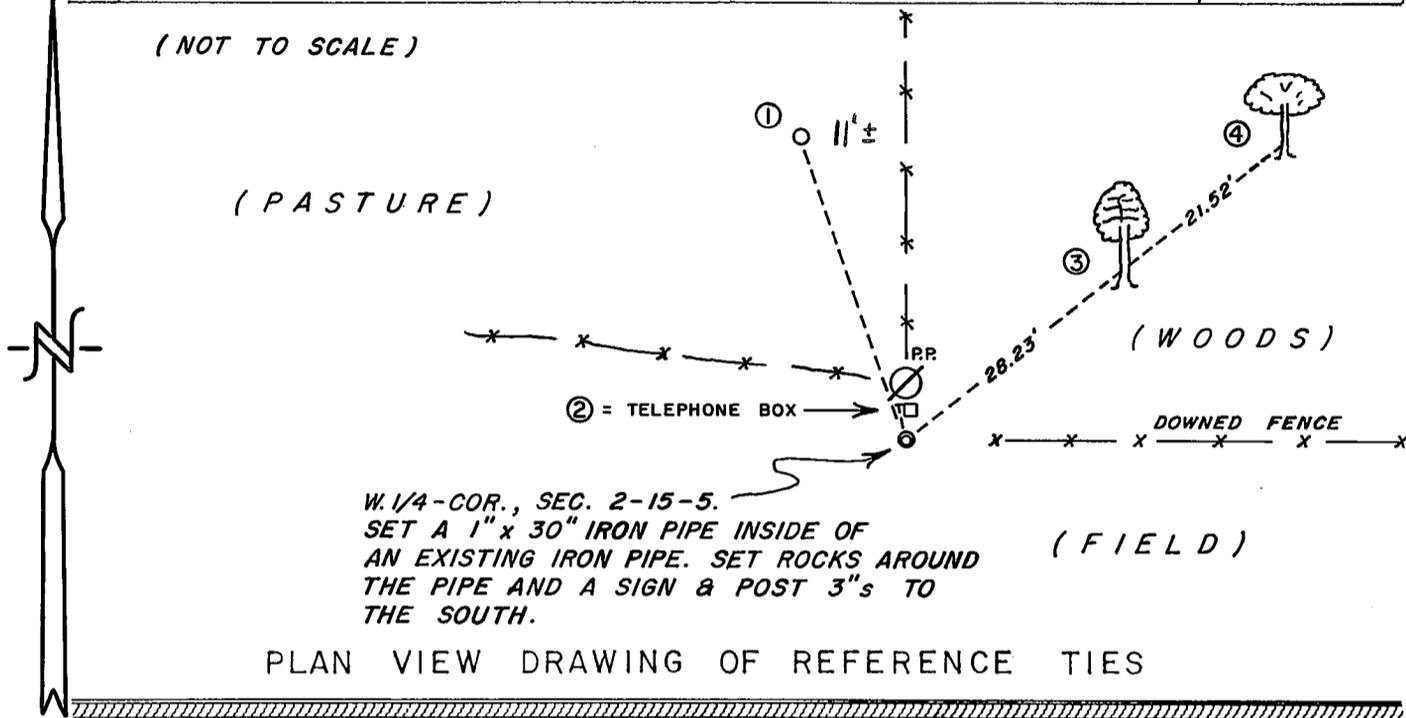


MAP SHOWING DISTANCE AND DIRECTION TO OTHER PUBLIC LAND SURVEY CORNERS USED FOR REESTABLISHING THE CORNER

No section measurements were made by me at this time. The position of this corner was determined by others in previous survey work.

I, William C. Jung, County Surveyor
 HEREBY CERTIFY THAT THE CORNER LOCATION SHOWN ON THIS RECORD WAS DETERMINED BY ME OR UNDER MY DIRECTION AND CONTROL AND THAT THIS U. S. PUBLIC LAND SURVEY MONUMENT RECORD IS CORRECT AND COMPLETE TO THE BEST OF MY KNOWLEDGE AND BELIEF.

William C. Jung 12/9/97
 Signature Date

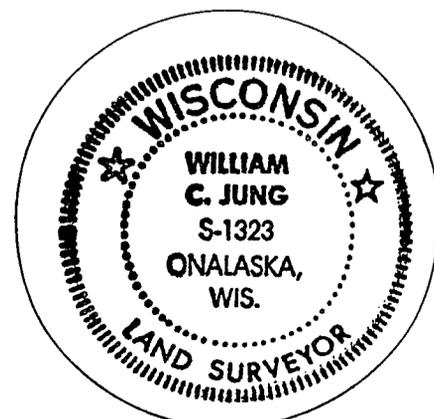

Seal