


21505052000

U. S. PUBLIC LAND SURVEY MONUMENT RECORD

SECTION 5 T 15 N, R 5 W, TOWN OF WASHINGTON

LA CROSSE COUNTY

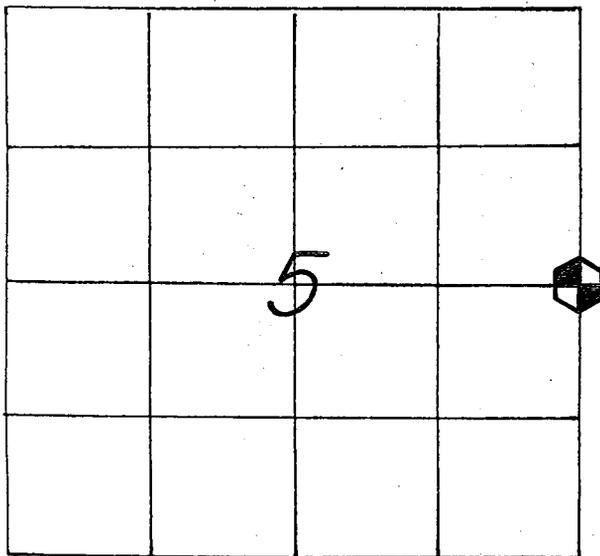

LOCATION OF LANDMARK

CREW: **WILLIAM C. JUNG**
PETER F. FOLLANSBEE
 DATE: **4/09/2007**

WISCONSIN COORDINATE SYSTEM

North **659,452.818**East **1,706,987.456**

Theta Angle

Horiz. Order

Vert. Order

DATUM: **1983('91)**

TYPE OF LANDMARK

BRASS CAP LUNDE MARKER.

BEARINGS ARE REFERENCED TO
GRID NORTH AS PER SECTION DATA.

Describe any record evidence, monument evidence, testimonial evidence or any other material evidence you considered and whether the monument was found or restored through acceptance of an obliterated evidence location.

We found both original bur oak bearing trees living. The one to the northeast is now a 24" tree and the one to the northwest is now a 21" tree. I set the corner using these trees. The corner falls just over 10 feet West of the single proportionate position. I set a Lunde marker at the corner and mounded it with rocks. The kink at this corner in the section line is typical of what I've found in this county while retracing the original government surveys.

Describe or show any material discrepancy between the location of the restored corner and that of the corner previously restored or reestablished.


This may or may not fit Chris Fechner's computed location for this corner back in 2001.

(over)

Note: The nails are all set low near the base of the tree trunk.


RECORD OF DURABLE WITNESS MONUMENTS

NO	DESCRIPTION	MAGNETIC	
		BEARING	DISTANCE
1	SET A NAIL IN N.E.-SIDE OF A 7-1/2" HICKORY	N 57° W	1.60 FT.
2	SET A NAIL IN S.E.-SIDE OF A 10" BURR OAK	N 39° E	23.03 FT.
3	SET A NAIL IN N.W.-SIDE OF A 13" BURR OAK	N 79° E	43.01 FT.
4	SET A NAIL IN S.E.-SIDE OF AN 8" BURR OAK	S 21° W	11.91 FT.

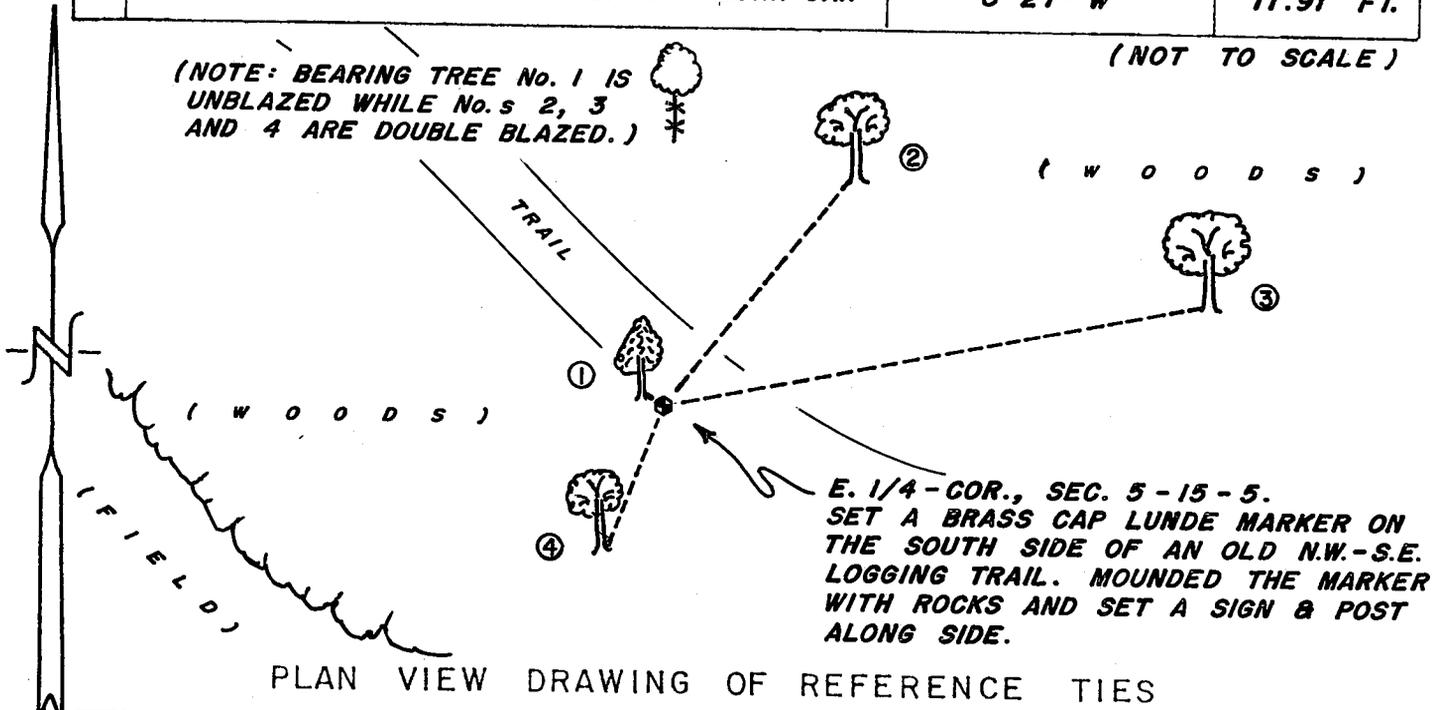

MAP SHOWING DISTANCE AND DIRECTION TO OTHER PUBLIC LAND SURVEY CORNERS USED FOR REESTABLISHING THE CORNER


(GRID BEARINGS AND DISTANCES)
(GRID FACTOR: 0.999898)
(NOT TO SCALE)

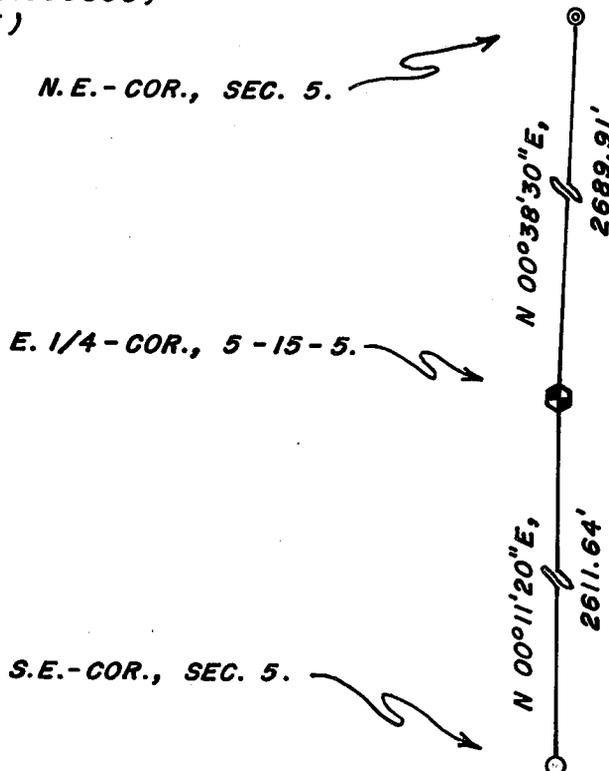

I, WILLIAM C. JUNG, COUNTY SURVEYOR
HEREBY CERTIFY THAT THE CORNER LOCATION SHOWN ON THIS RECORD WAS DETERMINED BY ME OR UNDER MY DIRECTION AND CONTROL AND THAT THIS U. S. PUBLIC LAND SURVEY MONUMENT RECORD IS CORRECT AND COMPLETE TO THE BEST OF MY KNOWLEDGE AND BELIEF.

William C. Jung
Signature

7/17/07
Date

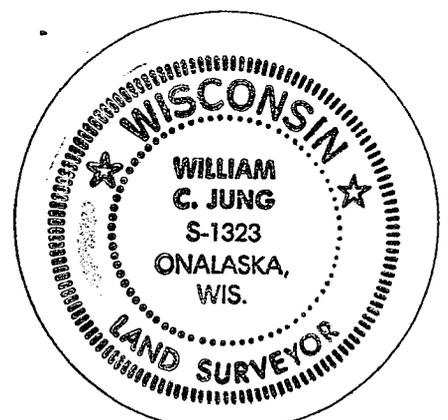

Seal