


## U. S. PUBLIC LAND SURVEY MONUMENT RECORD

SECTION 6 T 15 N, R 5 W, TOWN OF WASHINGTON  
LA CROSSE COUNTY

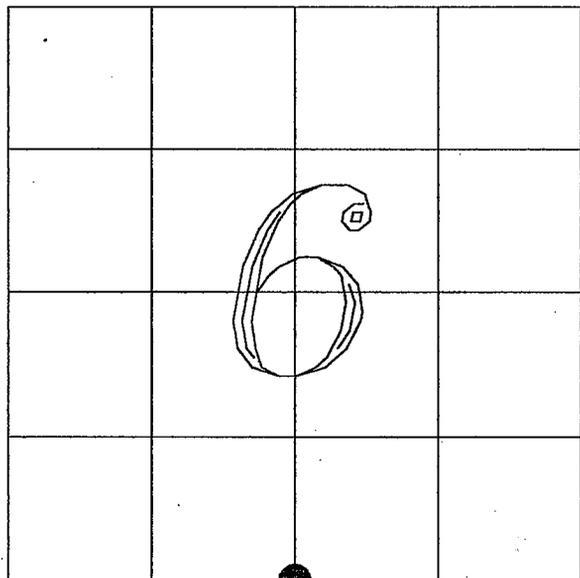

LOCATION OF LANDMARK

CREW: CHRIS FECHNER  
 JOSH NAVE

DATE: 12/04/2001

Describe any record evidence, monument evidence, testimonial evidence, or any other material evidence you considered and whether the monument was found or restored through acceptance of an obliterated evidence location.

*I set this corner near the occupied fence intersection. I considered this the best available evidence. The single proportionate distance does match this corner position with the North-South fence line very well. However, the lost corner position would fall nearly 90 feet South of this position.*

Describe or show any material discrepancy between the location of the restored corner and that of the corner previously restored or reestablished.

*The original government notes state "there is a powerful local attraction in way of the lines in this region".*

WISCONSIN COORDINATE SYSTEM
North
East
Theta Angle
Horiz. Order
Vert. Order
TYPE OF LANDMARK
3/4" X 30" IRON BAR
BEARINGS ARE REFERENCED TO
LA CROSSE COUNTY COORDINATE SYSTEM

