


U. S. PUBLIC LAND SURVEY MONUMENT RECORD

SECTION 8 T 15 N, R 5 W, TOWN OF Washington  
 LA CROSSE COUNTY

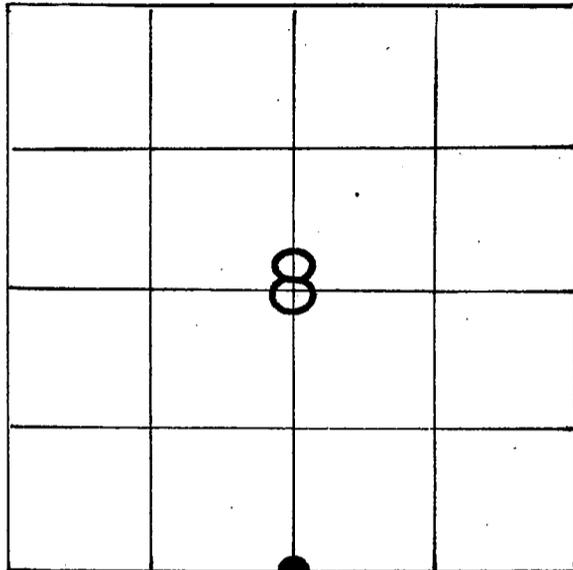

LOCATION OF LANDMARK

Crew: William C. Jung  
 Peter Follansbee  
 Date: 10/2/89

Crew: William C. Jung  
 Peter Follansbee  
 Date: 5/2/00 8/6/08

WISCONSIN COORDINATE SYSTEM
North
East
Theta Angle
Horiz. Order
Vert. Order
TYPE OF LANDMARK
<u>2"x31" iron pipe, 2 3/8" x 37"</u>
BEARINGS ARE REFERENCED TO
<u>Assumed North</u>

Describe any record evidence, monument evidence, testimonial evidence or any other material evidence you considered and whether the monument was found or restored through acceptance of an obliterated evidence location.

To the North is the old Blinn family cemetery. In 1904 Fred Blinn deeded his farm to Hundt (as described in Volume 106 Deeds, Page 53) except for a 35 ft. square parcel in the Southwest corner of the SW-SE. This parcel was reserved for burial purposes. Using this 1904 description, I set the corner by lining in with the old fence to the North and measuring 35 feet South from the NW corner of the cemetery. The cemetery fences are very old. I would assume that the location of the corner was known when the fences were built. The South fence is probably off to the North because of the highway cut. Describe or show any material discrepancy between the location of the restored corner and that of the corner previously restored or reestablished.


If the P.K. nail 13.14 feet to the South in the road is intended to be the corner, I do not agree with it.

5/2/00 We reset the pipe which had been knocked out.  
8/6/08 " set a "

RECORD OF DURABLE WITNESS MONUMENTS

NO	DESCRIPTION	BEARING	DISTANCE
1	Concrete post at the NW corner of cemetery	North <sub>±</sub>	35'
2	Set new I.B. <del>and cap</del> <del>Existing P.K. nail in Hass Road centerline</del>	South <sub>±</sub>	<del>43.08</del> <del>43.14</del>
3	To <del>P.K.</del> <sup>new</sup> nail in unblazed <del>24"</del> <sup>25 1/2"</sup> tamarack, 27"	-----	<del>21.65</del> <del>21.67</del>
4	To center of concrete fence post	-----	34.35'


13'  
21.74'

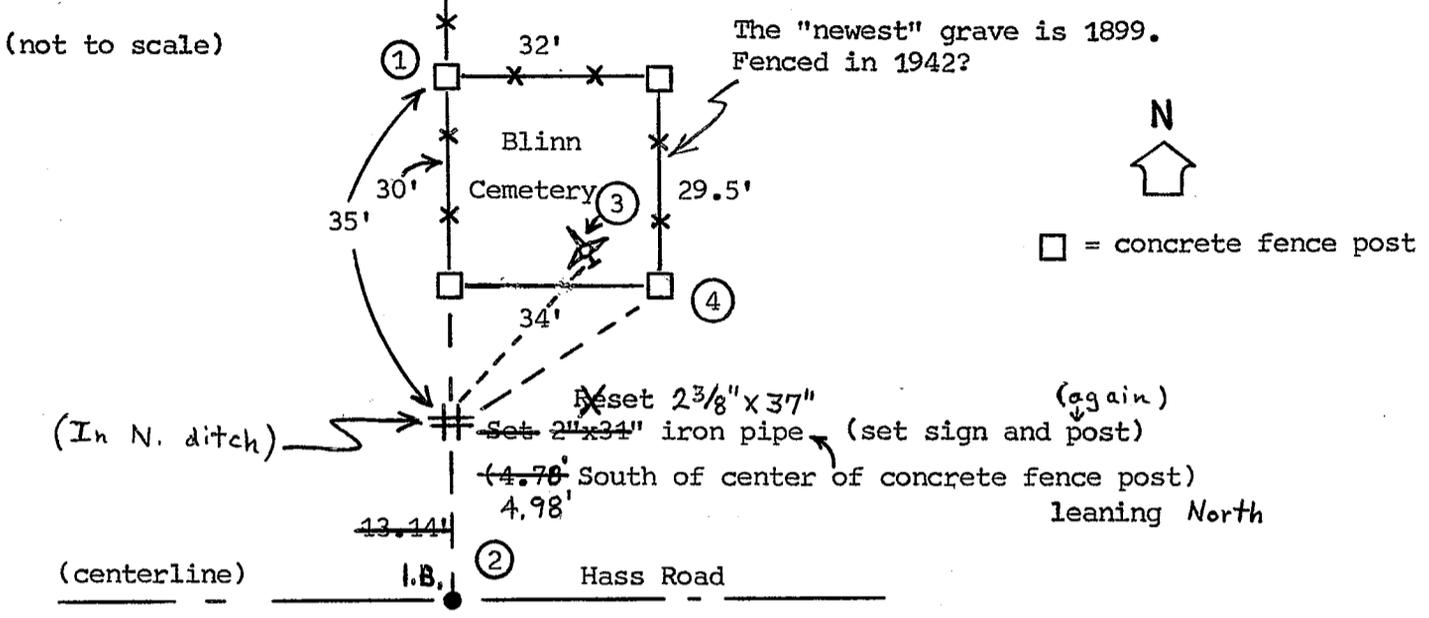

PLAN VIEW DRAWING OF REFERENCE TIES



MAP SHOWING DISTANCE AND DIRECTION TO OTHER PUBLIC LAND SURVEY CORNERS USED FOR REESTABLISHING THE CORNER

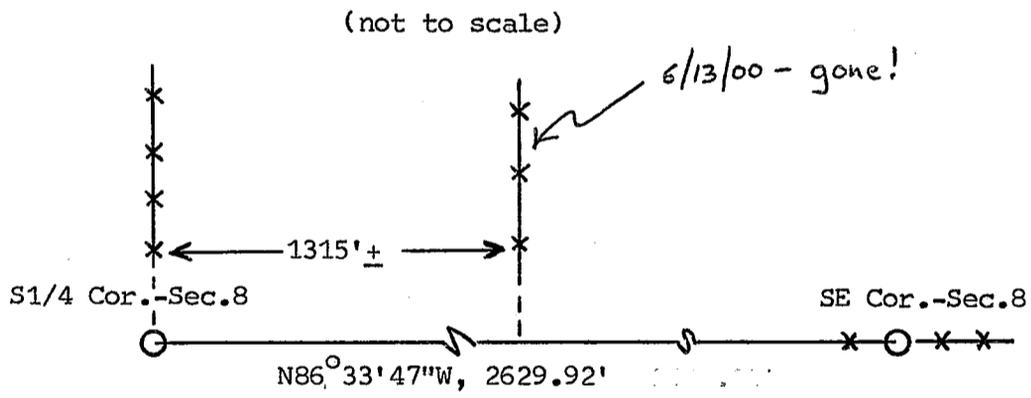


I, William C. Jung, Deputy County Surveyor,  
 HEREBY CERTIFY THAT THE CORNER LOCATION SHOWN ON THIS RECORD  
 WAS DETERMINED BY ME OR UNDER MY DIRECTION AND CONTROL AND  
 THAT THIS U. S. PUBLIC LAND SURVEY MONUMENT RECORD IS CORRECT  
 AND COMPLETE TO THE BEST OF MY KNOWLEDGE AND BELIEF.

William C. Jung  
 Signature

October 2, 1989  
 Date

Revised: 6/13/00  
 " 11/21/08

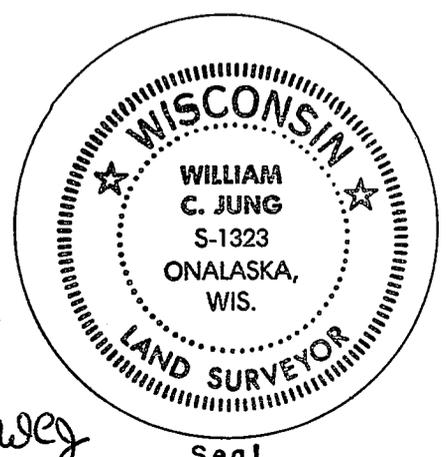

Seal