


U. S. PUBLIC LAND SURVEY MONUMENT RECORD

SECTION 16 T 15 N, R 5 W, TOWN OF WASHINGTON

LA CROSSE COUNTY

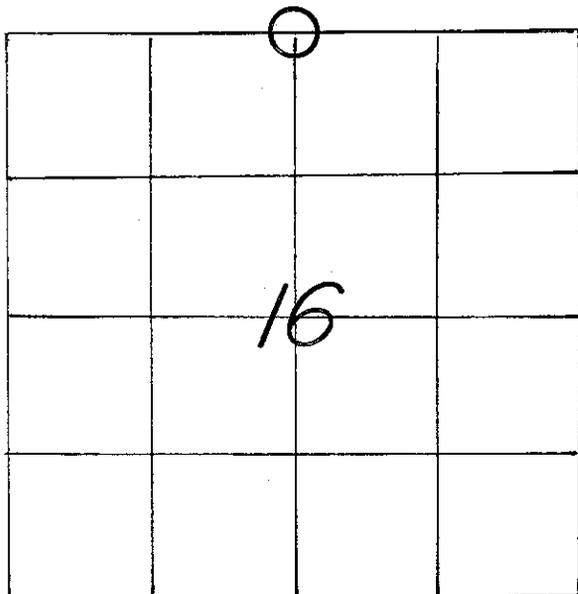

LOCATION OF LANDMARK

CREW: **BRYAN H. MEYER**  
**PETER F. FOLLANSBEE**  
 DATE: **4/21/2009**

WISCONSIN COORDINATE SYSTEM	
North	<b>651,483.360</b>
East	<b>1,709,481.164</b>
Theta Angle	
Horiz. Order	
Vert. Order	
DATUM:	<b>NAD 1983('91)</b>
TYPE OF LANDMARK	
<b>1" IRON PIPE</b>	
BEARINGS ARE REFERENCED TO	
<b>GRID NORTH AS PER SECTION DATA.</b>	


Describe any record evidence, monument evidence, testimonial evidence or any other material evidence you considered and whether the monument was found or restored through acceptance of an obliterated evidence location.

Describe or show any material discrepancy between the location of the restored corner and that of the corner previously restored or reestablished.

RECORD OF DURABLE WITNESS MONUMENTS


MAGNETIC

NO	DESCRIPTION	BEARING	DISTANCE
1	EX. P.K. NAIL IN N.E.-SIDE OF A 21" BLACK OAK	N 15° W	43.65 FT.
2	SET A NAIL IN N.-SIDE OF A 14" HICKORY	S 68° W	52.56 FT.
3	EX. P.K. NAIL IN N.-SIDE OF A 12" HICKORY	S 62° W	37.86 FT.
4	NORTH EDGE OF A 33" UNBLAZED WHITE OAK	SOUTH ±	0.6 FT. ±

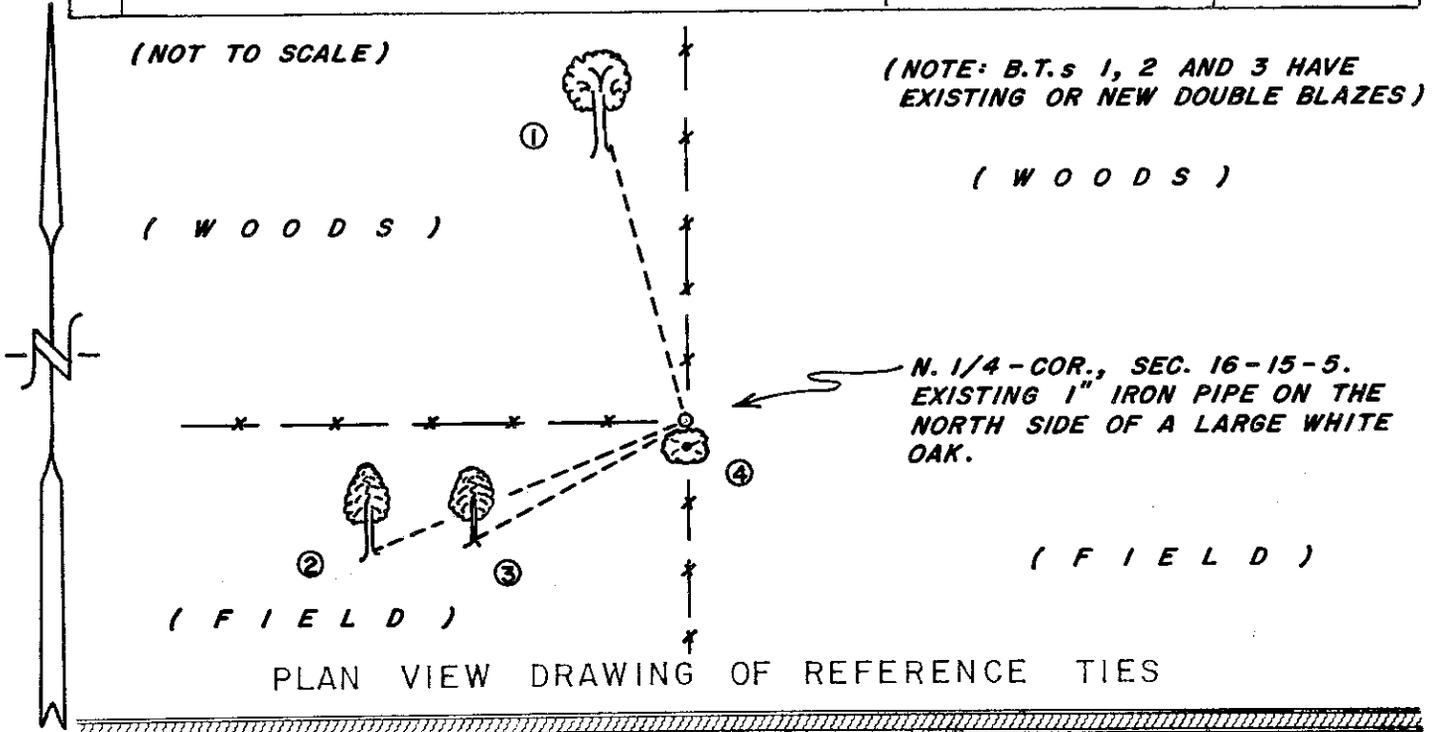


MAP SHOWING DISTANCE AND DIRECTION TO OTHER PUBLIC LAND SURVEY CORNERS USED FOR REESTABLISHING THE CORNER

(GRID BEARINGS AND DISTANCES)  
 (GRID FACTOR: 0.999898438)  
 (NOT TO SCALE)

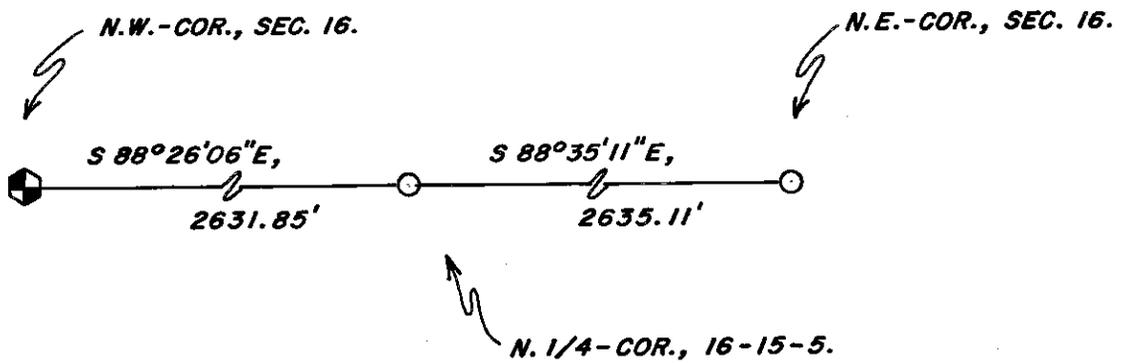

I, BRYAN H. MEYER, COUNTY SURVEYOR  
 HEREBY CERTIFY THAT THE CORNER LOCATION SHOWN ON THIS RECORD WAS DETERMINED BY ME OR UNDER MY DIRECTION AND CONTROL AND THAT THIS U. S. PUBLIC LAND SURVEY MONUMENT RECORD IS CORRECT AND COMPLETE TO THE BEST OF MY KNOWLEDGE AND BELIEF.

Bryan H. Meyer Signature July 14, 2010 Date

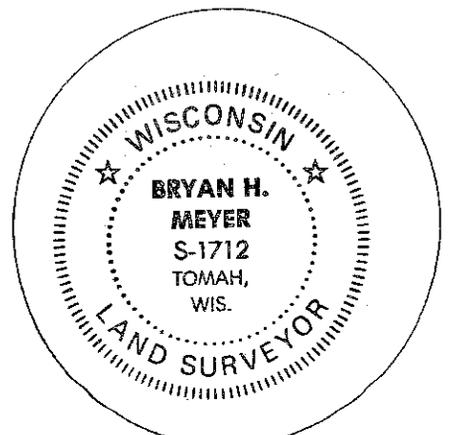


Seal

21505090020

## U. S. PUBLIC LAND SURVEY MONUMENT RECORD

SECTION 16 T 15 N, R 5 W, TOWN OF Washington

LA CROSSE COUNTY

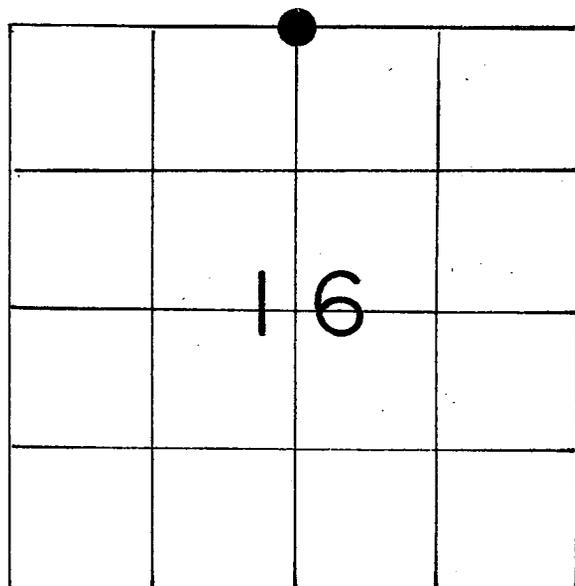

LOCATION OF LANDMARK

Crew: William C. Jung  
Peter FollansbeeDate: 12/8/89

Describe any record evidence, monument evidence, testimonial evidence or any other material evidence you considered and whether the monument was found or restored through acceptance of an obliterated evidence location.

I accepted the occupied fence corner as the best available evidence of the original government corner position and monumented it with an iron pipe on the North side of an old white oak.

Describe or show any material discrepancy between the location of the restored corner and that of the corner previously restored or reestablished.

Kaye Don Pederson's map of Section 9 shows the corner in the center of the tree. I feel that it comes out on the North side.

WISCONSIN COORDINATE SYSTEM

North

East

Theta Angle

Horiz. Order

Vert. Order

TYPE OF LANDMARK


1" iron pipe on North side of tree

BEARINGS ARE REFERENCED TO

Assumed North

RECORD OF DURABLE WITNESS MONUMENTS


NO	DESCRIPTION	Magnetic BEARING	DISTANCE
1	P.K. in double blazed 13" black oak	N15°W	slope=43.63
2	" " " " 4" hickory	S89°W	24.20
3	" " " " 7" "	S62°W	37.86
4	North edge of unblazed 25" white oak	-----	0.6

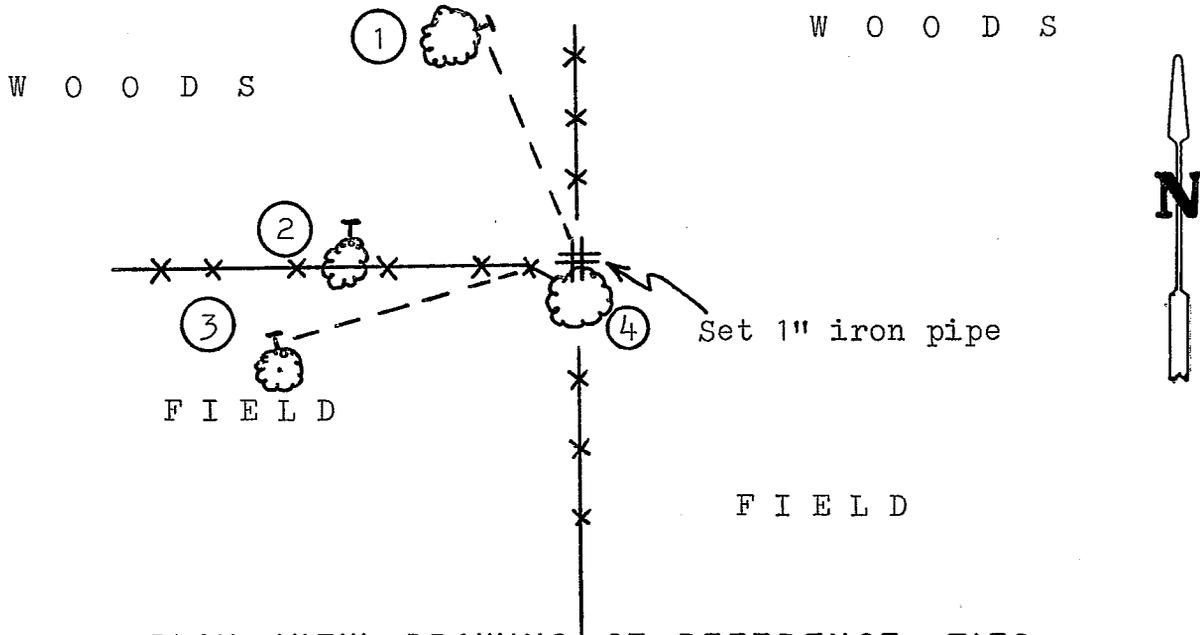

PLAN VIEW DRAWING OF REFERENCE TIES

MAP SHOWING DISTANCE AND DIRECTION TO OTHER PUBLIC LAND SURVEY CORNERS USED FOR REESTABLISHING THE CORNER

(not to scale)

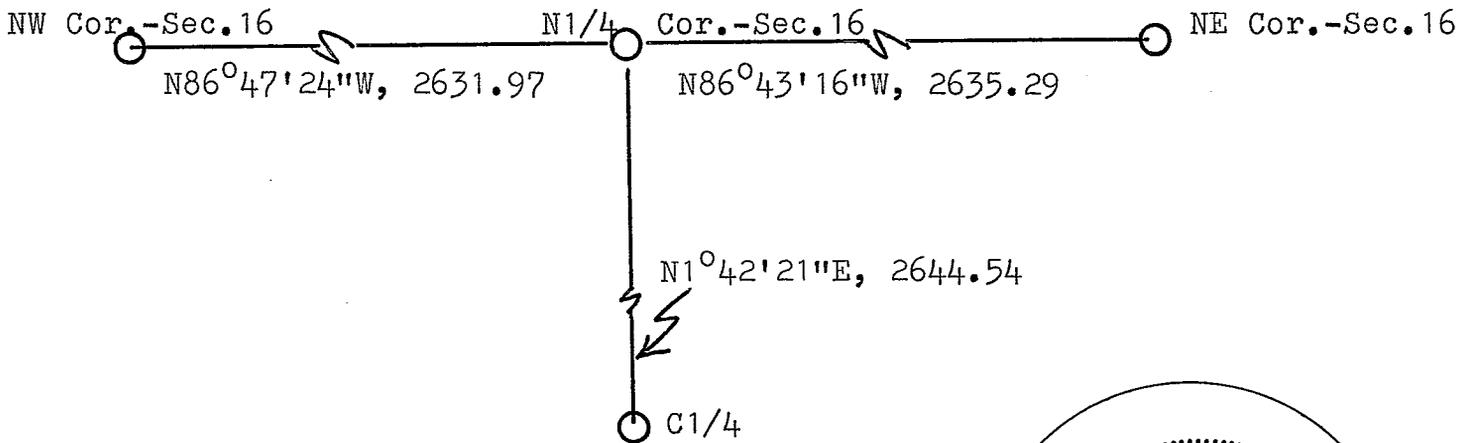

I, William C. Jung, Deputy County Surveyor,  
 HEREBY CERTIFY THAT THE CORNER LOCATION SHOWN ON THIS RECORD  
 WAS DETERMINED BY ME OR UNDER MY DIRECTION AND CONTROL AND  
 THAT THIS U. S. PUBLIC LAND SURVEY MONUMENT RECORD IS CORRECT  
 AND COMPLETE TO THE BEST OF MY KNOWLEDGE AND BELIEF.

William C. Jung  
 Signature

December 15, 1989  
 Date



Seal