


21505100000

U. S. PUBLIC LAND SURVEY MONUMENT RECORD

SECTION 10 T 15 N, R 5 W, TOWN OF WASHINGTON

LA CROSSE COUNTY

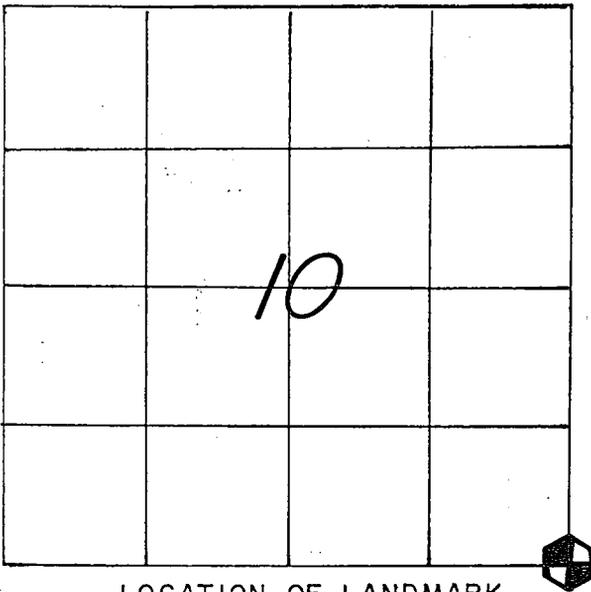

LOCATION OF LANDMARK

CREW: **WILLIAM C. JUNG**
PETER F. FOLLANSBEE
 DATE: **10/22/2003**

WISCONSIN COORDINATE SYSTEM

North **651,439.576**East **1,717,370.066**

Theta Angle

Horiz. Order

Vert. Order

DATUM: **NAD 1983('91)**

TYPE OF LANDMARK

BRASS CAP LUNDE MARKER.

BEARINGS ARE REFERENCED TO

GRID NORTH AS PER SECTION DATA.

Describe any record evidence, monument evidence, testimonial evidence or any other material evidence you considered and whether the monument was found or restored through acceptance of an obliterated evidence location.

I found what I believe is the original Northeast bearing tree. At six foot above the ground the circumference is over ten feet. Below that height the circumference is greater where the tree is knarled. The interior of the tree is partially hollow and rotted. Inside the tree is an area on the South side that appears to indicate an old blaze mark. On it one can also see what looks like an axe mark. This could be the original blaze or maybe the results of a later surveyor cutting into the tree to identify it. I am confident that this is the original and set the corner off of it. After discussing this with Chris Fechner, I removed his iron pipe 6.7 feet to the North. I monumented the corner with a Lunde marker in a rock pile.

Describe or show any material discrepancy between the location of the restored corner and that of the corner previously restored or reestablished.

NONE KNOWN.

