


U. S. PUBLIC LAND SURVEY MONUMENT RECORD

SECTION 12 T 15 N, R 5 W, TOWN OF WASHINGTON
LACROSSE COUNTY

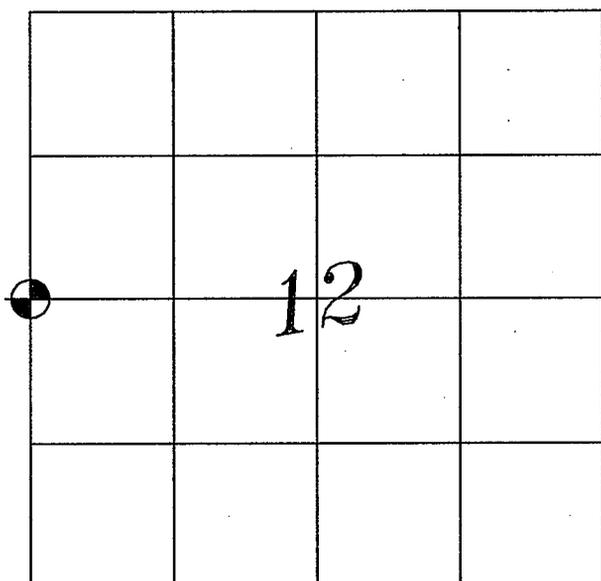

LOCATION OF LANDMARK

CREW: Chris Fechner
 Randy Corlis

DATE: 4/26/05

Describe any record evidence, monument evidence, testimonial evidence, or any other material evidence you considered and whether the monument was found or restored through acceptance of an obliterated evidence location.

- We found a strong East – West fenceline and a diagonal fenceline that terminates very near the calculated corner. The area was searched for original B.T.'s and any unrecorded stones. We found nothing except ancient fenceline and piles of old fence posts near the corner location.

Describe or show any material discrepancy between the location of the restored corner and that of the corner previously restored or reestablished.

I set the corner 10.63' South of the Midpoint distance in an existing fenceline. The corner is 37 feet East of the straight line distance.

WISCONSIN COORDINATE SYSTEM

North

East

Theta Angle

Horiz. Order

Vert. Order

TYPE OF LANDMARK

3/4" x 30" Iron Bar

BEARINGS ARE REFERENCED TO
 LACROSSE COUNTY
 COORDINATE SYSTEM

