


U. S. PUBLIC LAND SURVEY MONUMENT RECORD

SECTION 13 T 15 N, R 5 W, TOWN OF WASHINGTON
LA CROSSE COUNTY

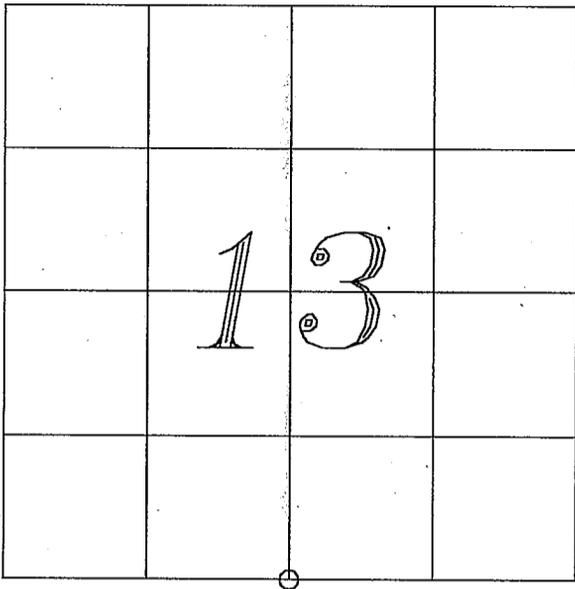

LOCATION OF LANDMARK

CREW: CHRIS FECHNER
 JOSH NAVE

DATE: 8/23/01

Describe any record evidence, monument evidence, testimonial evidence, or any other material evidence you considered and whether the monument was found or restored through acceptance of an obliterated evidence location.

I SET THIS CORNER BY LAW AT THE MIDPOINT BETWEEN THE SE & SW CORNERS OF SECTION 13. THE LOCATION FITS THE GOVERNMENT NOTES LOCATIVE CALLS FOR THE CREEK AND THE HILLSIDE. FENCE LINE OCCUPATION TO THE NORTH MATCHES THE EAST-WEST LOCATION VERY WELL.

Describe or show any material discrepancy between the location of the restored corner and that of the corner previously restored or reestablished.

NONE KNOWN

WISCONSIN COORDINATE SYSTEM
North
East
Theta Angle
Horiz. Order
Vert. Order
TYPE OF LANDMARK
3/4" X 30" IRON BAR
BEARINGS ARE REFERENCED TO LA CROSSE COUNTY COORDINATE SYSTEM

