


LA CROSSE COUNTY, WISCONSIN

U. S. PUBLIC LAND SURVEY MONUMENT RECORD

WEST ¼ CORNER, SECTION 15, T15N, R5W, TOWN OF WASHINGTON

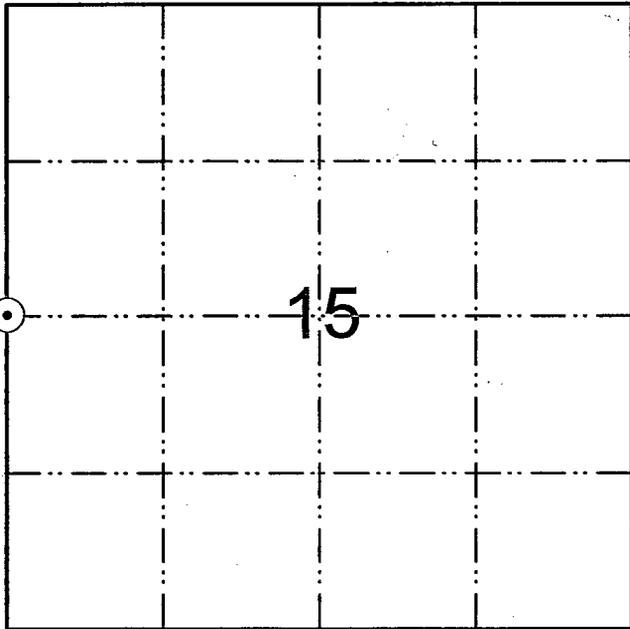

TYPE OF MONUMENT:

SET DRILL HOLE IN ROCK

WISCONSIN COORDINATE SYSTEM (NAD 1983('91))

NORTH: 648,803.229

EAST: 1,712,133.189

BEARINGS REFERENCED TO:

MAGNETIC NORTH

CREW: Bryan Meyer and Pete Follansbee

DATE: June 9, 2009

WEATHER: Mostly Sunny, 63±°


⊙ LOCATION OF LANDMARK

PLAN VIEW OF REFERENCE TIES: (NO SCALE)

NOTE: Ties 1 and 2 are double blazed. Ties 3 and 4 fall in the road shoulder.

CORNER DESCRIPTION:


SET DRILL HOLE IN EXISTING ROCK;
SET RAILROAD SPIKE 0.15' SOUTHWEST
OF DRILL HOLE AT EDGE OF ROCK.

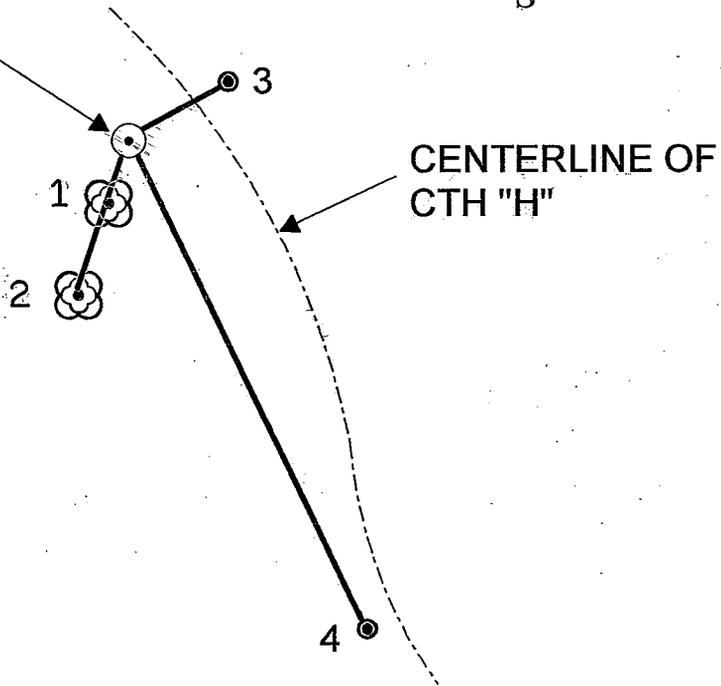

WITNESS TIES:

- 1 = Set nail & washer on NW side of 3" White Oak S17°W, 2.66'
- 2 = Set nail & washer on NW side of 7½" Hickory S18°W, 11.53'
- 3 = Set ¾"x30" round iron bar with red plastic cap N60°E, 59.39'
- 4 = Set ¾"x30" round iron bar with red plastic cap S26°E, 303.88'

NO SCALE
GRID BEARINGS AND DISTANCES

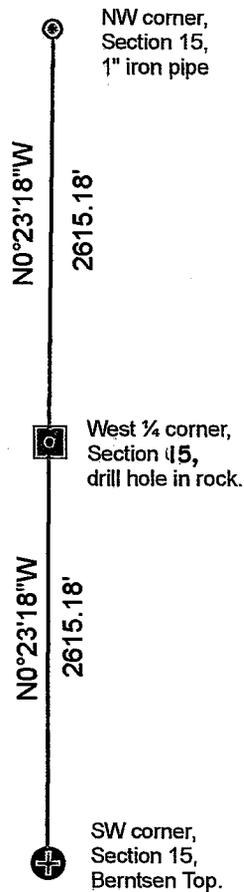

DESCRIBE ANY RECORD EVIDENCE, MONUMENT EVIDENCE, TESTIMONIAL EVIDENCE OR ANY OTHER MATERIAL EVIDENCE YOU CONSIDERED AND WHETHER THE MONUMENT WAS FOUND OR RESTORED THROUGH ACCEPTANCE OF AN OBLITERATED EVIDENCE LOCATION:

Set this corner on line and at proportionate distance between the Northwest and Southwest corners of Section 15.

DESCRIBE OR SHOW ANY MATERIAL DISCREPANCY BETWEEN THE LOCATION OF THE RESTORED CORNER AND THAT OF THE CORNER PREVIOUSLY RESTORED OR REESTABLISHED

None.

CERTIFICATE:

I, Bryan H. Meyer, County Surveyor, hereby certify that the corner location shown on this record was determined by me or under my direction and control and that this U. S. Public Land Survey Monument Record is correct and complete to the best of my knowledge and belief.


Bryan H. Meyer, County Surveyor

2/15/2010
Date

