


U. S. PUBLIC LAND SURVEY MONUMENT RECORD

SECTION 16 T 15 N, R 5 W, TOWN OF Washington
 LA CROSSE COUNTY

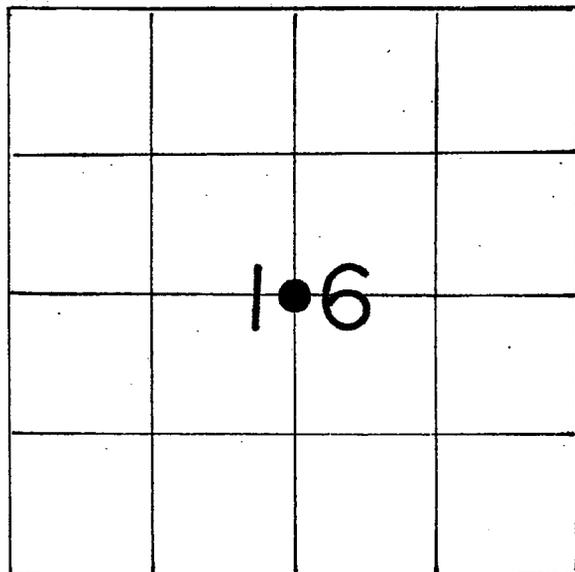

LOCATION OF LANDMARK

Crew: William C. Jung
 Peter Follansbee

Date: 12/7/89

WISCONSIN COORDINATE SYSTEM
North
East
Theta Angle
Horiz. Order
Vert. Order
TYPE OF LANDMARK
2" iron pipe
BEARINGS ARE REFERENCED TO
Assumed North


Describe any record evidence, monument evidence, testimonial evidence or any other material evidence you considered and whether the monument was found or restored through acceptance of an obliterated evidence location.

The old fence corner at the occupied center of section appears to be an old center of section set in an irregular fashion many years ago. This corner falls about 537' South of the centerline of S.T.H. "33". This distance of 537' fits many deeds around the Newburg Corners area. Highway deeds from 1931 call for 534'. This occupied corner also best fits the evidence found in the NW1/4 and NE1/4. As I have done in other isolated cases in LaCrosse County, I am accepting this occupied corner as the best available evidence of an old corner set in an irregular fashion. This was not all that uncommon in Wisconsin years ago. To not accept this corner would cause severe title problems. I set a 2" iron pipe. Describe or show any material discrepancy between the location of the restored corner and that of the corner previously restored or reestablished.

This corner falls about 16' South and 10' West of the true center of section.

RECORD OF DURABLE WITNESS MONUMENTS


NO	DESCRIPTION	BEARING	DISTANCE
1	Set 1"x28" iron pipe	North _±	17.47
2	" " " "	East _±	14.76
3	" " " "	South _±	16.06
4	" " " "	West _±	17.80

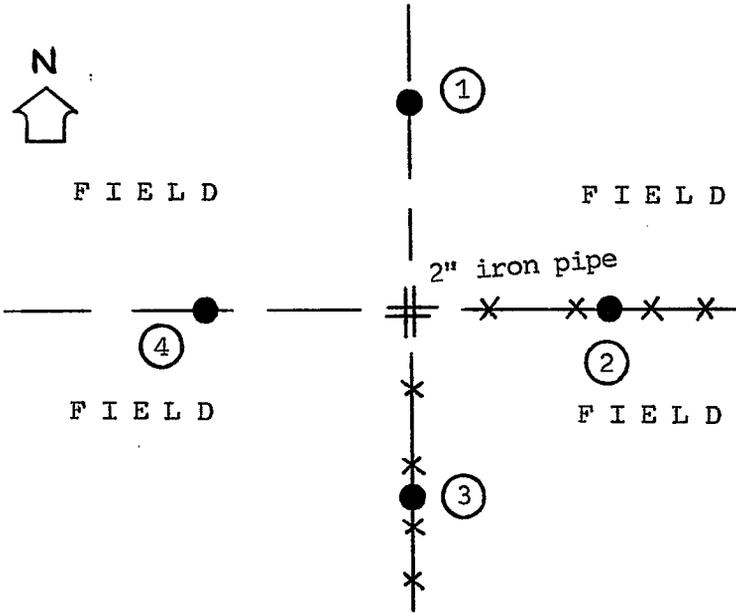

PLAN VIEW DRAWING OF REFERENCE TIES

MAP SHOWING DISTANCE AND DIRECTION TO OTHER PUBLIC LAND SURVEY CORNERS USED FOR REESTABLISHING THE CORNER


(not to scale)

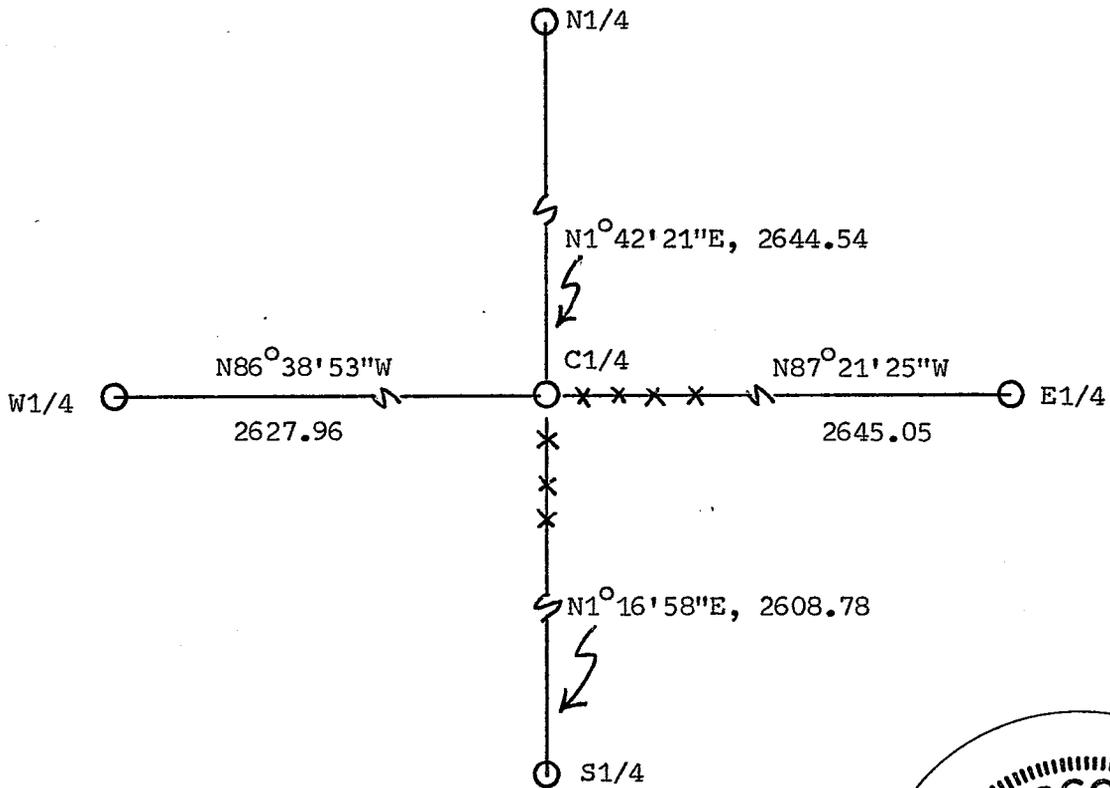

I, William C. Jung, Deputy County Surveyor,
 HEREBY CERTIFY THAT THE CORNER LOCATION SHOWN ON THIS RECORD
 WAS DETERMINED BY ME OR UNDER MY DIRECTION AND CONTROL AND
 THAT THIS U. S. PUBLIC LAND SURVEY MONUMENT RECORD IS CORRECT
 AND COMPLETE TO THE BEST OF MY KNOWLEDGE AND BELIEF.

William C. Jung
 Signature

December 15, 1989
 Date

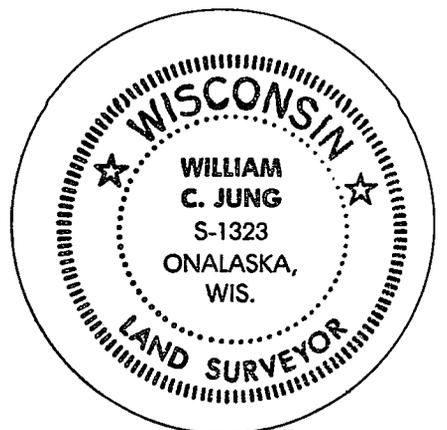

Seal