


U. S. PUBLIC LAND SURVEY MONUMENT RECORD

SECTION 16 T 15 N, R 5 W, TOWN OF Washington
 LA CROSSE COUNTY

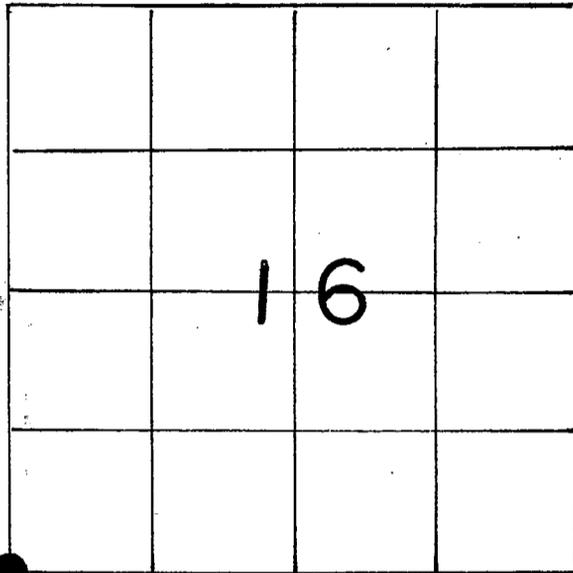

LOCATION OF LANDMARK

WISCONSIN COORDINATE SYSTEM
North
East
Theta Angle
Horiz. Order
Vert. Order
TYPE OF LANDMARK
1" iron pipe railroad spike
BEARINGS ARE REFERENCED TO
Assumed North

Crew: William C. Jung
 Peter Follansbee
 Date: 12/7/89

Crew: William C. Jung
 Peter Follansbee
 Date: 4/24/97

Describe any record evidence, monument evidence, testimonial evidence or any other material evidence you considered and whether the monument was found or restored through acceptance of an obliterated evidence location.

The old W.P.A. books indicate that the old Stein family burial plot to the Northwest was surveyed for description purposes in May of 1940. I set the section corner using this description. This fits the section measurements very well. I set a 1" iron pipe on the West shoulder of the road, buried down in the gravel.


The iron pipe was either covered up or knocked ^{out} during the repaving of "162" last year. A railroad spike was set at the corner.

Describe or show any material discrepancy between the location of the restored corner and that of the corner previously restored or reestablished.

None known.


RECORD OF DURABLE WITNESS MONUMENTS

NO	DESCRIPTION	BEARING	DISTANCE
1	To the top center of the Stein headstone	N59°W ±	slope=72.45
2	Set 1"x28" iron pipe	West ±	41.02
3	" " " "	East ±	92.72
4	Existing iron bar on R/W	N0°11'10"W	1319.02

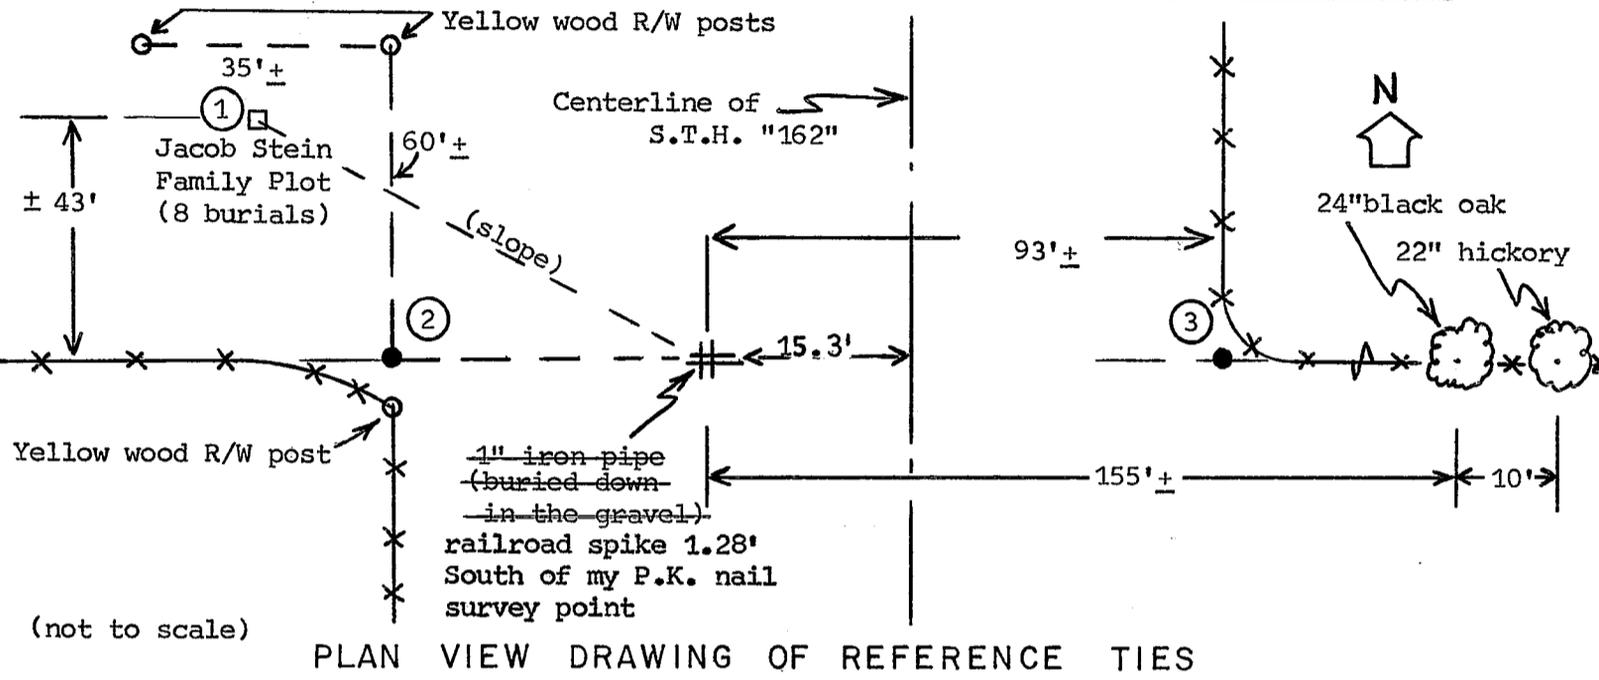

MAP SHOWING DISTANCE AND DIRECTION TO OTHER PUBLIC LAND SURVEY CORNERS USED FOR REESTABLISHING THE CORNER


(not to scale)

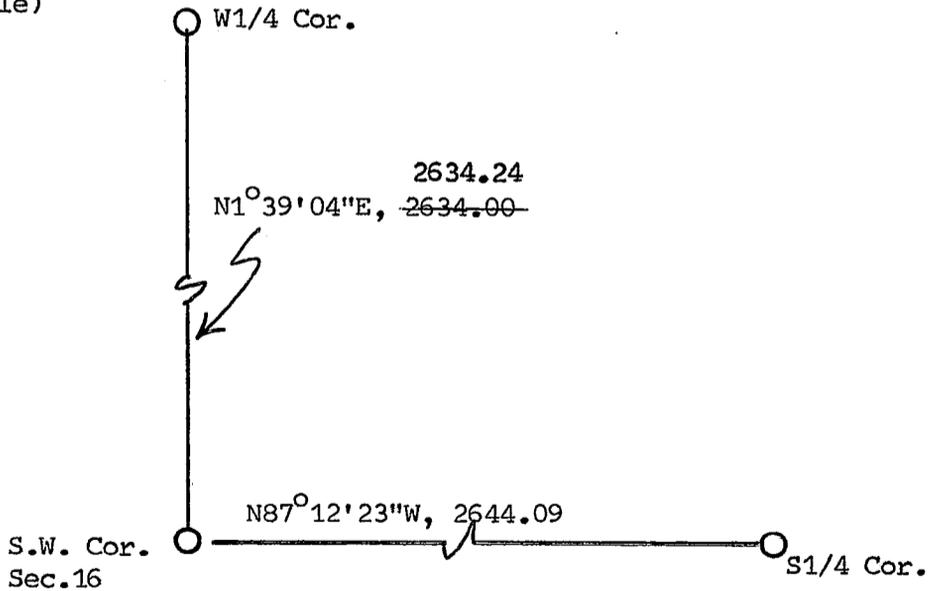

I, William C. Jung, Deputy County Surveyor,
 HEREBY CERTIFY THAT THE CORNER LOCATION SHOWN ON THIS RECORD
 WAS DETERMINED BY ME OR UNDER MY DIRECTION AND CONTROL AND
 THAT THIS U. S. PUBLIC LAND SURVEY MONUMENT RECORD IS CORRECT
 AND COMPLETE TO THE BEST OF MY KNOWLEDGE AND BELIEF.

William C. Jung 12/14/89
 Signature Date

Revised: 6/13/97 *wcj*

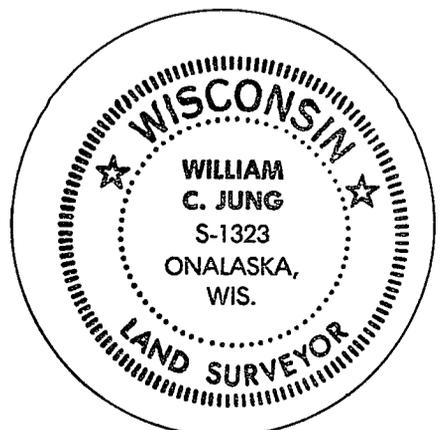

Seal