


U. S. PUBLIC LAND SURVEY MONUMENT RECORD

SECTION 17 T 15 N, R 5 W, TOWN OF WASHINGTON

LA CROSSE COUNTY

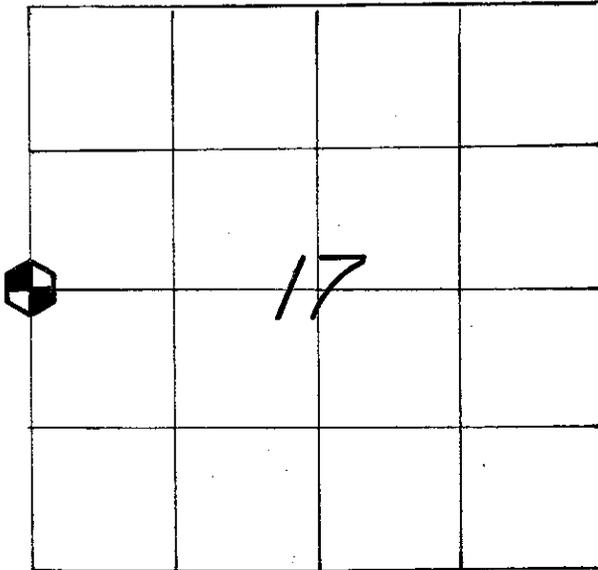

LOCATION OF LANDMARK

CREW: **BRYAN H. MEYER**
PETER F. FOLLANSBEE
 DATE: **7/22/2009**

WISCONSIN COORDINATE SYSTEM

North **649,062.147**East **1,701,556.699**

Theta Angle

Horiz. Order

Vert. Order

DATUM: NAD 1983('91)

TYPE OF LANDMARK

BRASS CAP LUNDE MARKER.

BEARINGS ARE REFERENCED TO


GRID NORTH AS PER SECTION DATA

Describe any record evidence, monument evidence, testimonial evidence or any other material evidence you considered and whether the monument was found or restored through acceptance of an obliterated evidence location.


Describe or show any material discrepancy between the location of the restored corner and that of the corner previously restored or reestablished.

RECORD OF DURABLE WITNESS MONUMENTS

NO	DESCRIPTION	BEARING	DISTANCE
1	SET A 3/4" x 30" IRON BAR WITH A RED PLASTIC CAP	WEST ±	32.88 FT.
2	SET A 3/4" x 30" IRON BAR	NORTH ±	12.69 FT.
3	SET A 3/4" x 30" IRON BAR WITH A RED PLASTIC CAP	EAST ±	33.06 FT.
4	EX. 1" IRON PIPE	S 07° E	41.50

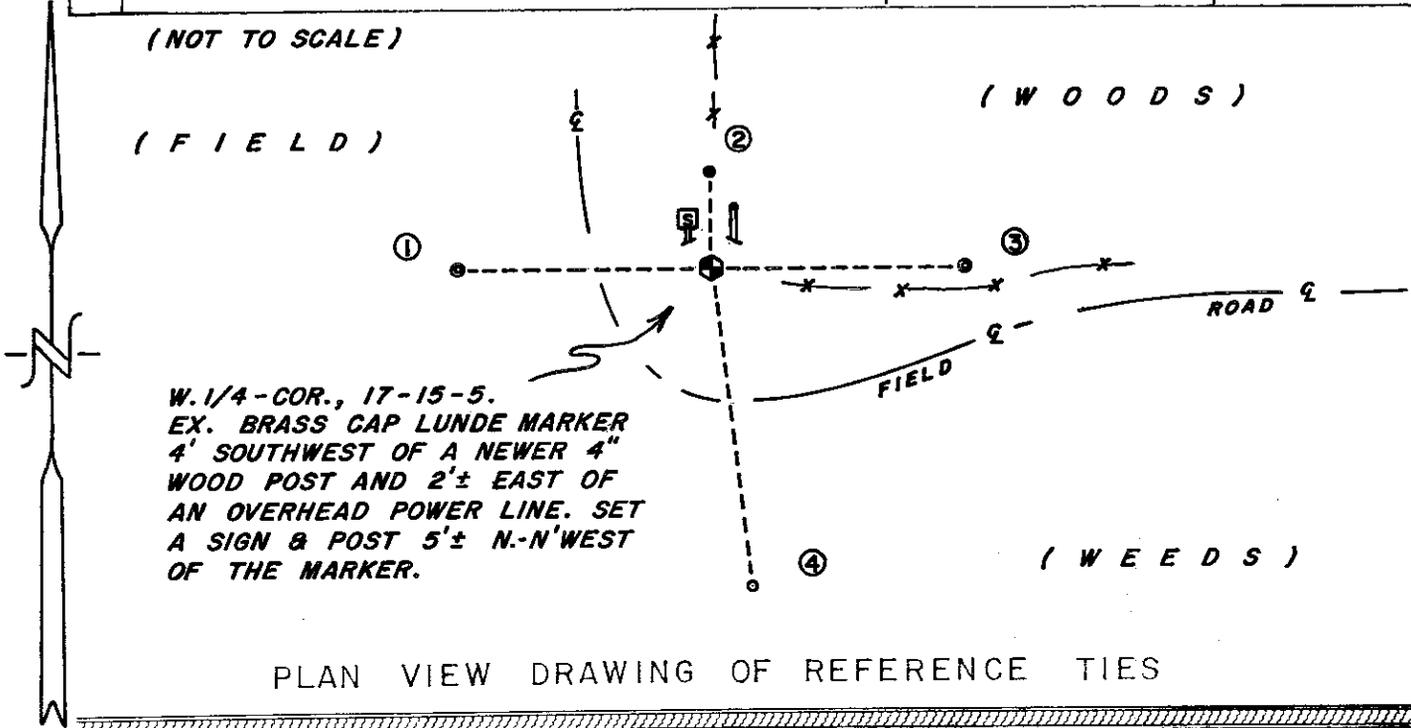


MAP SHOWING DISTANCE AND DIRECTION TO OTHER PUBLIC LAND SURVEY CORNERS USED FOR REESTABLISHING THE CORNER

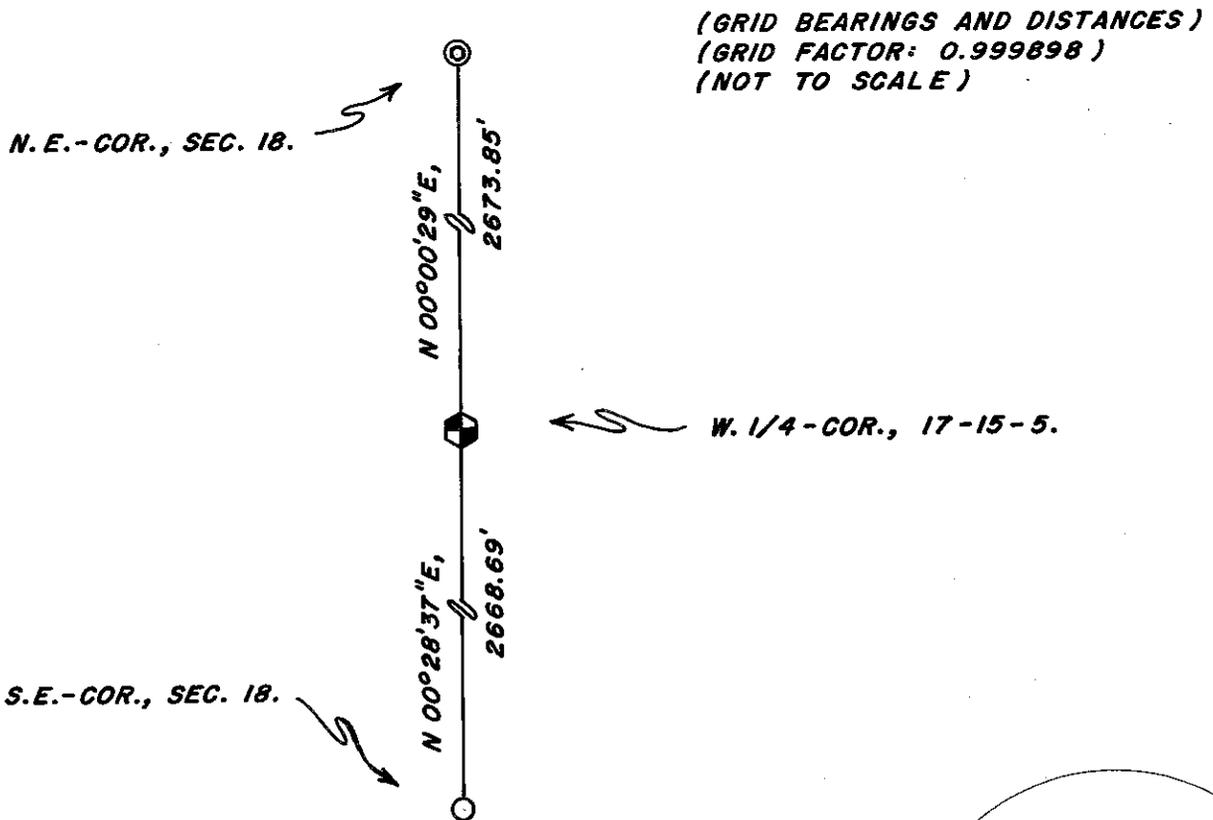

I, BRYAN H. MEYER, COUNTY SURVEYOR
HEREBY CERTIFY THAT THE CORNER LOCATION SHOWN ON THIS RECORD
WAS DETERMINED BY ME OR UNDER MY DIRECTION AND CONTROL AND
THAT THIS U. S. PUBLIC LAND SURVEY MONUMENT RECORD IS CORRECT
AND COMPLETE TO THE BEST OF MY KNOWLEDGE AND BELIEF.

Bryan H. Meyer
Signature

July 14, 2010
Date

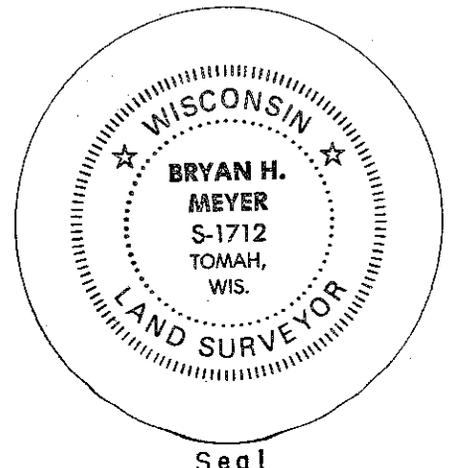


Seal

U. S. PUBLIC LAND SURVEY MONUMENT RECORD

SECTION 17 T 15 N, R 5 W, TOWN OF WASHINGTON

LA CROSSE COUNTY

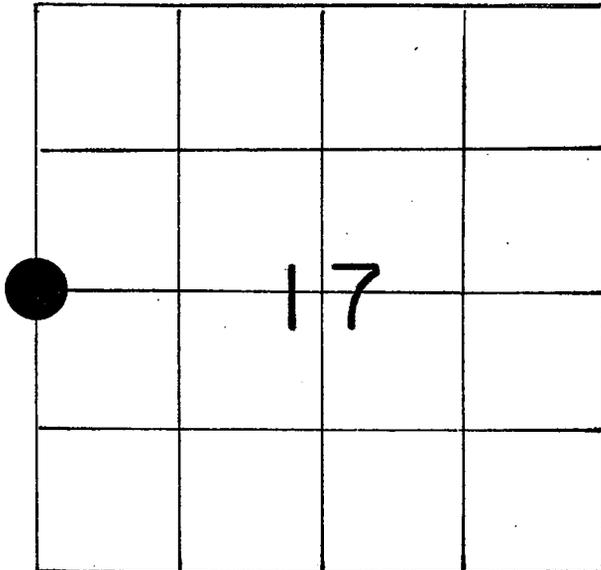

LOCATION OF LANDMARK

Crew: WILLIAM C. JUNG
PETER F. FOLLANSBEE

Date: 9/28/1990

Describe any record evidence, monument evidence, testimonial evidence or any other material evidence you considered and whether the monument was found or restored through acceptance of an obliterated evidence location.

Crook found an iron pipe at the occupied corner. It may have been put in by Connell in 1977. Crook and I agreed that this corner should be accepted as the best available evidence of the original government corner position. I removed the existing pipe and replaced it with a Lunde marker. I also buried a bottle with an empty shell casing on the Southwest side of the Lunde. I set a sign on the new wood post to the Northeast. The new post replaced an "ancient" post and the new fences replaced old fences.

Describe or show any material discrepancy between the location of the restored corner and that of the corner previously restored or reestablished.

NONE KNOWN

WISCONSIN COORDINATE SYSTEM

North

East

Theta Angle

Horiz. Order

Vert. Order

TYPE OF LANDMARK

Brass cap Lunde marker

BEARINGS ARE REFERENCED TO


Assumed

RECORD OF DURABLE WITNESS MONUMENTS
MAGNETIC

NO	DESCRIPTION	BEARING	DISTANCE
1	Exist. Spike in SW-side 15" W. Oak	N 27° E	57.99 Ft.
2	Exist. Spike in SW-side 16" W. Oak	N 66° E	37.28 Ft.
3	Set P.K. Nail in N-side 12" W. Oak	N 81° E	73.01 Ft.
4	Exist. 1" Iron Pipe -(survey point only)	S 7° E±	41.52 Ft.

(Note: all bearing trees are single blazed white Oaks)

W1/4-COR., SEC. 17-15-5.
REPLACED 1 1/4" IRON PIPE WITH BRASS CAP LUNDE MARKER. BURIED BOTTLE WITH BLANK BULLET INSIDE ON THE SOUTHWEST SIDE OF THE LUNDE. SET SIGN ON NEW WOOD POST TO THE NORTHEAST OF THE LUNDE. THE NEW POST REPLACED AN "ANCIENT" POST; NEW FENCES REPLACE OLD FENCES.

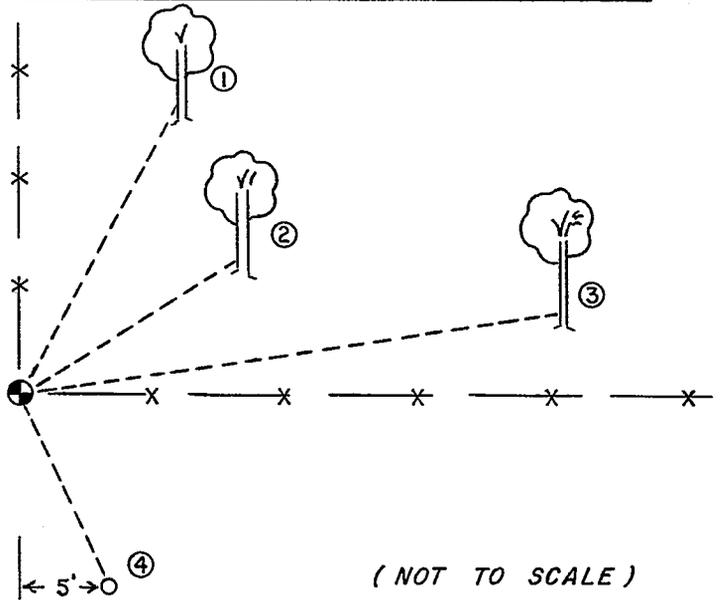


(NOT TO SCALE)

PLAN VIEW DRAWING OF REFERENCE TIES

MAP SHOWING DISTANCE AND DIRECTION TO OTHER PUBLIC LAND SURVEY CORNERS USED FOR REESTABLISHING THE CORNER

(not to scale)

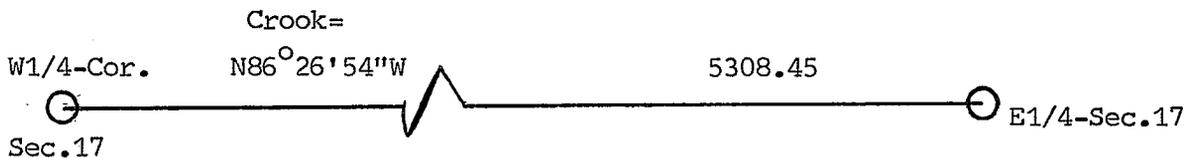

I, William C. Jung, Deputy County Surveyor
HEREBY CERTIFY THAT THE CORNER LOCATION SHOWN ON THIS RECORD WAS DETERMINED BY ME OR UNDER MY DIRECTION AND CONTROL AND THAT THIS U. S. PUBLIC LAND SURVEY MONUMENT RECORD IS CORRECT AND COMPLETE TO THE BEST OF MY KNOWLEDGE AND BELIEF.

William C. Jung
Signature

January 11, 1991
Date



Seal