


21505190000

## U. S. PUBLIC LAND SURVEY MONUMENT RECORD

SECTION 19 T 15 N, R 5 W, TOWN OF WASHINGTON

LA CROSSE COUNTY

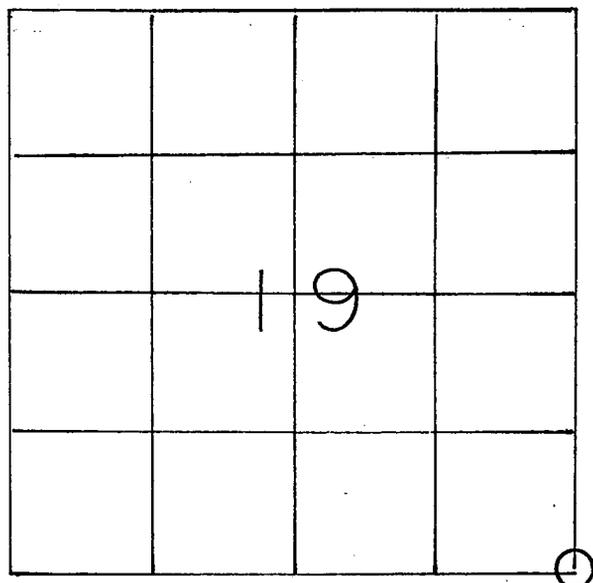

LOCATION OF LANDMARK

Crew: WILLIAM C. JUNG  
 PETER F. FOLLANSBEE  
 Date: 9/10/1996

## WISCONSIN COORDINATE SYSTEM

North

East

Theta Angle

Horiz. Order

Vert. Order

## TYPE OF LANDMARK

Set 1" x 30" Iron Pipe.

## BEARINGS ARE REFERENCED TO

True North

Describe any record evidence, monument evidence, testimonial evidence or any other material evidence you considered and whether the monument was found or restored through acceptance of an obliterated evidence location.

I set the corner at a computed location that best fits the existing field evidence, both occupation and proportion. An iron pipe was set at the corner.

Describe or show any material discrepancy between the location of the restored corner and that of the corner previously restored or reestablished.

None known.

